
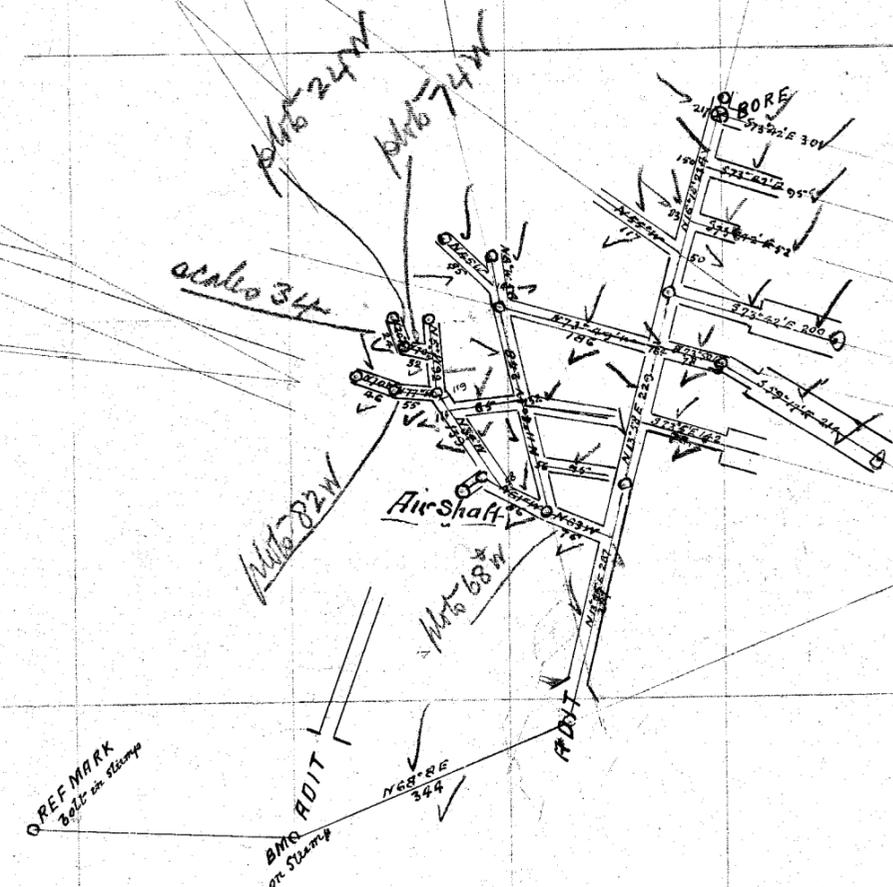


Adapted from

186-05

186-05

PC

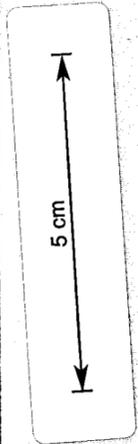

— 6 FOOT SEAM WORKINGS —
 — M^r NICHOLAS COLLIERY —

— TO JANUARY 1900 —

— SCALE 2 CHAINS TO 1 INCH —

Wm. J. Burrows
Mining Survey
8/2/1900

Headfile and
W. J. B.

PC