


Chief Inspector Mines


186-06

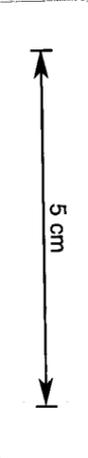

NORTH EAST WORKINGS M^r. NICHOLAS COLLIERY

TO JANY 1900

SCALE 2 CHAINS TO 1 INCH

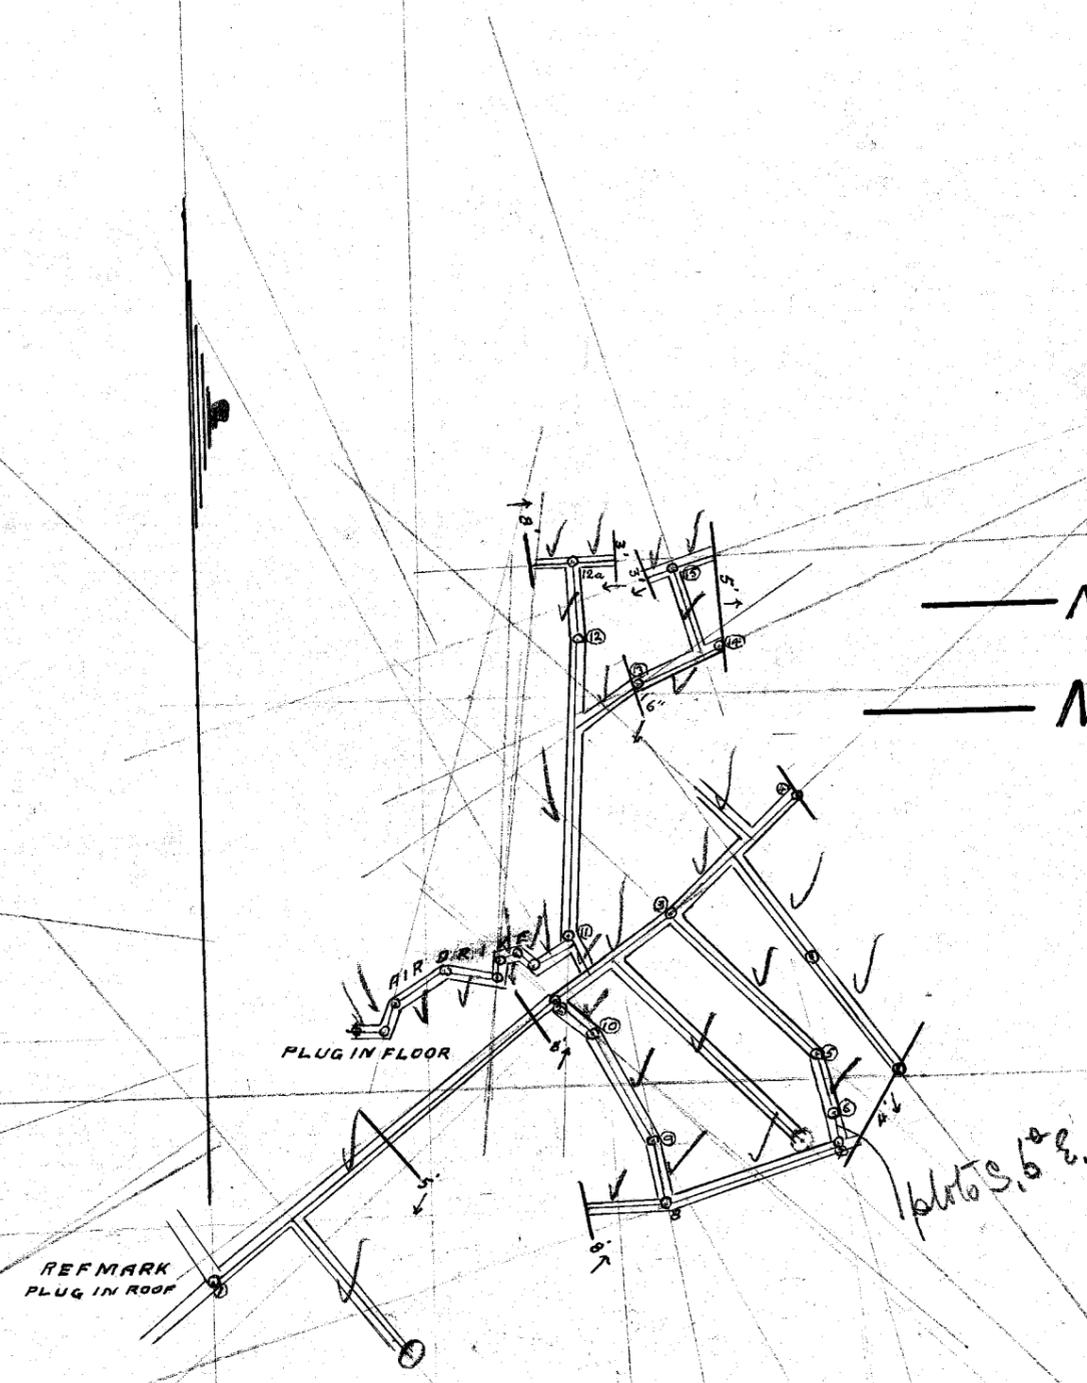

photo's, 6 & 8.

Examined

W.L. Burrows
Mining Survey
8/3/1900
theodolite and
W.L.V.

186-06

20