



186-07

Dept. of Mines

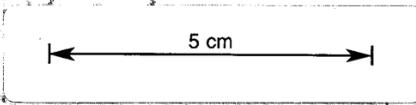

186-07

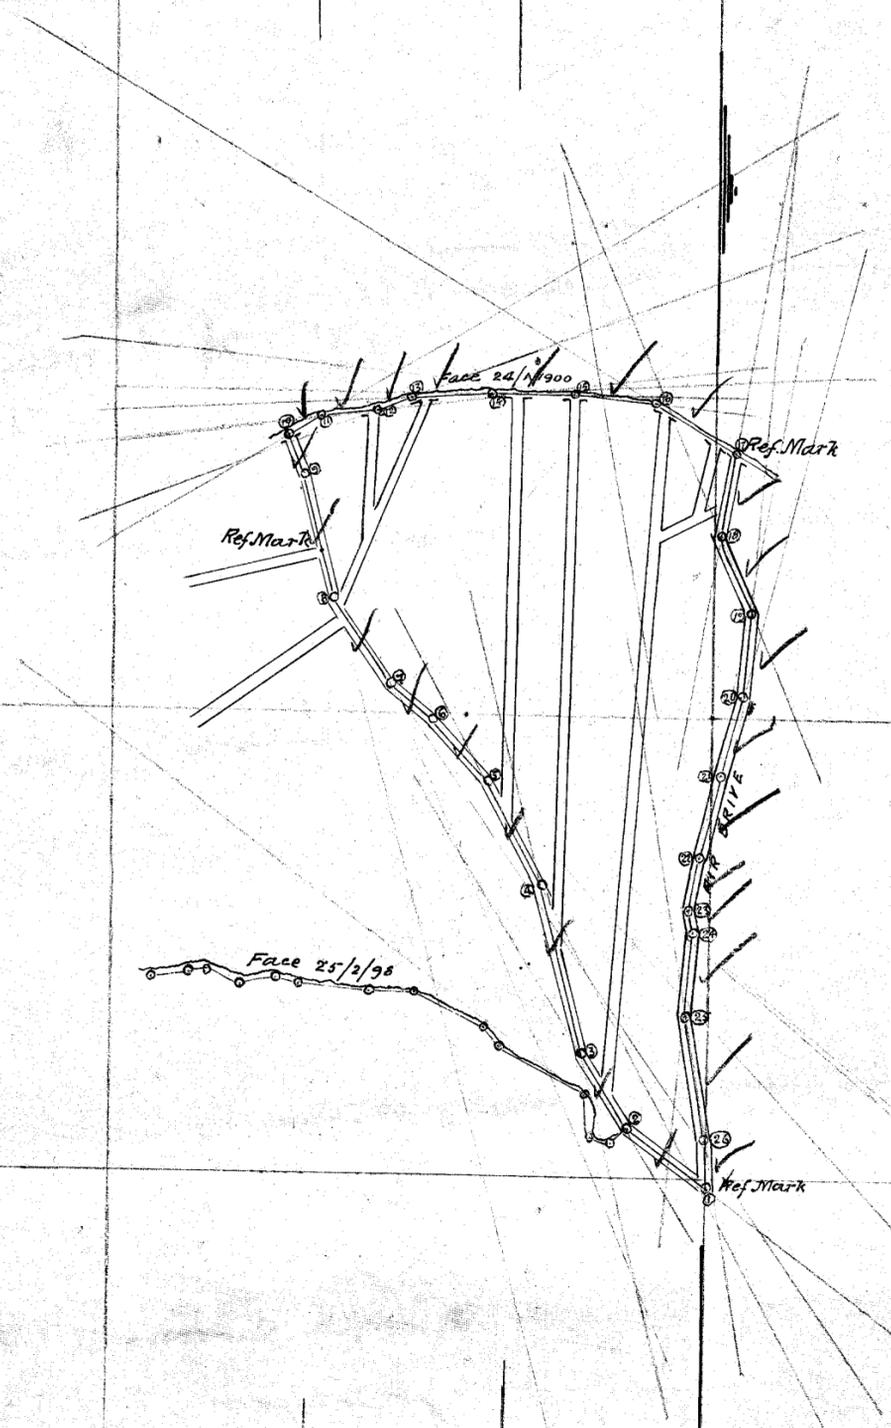

NORTH WEST WORKINGS
M^r NICHOLAS COLLIERY

TO JANY 1900
SCALE 2 CHAINS TO INCH

W. L. Burrows
Mining Surveyor
7/3/1900

Theodolite used
W. L. B.

62°

copy found
1/11/1900

20