


2117 320 AC

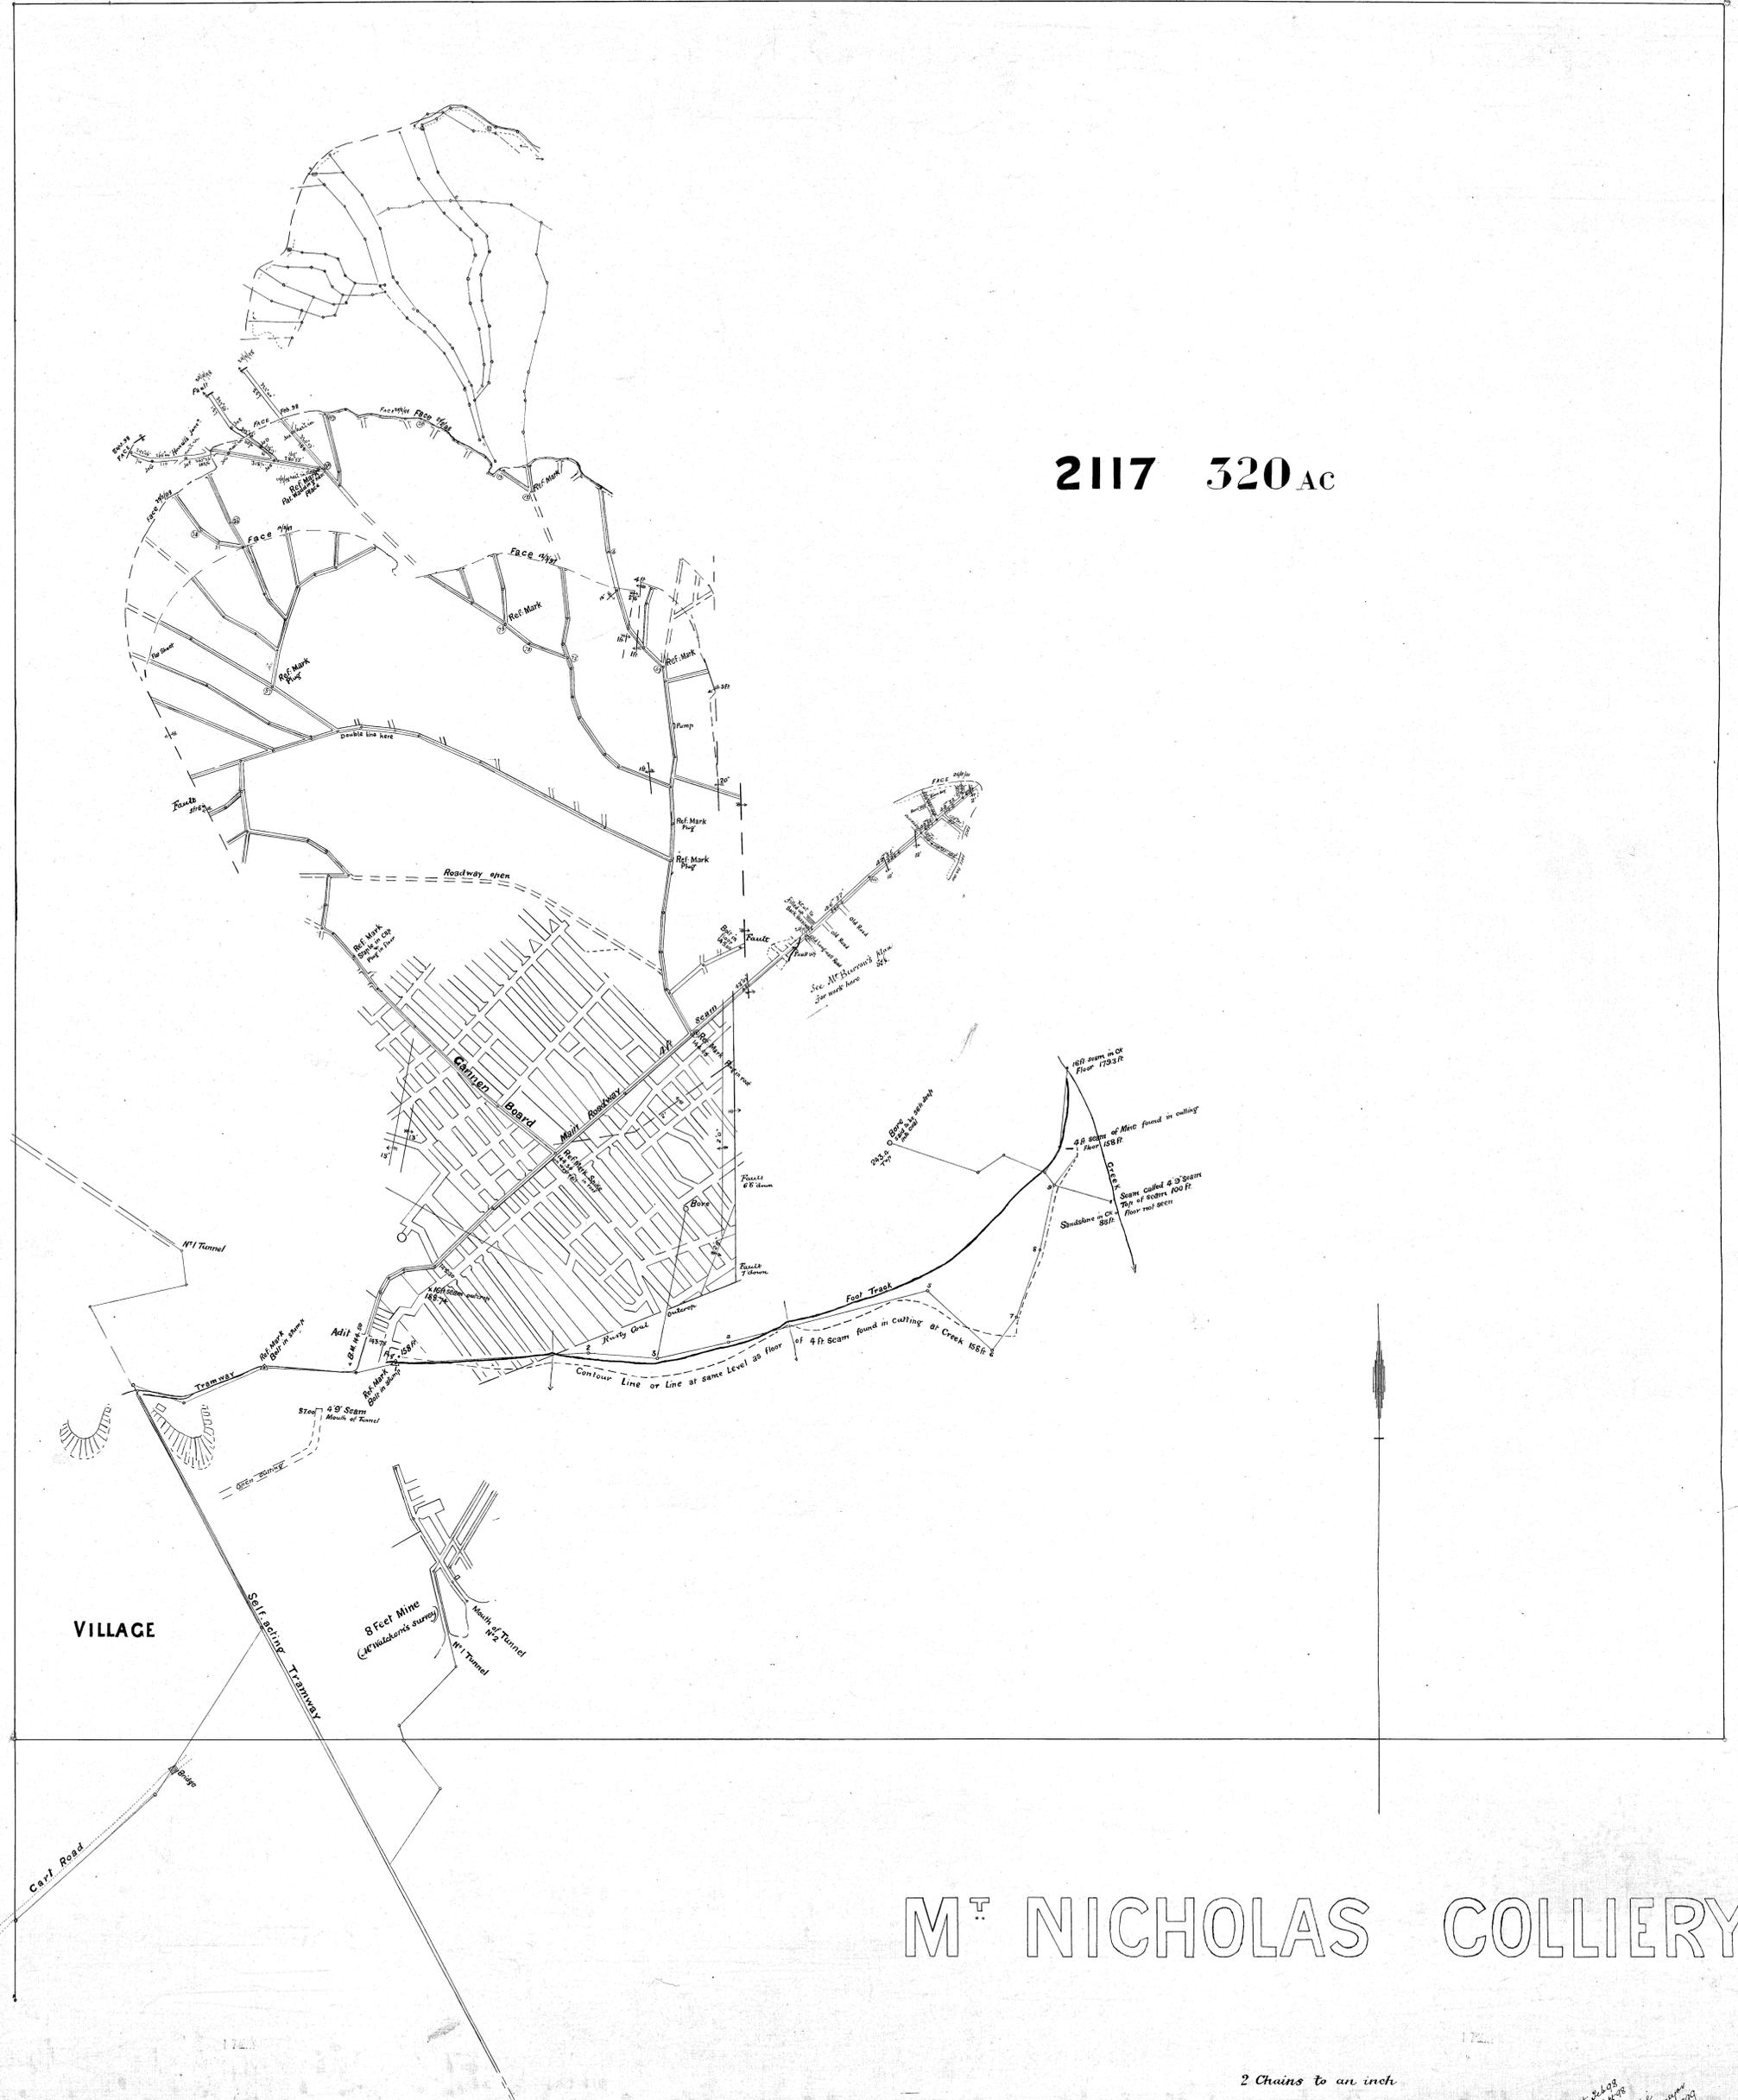

M^T NICHOLAS COLLIERY

2 Chains to an inch

The portion worked out shown by red lines is from a survey by M^r Watchorn

Figures in blue denote heights above a common Datum

Survey in field to 24.08
 finished drawing 25-28-78
 Collier & Co.
 Newcastle N.S.W. 15th May 1879