

5 cm


186-10

M^t Nicholas Colliery

TO FEBRUARY 1903

Scale 2 chains to an inch
4ft Seam

Frank K. Pitt
Mining Surveyor
14/2/03

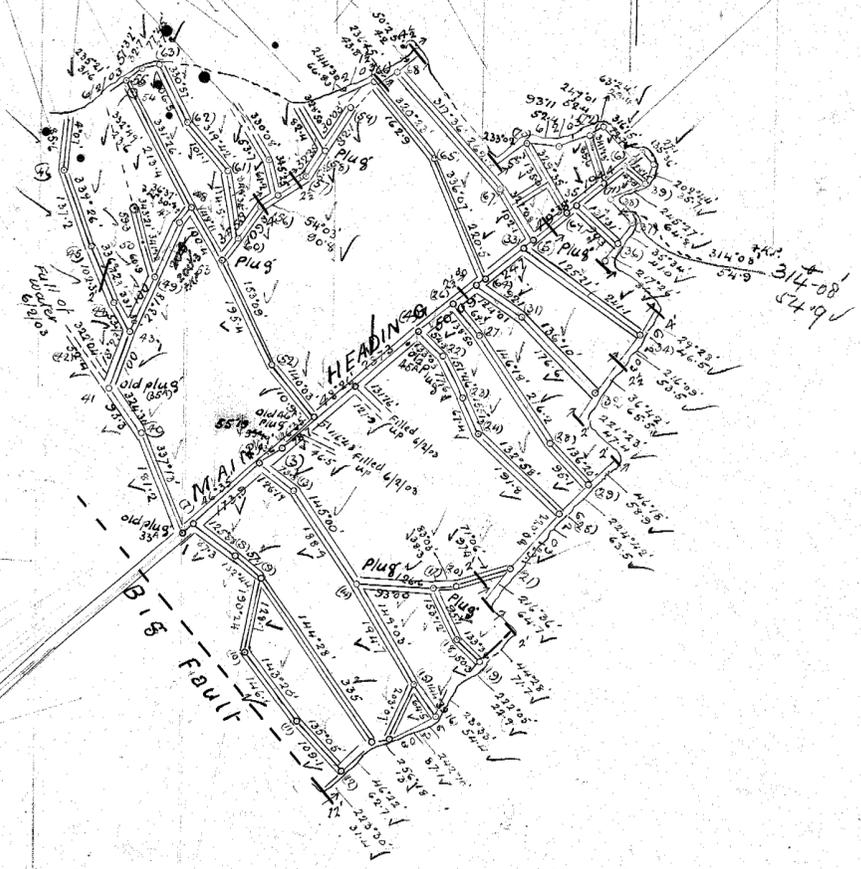

Vertical text on the right margin, possibly a reference or file number.