

M. NICHOLAS COLLIERY.

Scale 2 chs. to 1 inch.

Work done during 1906.
Surveyed with theodolite
C. Bingle Watchorn
Govt. Surveyor



Good work done in 1906

186-11

8 cm

186-11

Self Acting Tramway

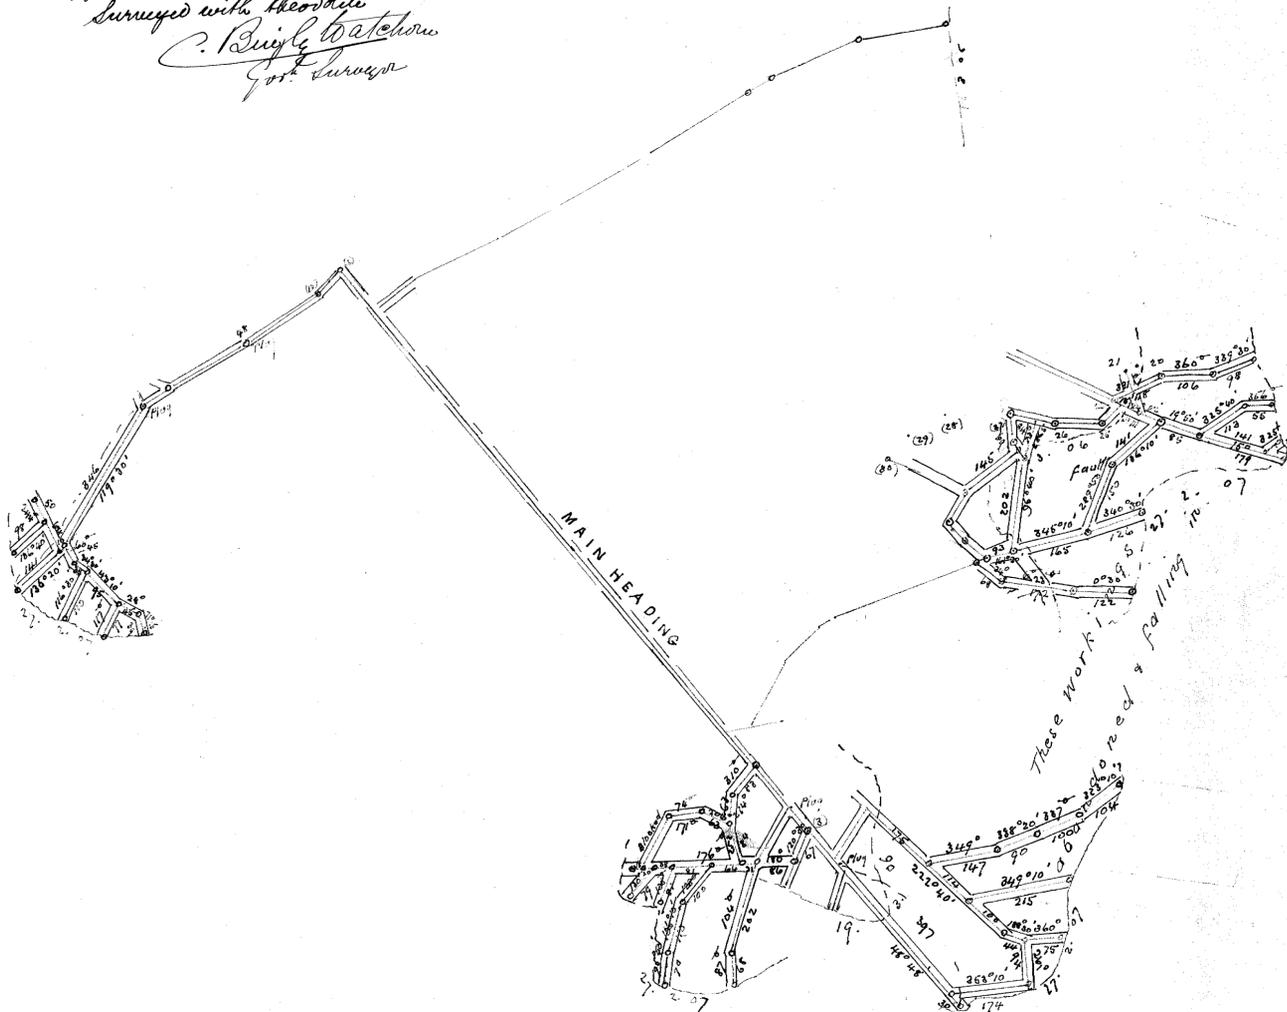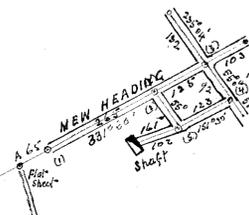

GOVERNMENT GEOLOGICAL SURVEY
22 MAR 1907
LAUNCESTON

360