


M^r NICHOLAS COLLIERY

Scale 2 chs. to 1 inch

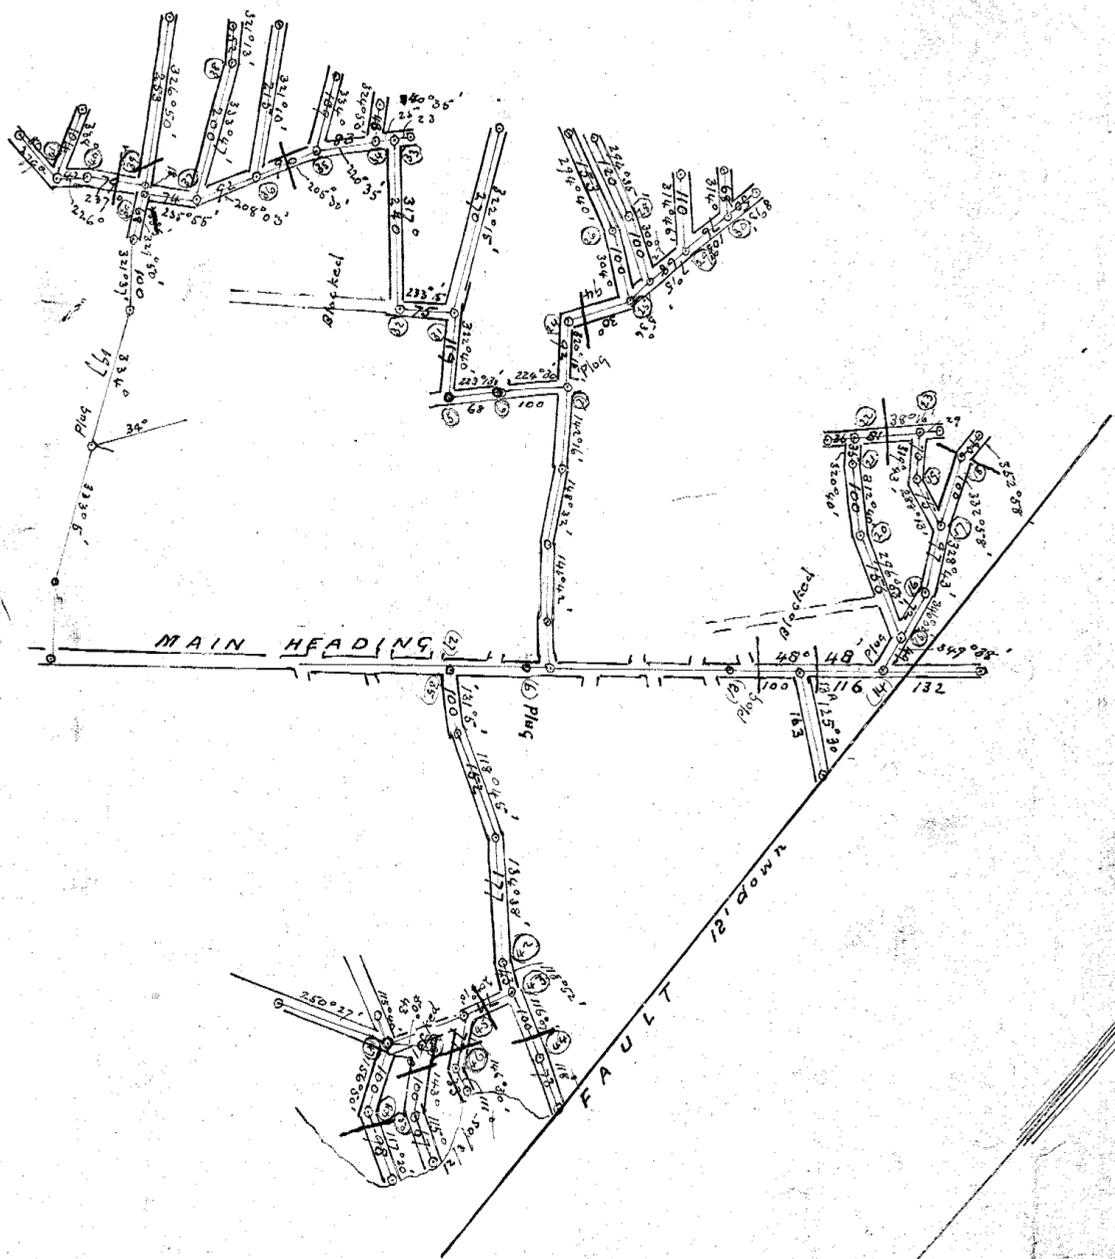

Full of water
Approximate

Surveyed March 11+12th 05
 C. Riegly Watchman
 Geo. Lurveyor