

MT NICHOLAS COLLIERY

Scale 2 chs. to 1 inch

Certified correct copy of work
done during year 1907
Surveyed with theodolite where
practicable otherwise with
pneumatic compass.

C. Bingley & Co. Surveyors
21. 1. 08






Lot
2117

186-15

5 cm

186-15

SE 1

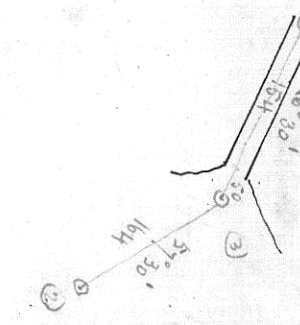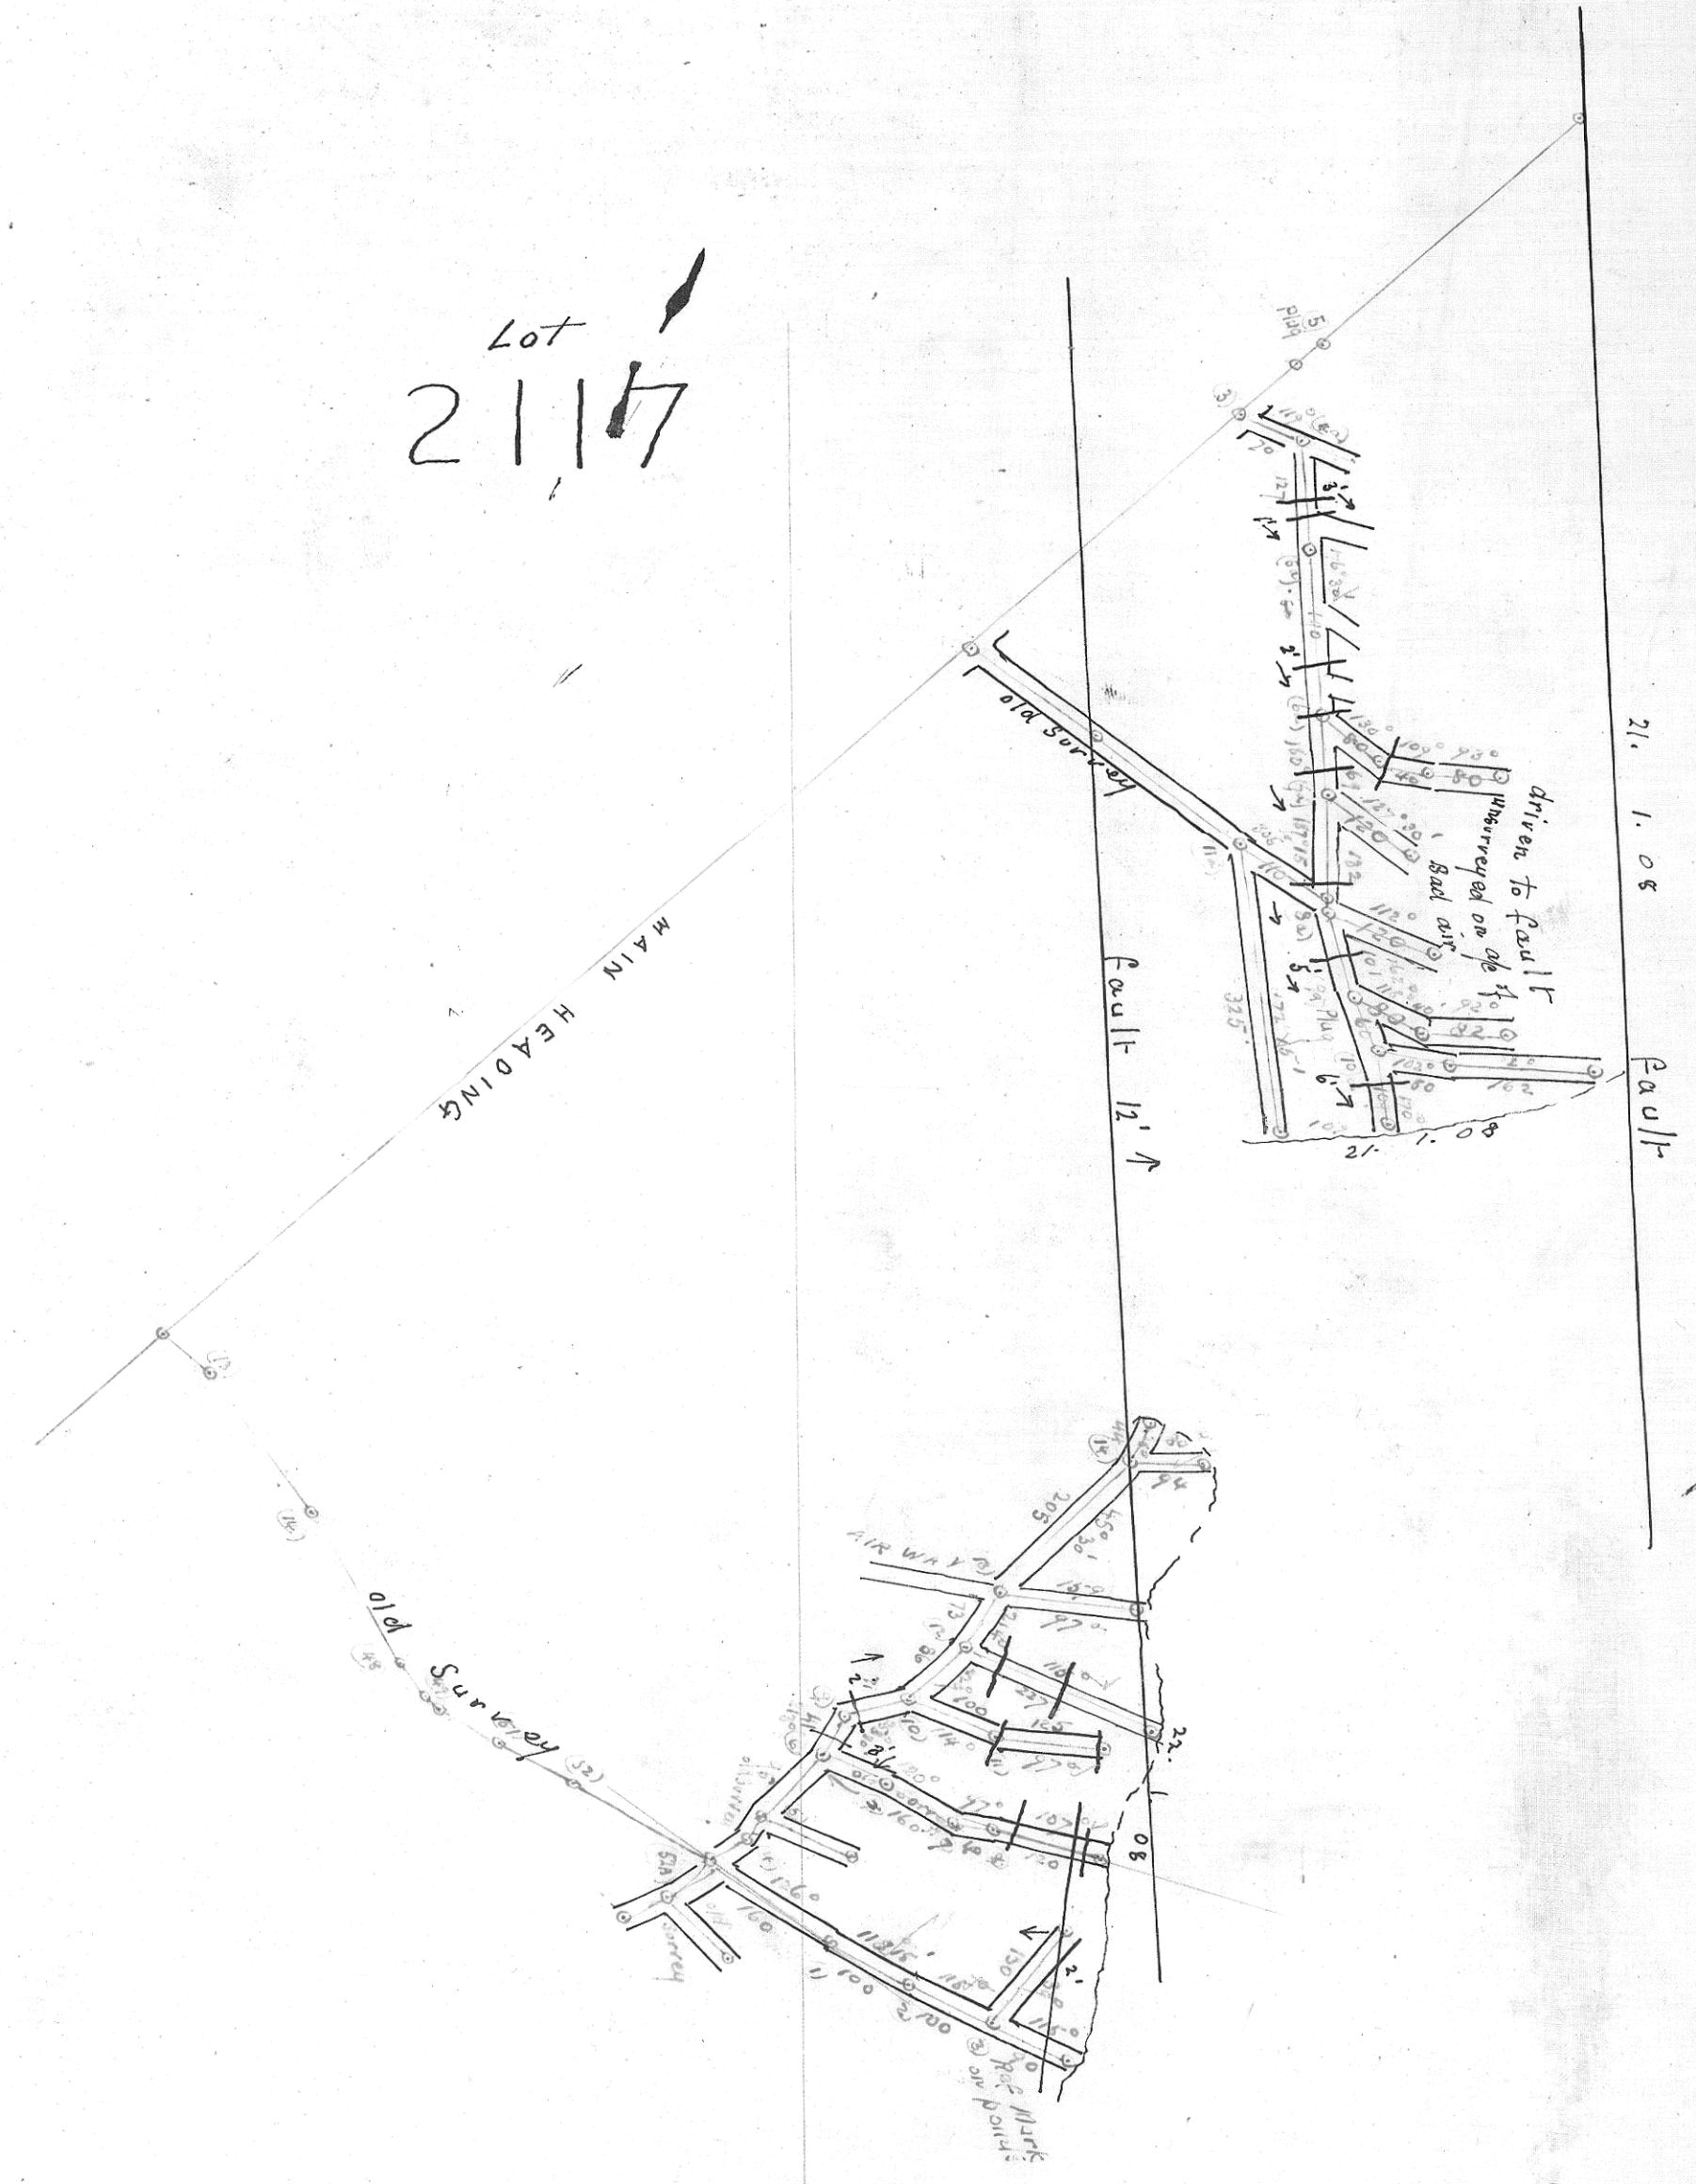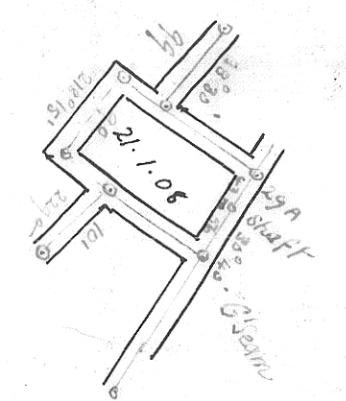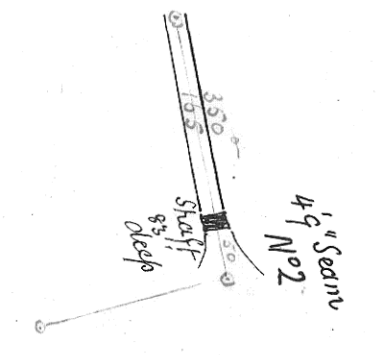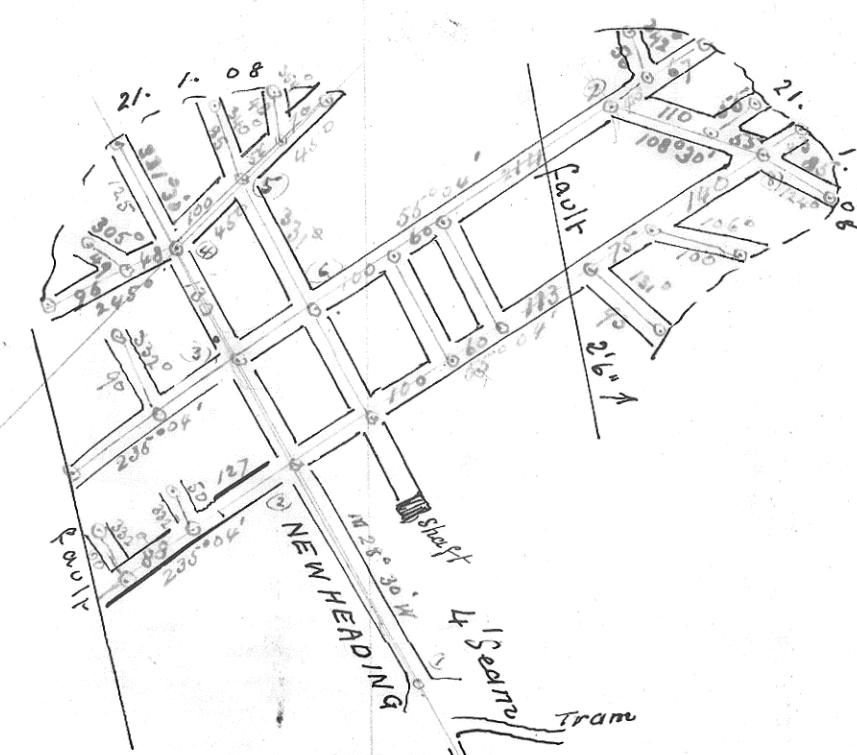

10011