


# M<sup>r</sup> NICHOLAS COLLIERY

Scale 40ft. to 1 inch.

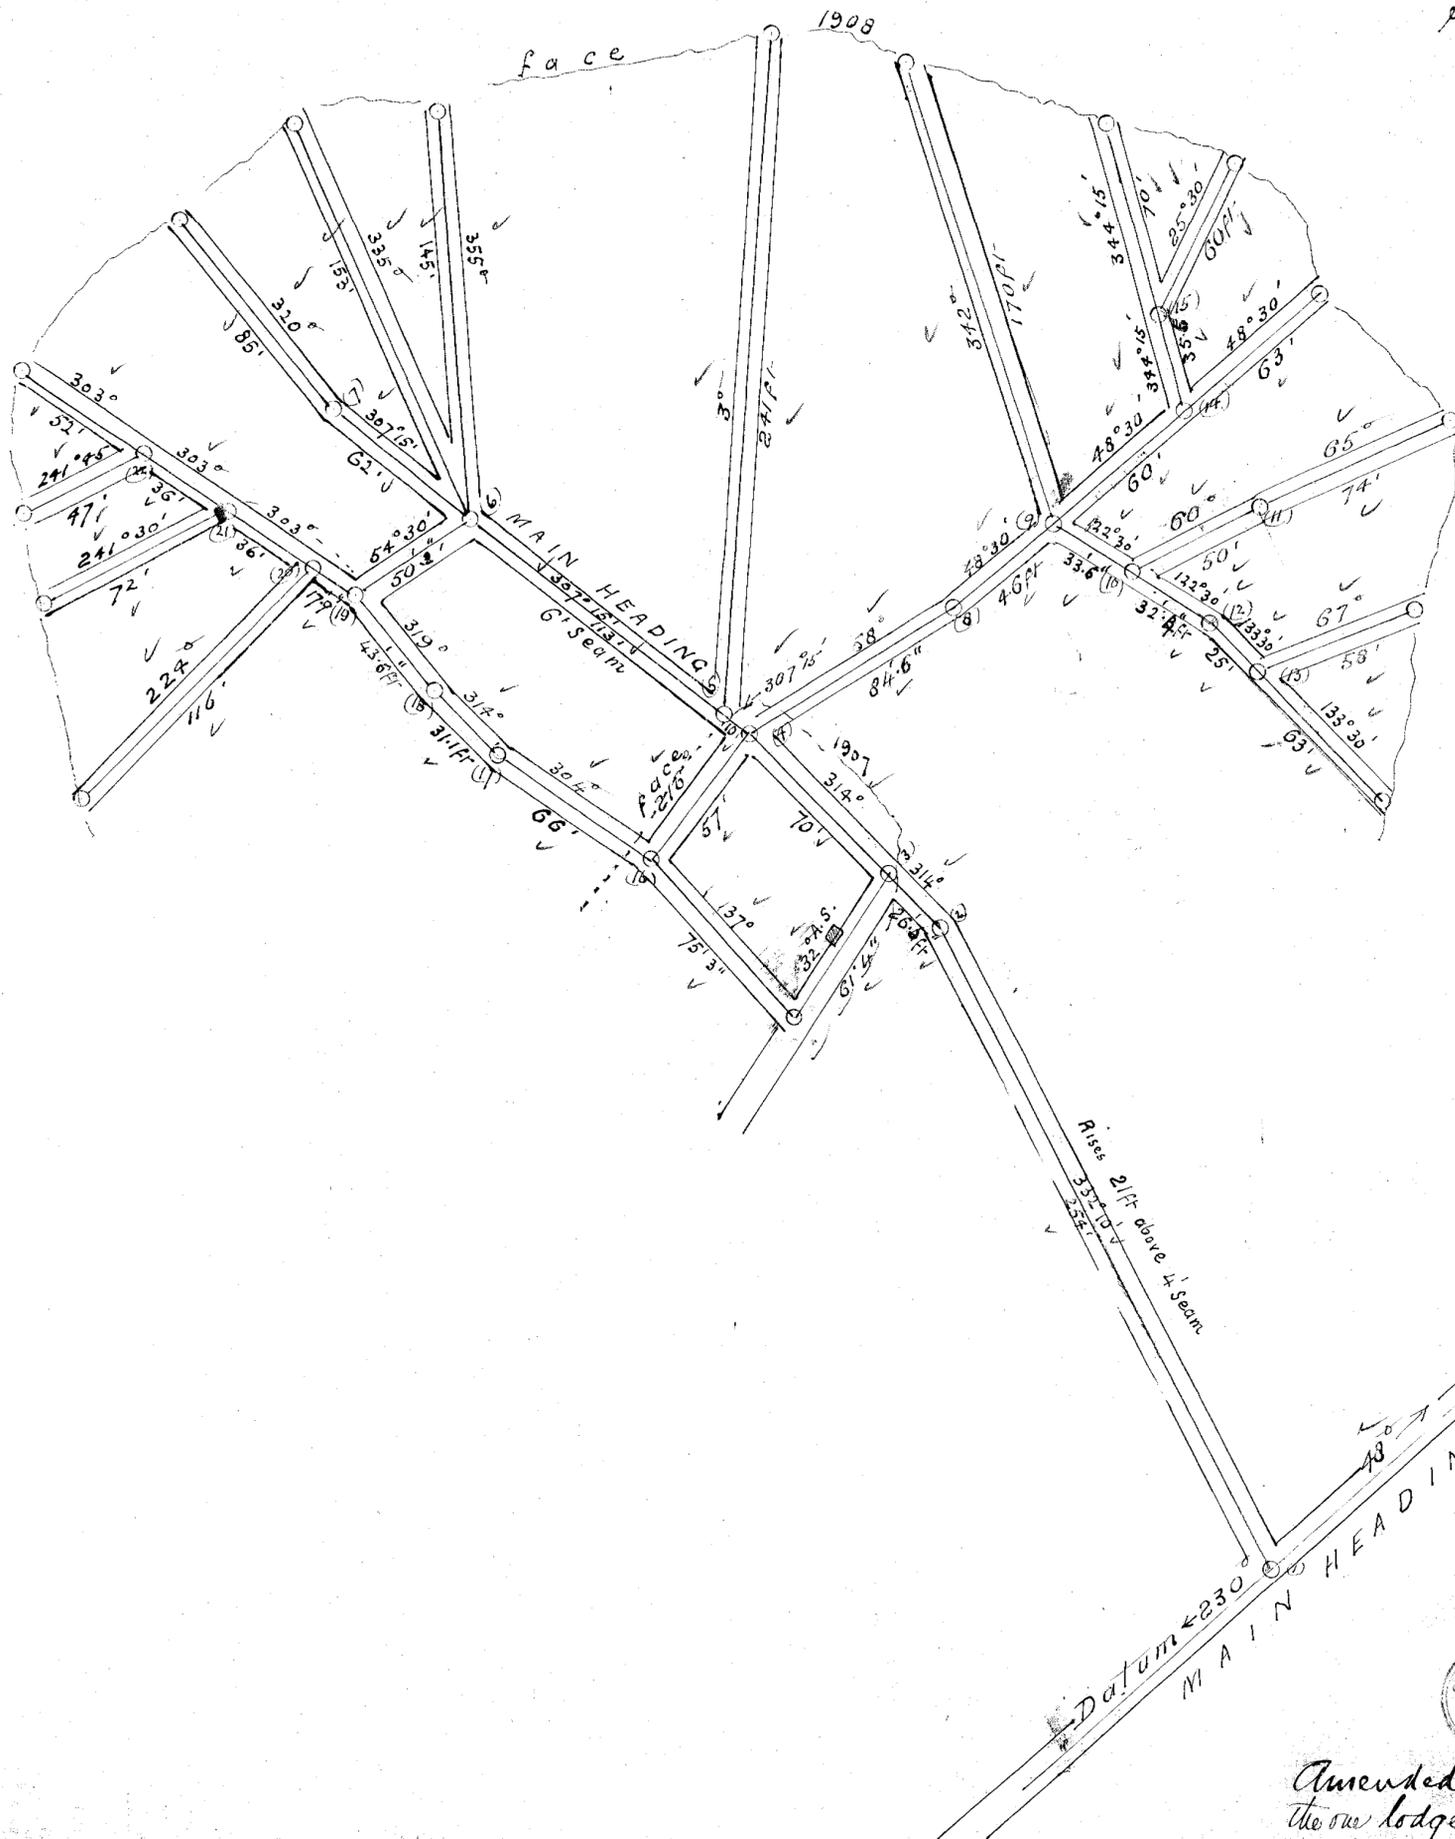

see opposite p. 117  
p. 100

see opposite p. 117

186-16

5 cm

186-16



Amended plan replacing  
the one lodged 8 July/09  
W.G. Watson (Correct)  
W.G.

Survey of work done during  
year 1908 Survey of W.H. + B.H.  
with theodolite. The rest with  
prismatic Compass as it was  
impossible to use theodolite  
in other drives as there was no room  
C. Peirce Watson  
C. Peirce Watson