

186-20

5 cm

MOUNT NICHOLAS COLLIERY

PLAN


SHOWING EXTENSIONS OF WORKINGS FOR YEAR 1912

Scale = 2 chains to one inch.

Instrument used - Six transit theodolite

Wm Ledges

2117    320 ac

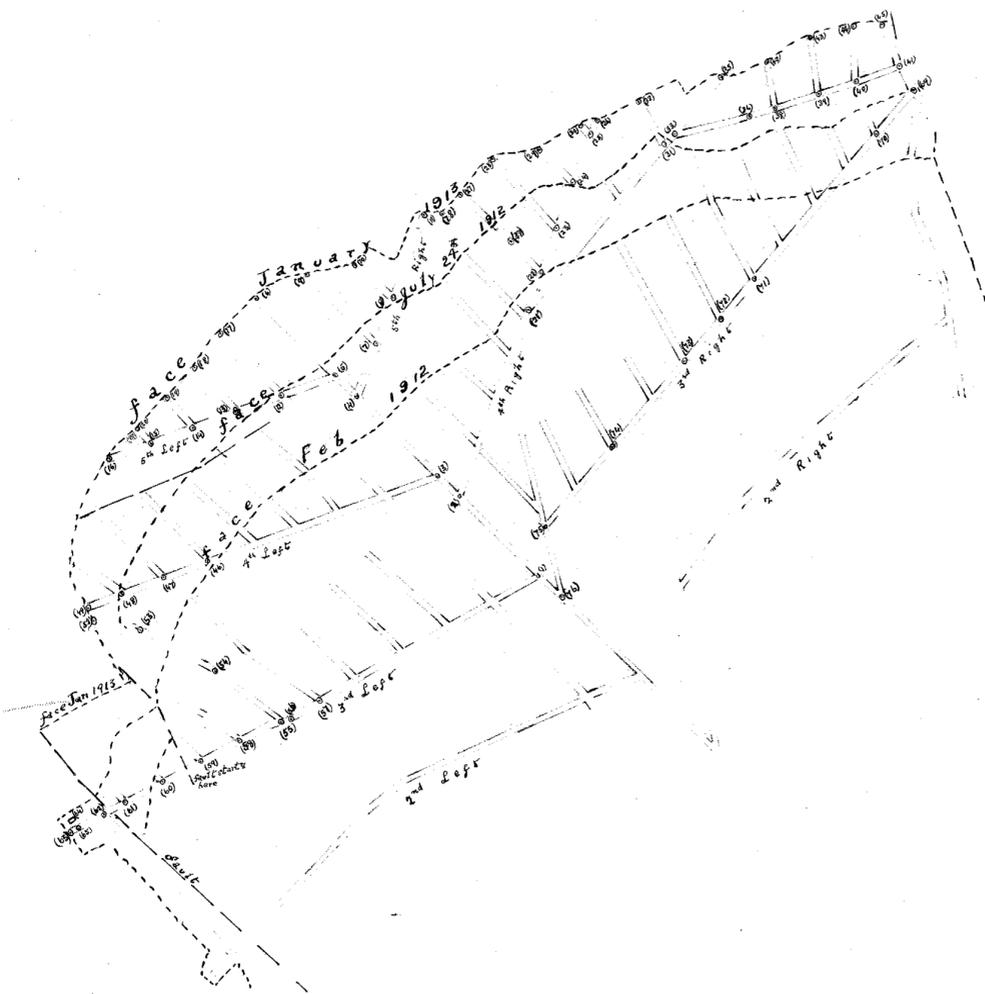

N

S