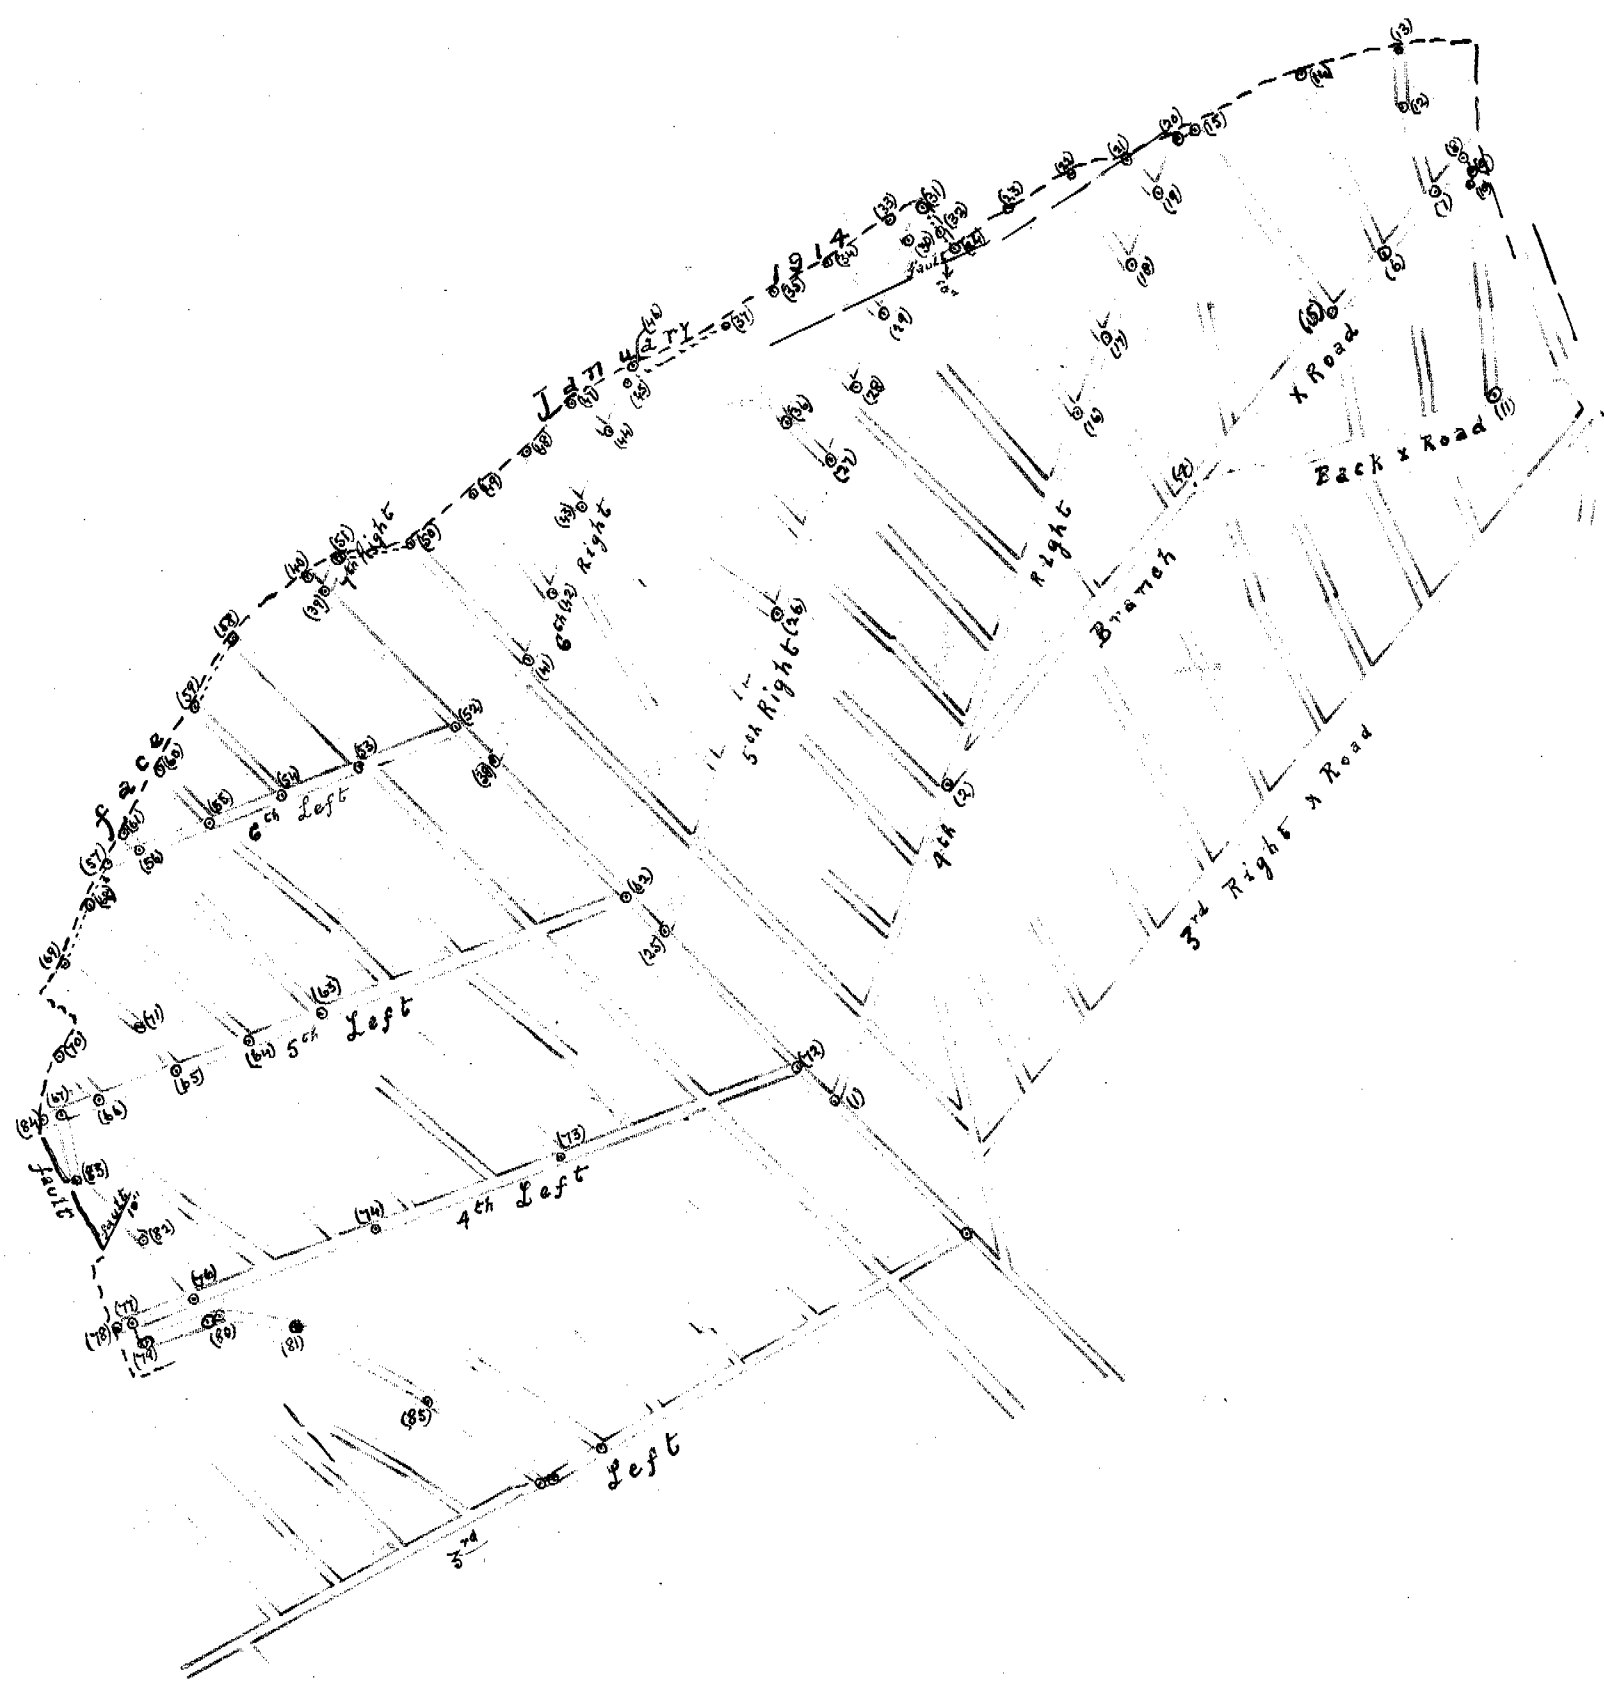


186-21

5 cm

MOUNT NICHOLAS COLLIERYExtension of Workings for Year 1913Scale = 2 chains to one inchW. S. Sledge

S
 Surveyed January 8, 14, 17, 24, 1914
 Johnston and Handley, Genl.
 W. S. Sledge