


5 cm

186-23

1d/1
2c
MOUNT NICHOLAS COLLIERY

Lease N° 1190M

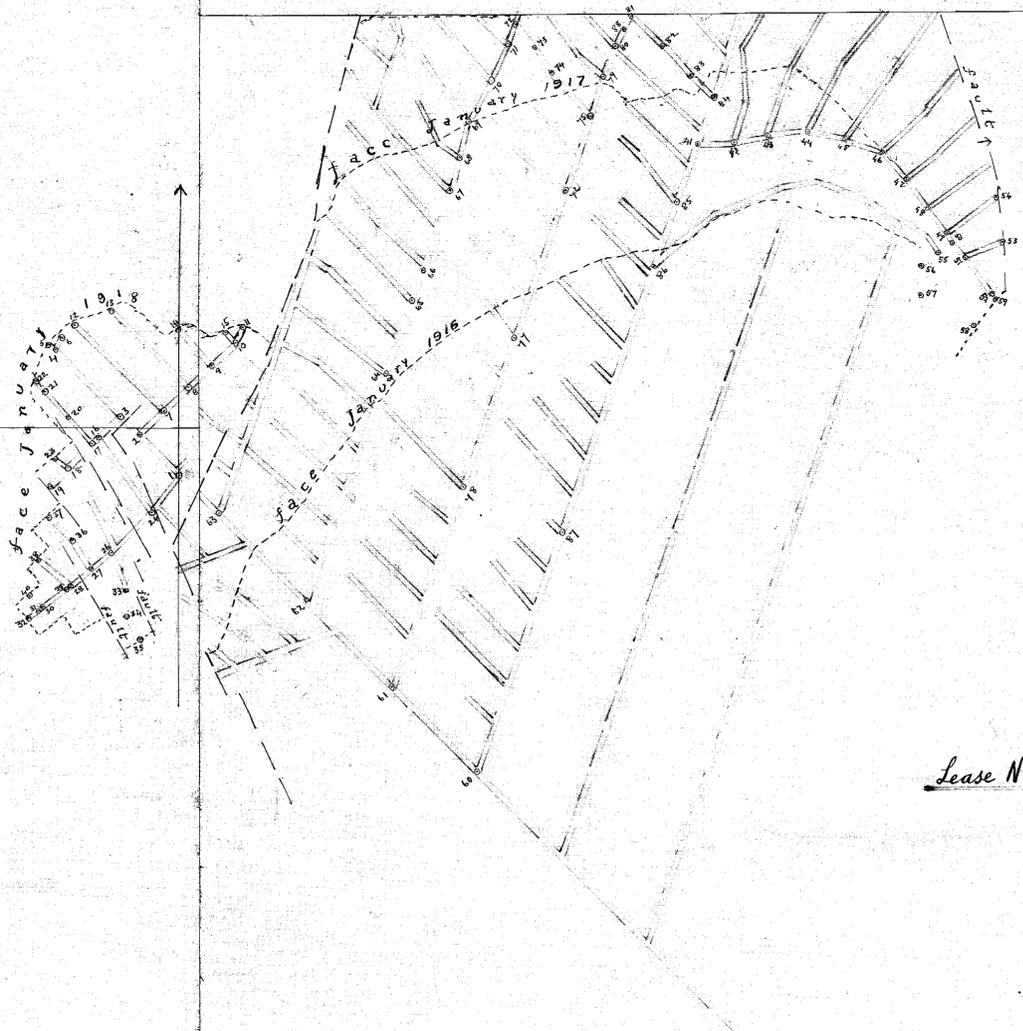

Lease N° 2116

Lease N° 2117

MOUNT NICHOLAS COLLIERY

Tracing of Extension of workings for
Year 1917.

Scale = 2 chains to one inch.

NOTE

Workings in Red Ink are in 6 foot seam

" " " " " 4 foot "

