


5 cm

186-24

CORNWALL COAL COMPANY

Lease N° 5688 M

Lease N° 1190 M

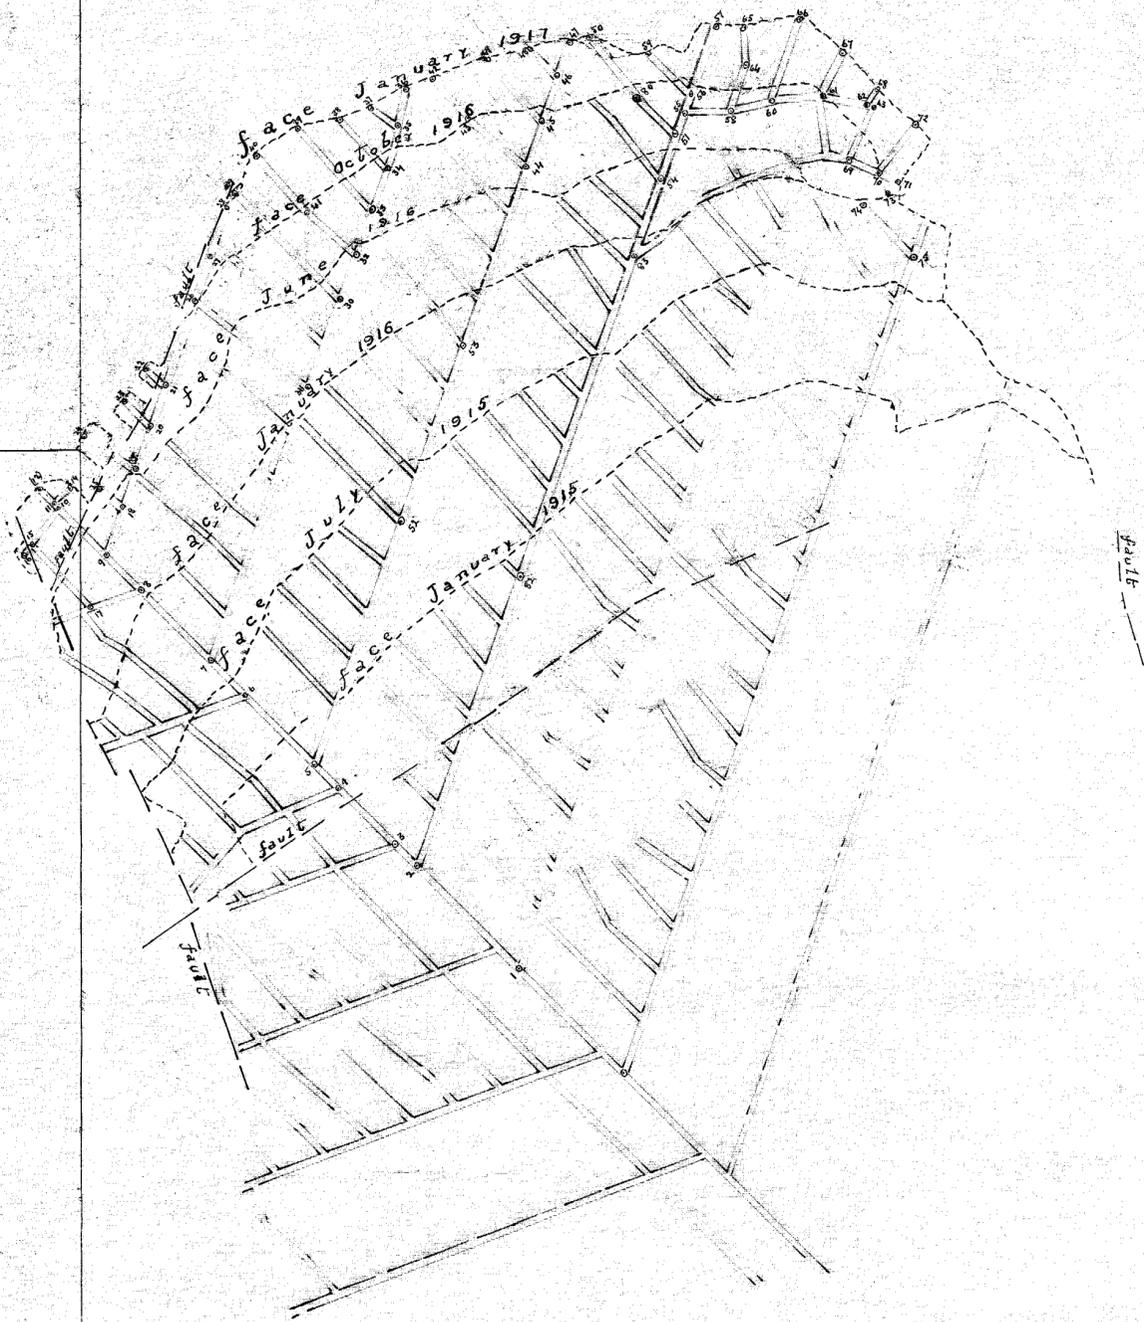

Lease N° 2116

Lease N° 2117

MOUNT NICHOLAS COLLIERY

Plan Showing Extension of Workings

For Year 1916

Wm Ledger

1012
Wm Ledger Colliery

u/n



u/n