


5 cm

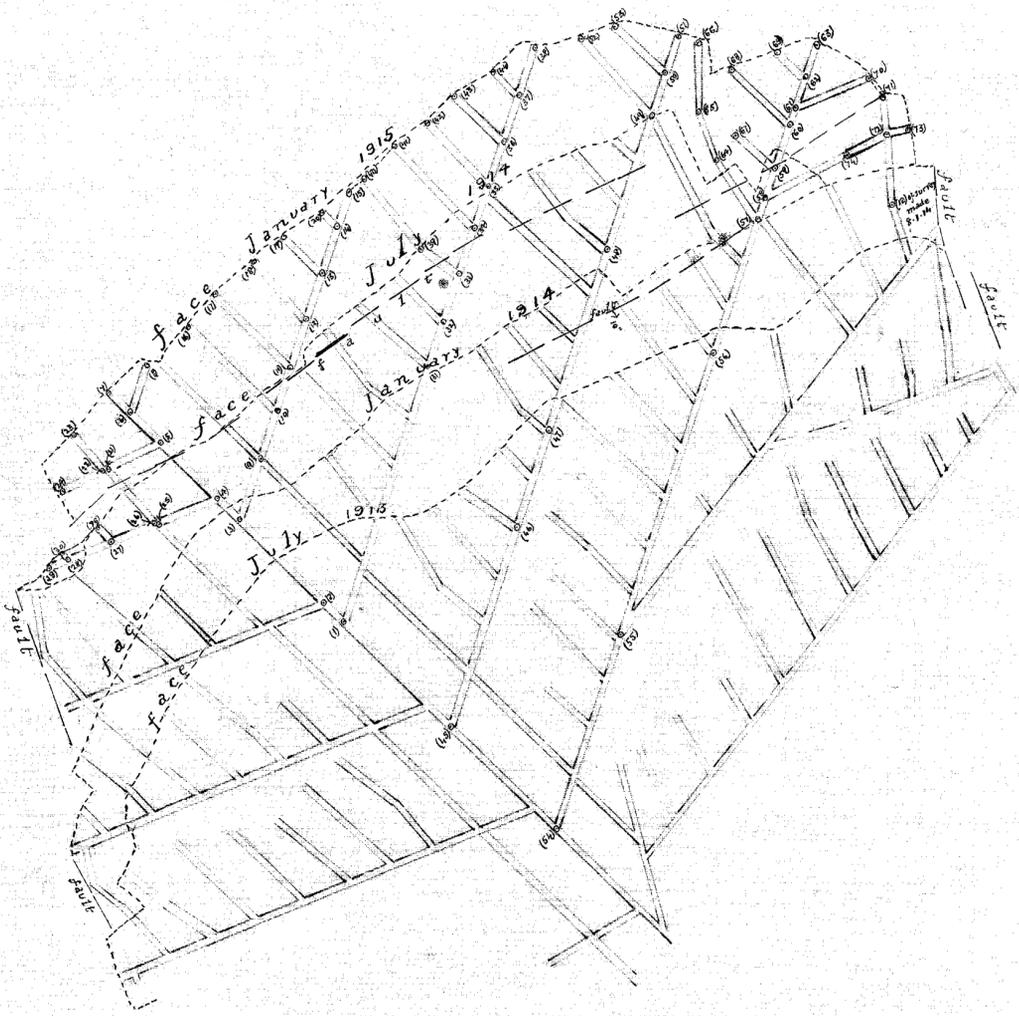

Lease N° 2117

320 AC.

MOUNT NICHOLAS COLLIERY.

EXTENSION OF WORKINGS FOR YEAR 1914.

Scale = 2 chains to one inch.

Wm Ledges

Mr. Nicholas Colliery
Exp. 1914

201