


186-26

MOUNT NICHOLAS COAL COY LTD

CORNWALL COAL COY N.L


6663
M
319 AC

5688
M

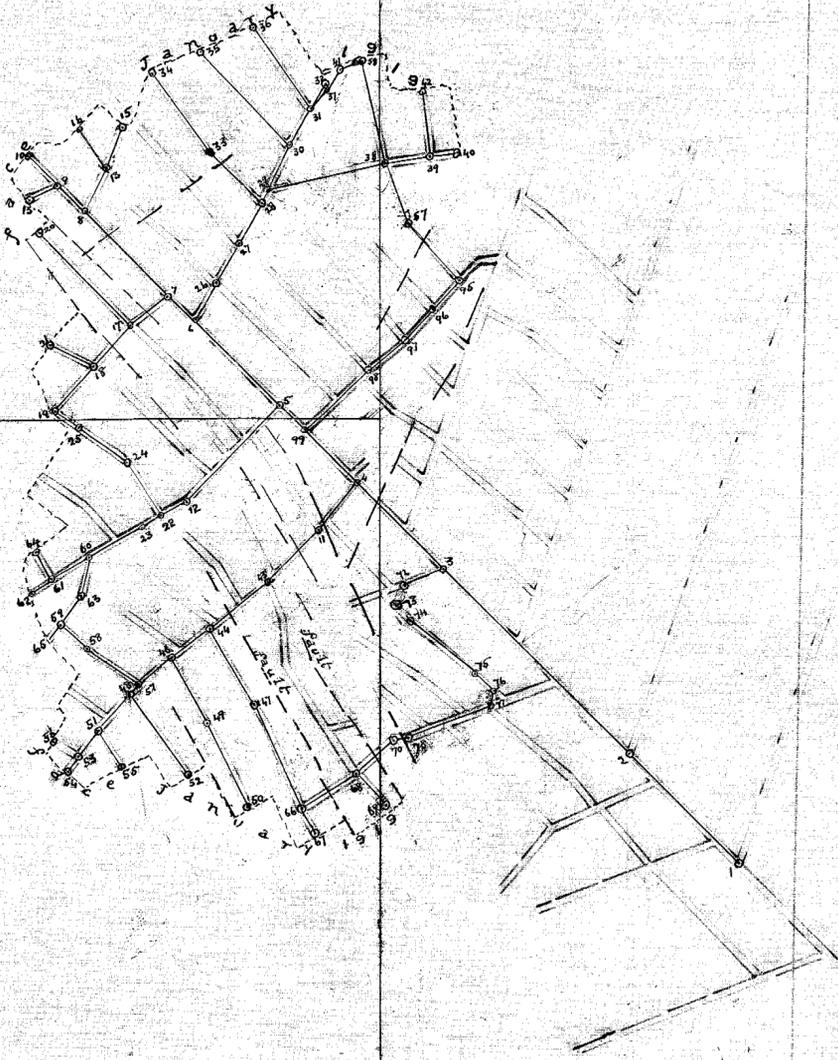

LEASE N° 2116

LEASE N° 2117

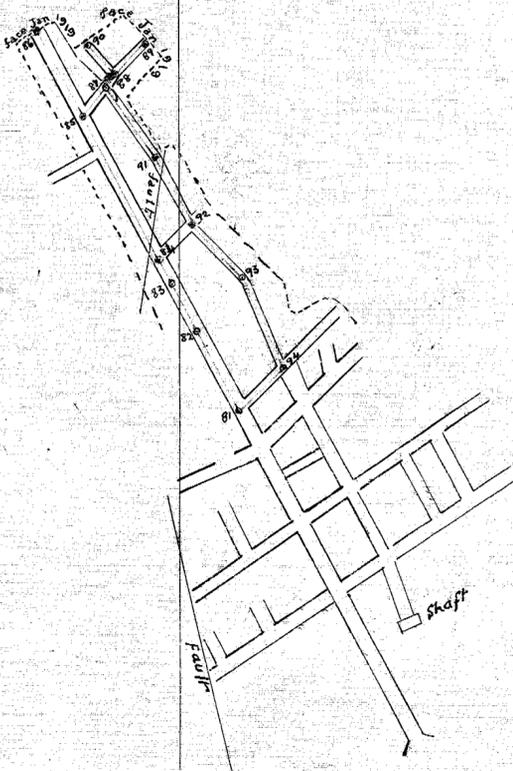

MOUNT NICHOLAS COLLIERY
Plan showing extension of workings
for Year 1918
Scale = 2 chains to One Inch

Wm Ledger
Dec 30. 1918, Jan 2. 4. 18. 1919