

5 cm

186-27

MOUNT NICHOLAS COLLIERY


Extension of colliery workings for Year 1921

Scale = 2 chains to one inch

W. 1168 9500
Exd Referred to C.J.M.
24-3-22

Lease 6063
M

Cornwall Coal Coy N.L.

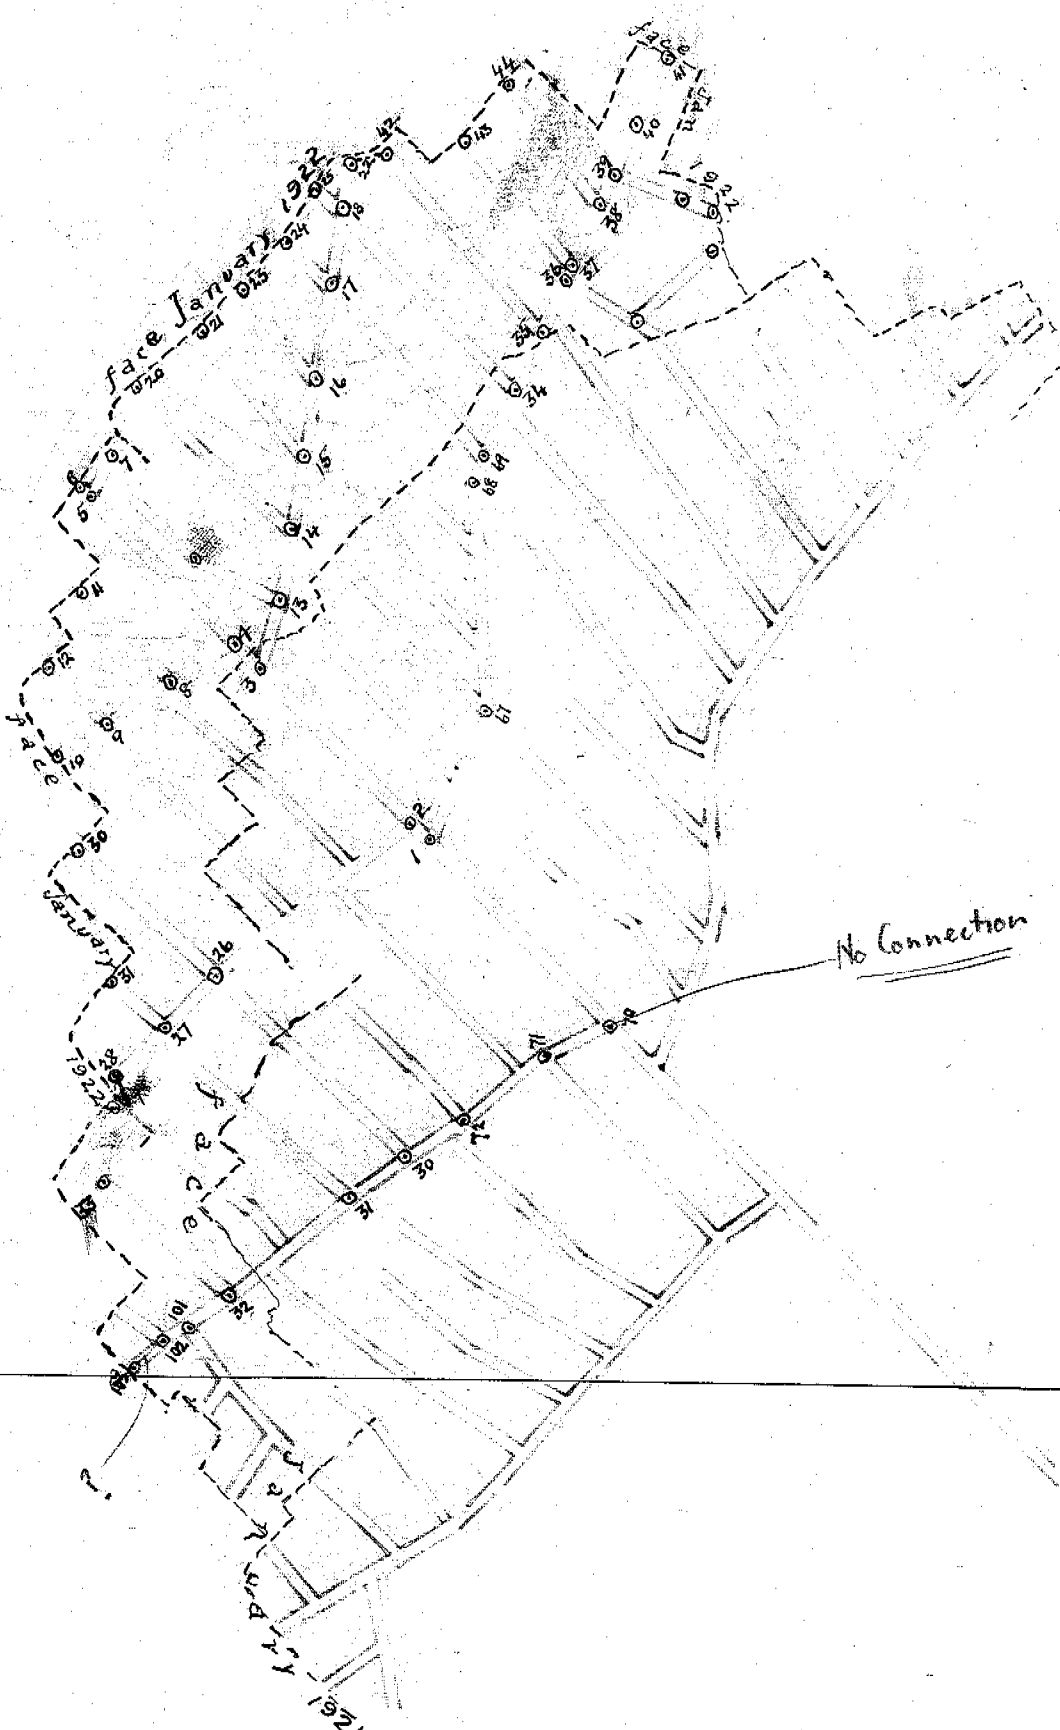

Lease 2116

Lease 2117

