


5 cm

186-29

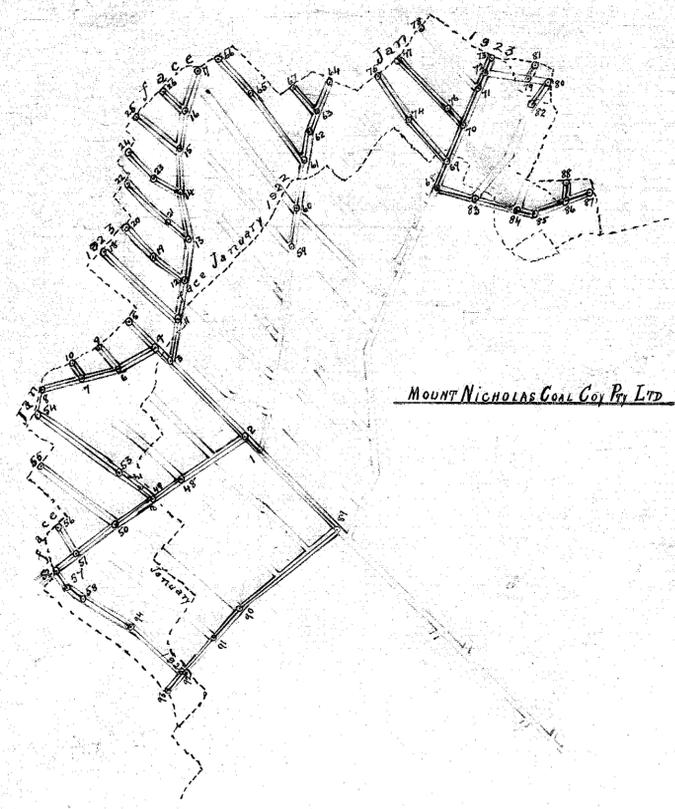


CORNWALL COAL COY
NO. LIA
M. L.

MOUNT NICHOLAS COAL COY. LTD.

MOUNT NICHOLAS COAL COY. LTD.

MOUNT NICHOLAS COAL COY. LTD.

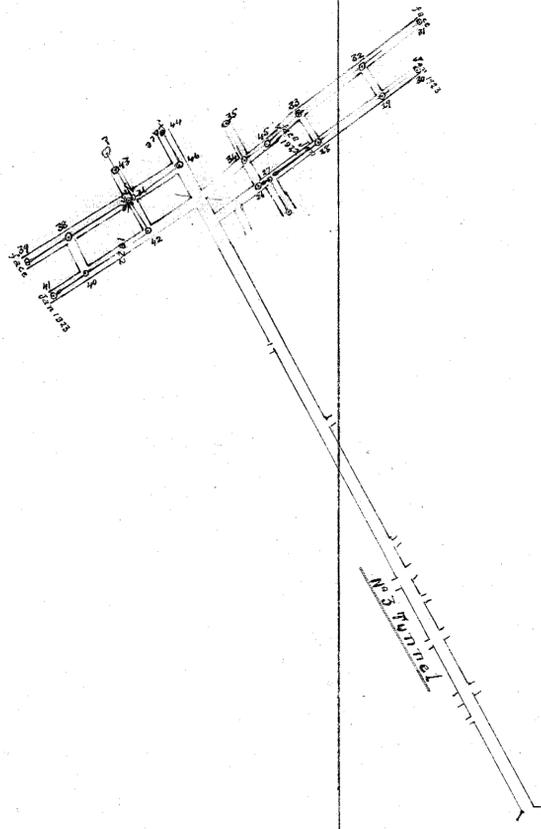

MOUNT NICHOLAS COAL COY PROPRIETARY LTD

Extension of workings for Year 1922

Scale = 2 chains to One Inch

H. M. Ledger

Referred to C-114
D-5-23