

186-30

5 cm

186-30

Lease N° 6663


M

319 AC

CORNWALL COAL COY N.L.

Lease N° 5688

M

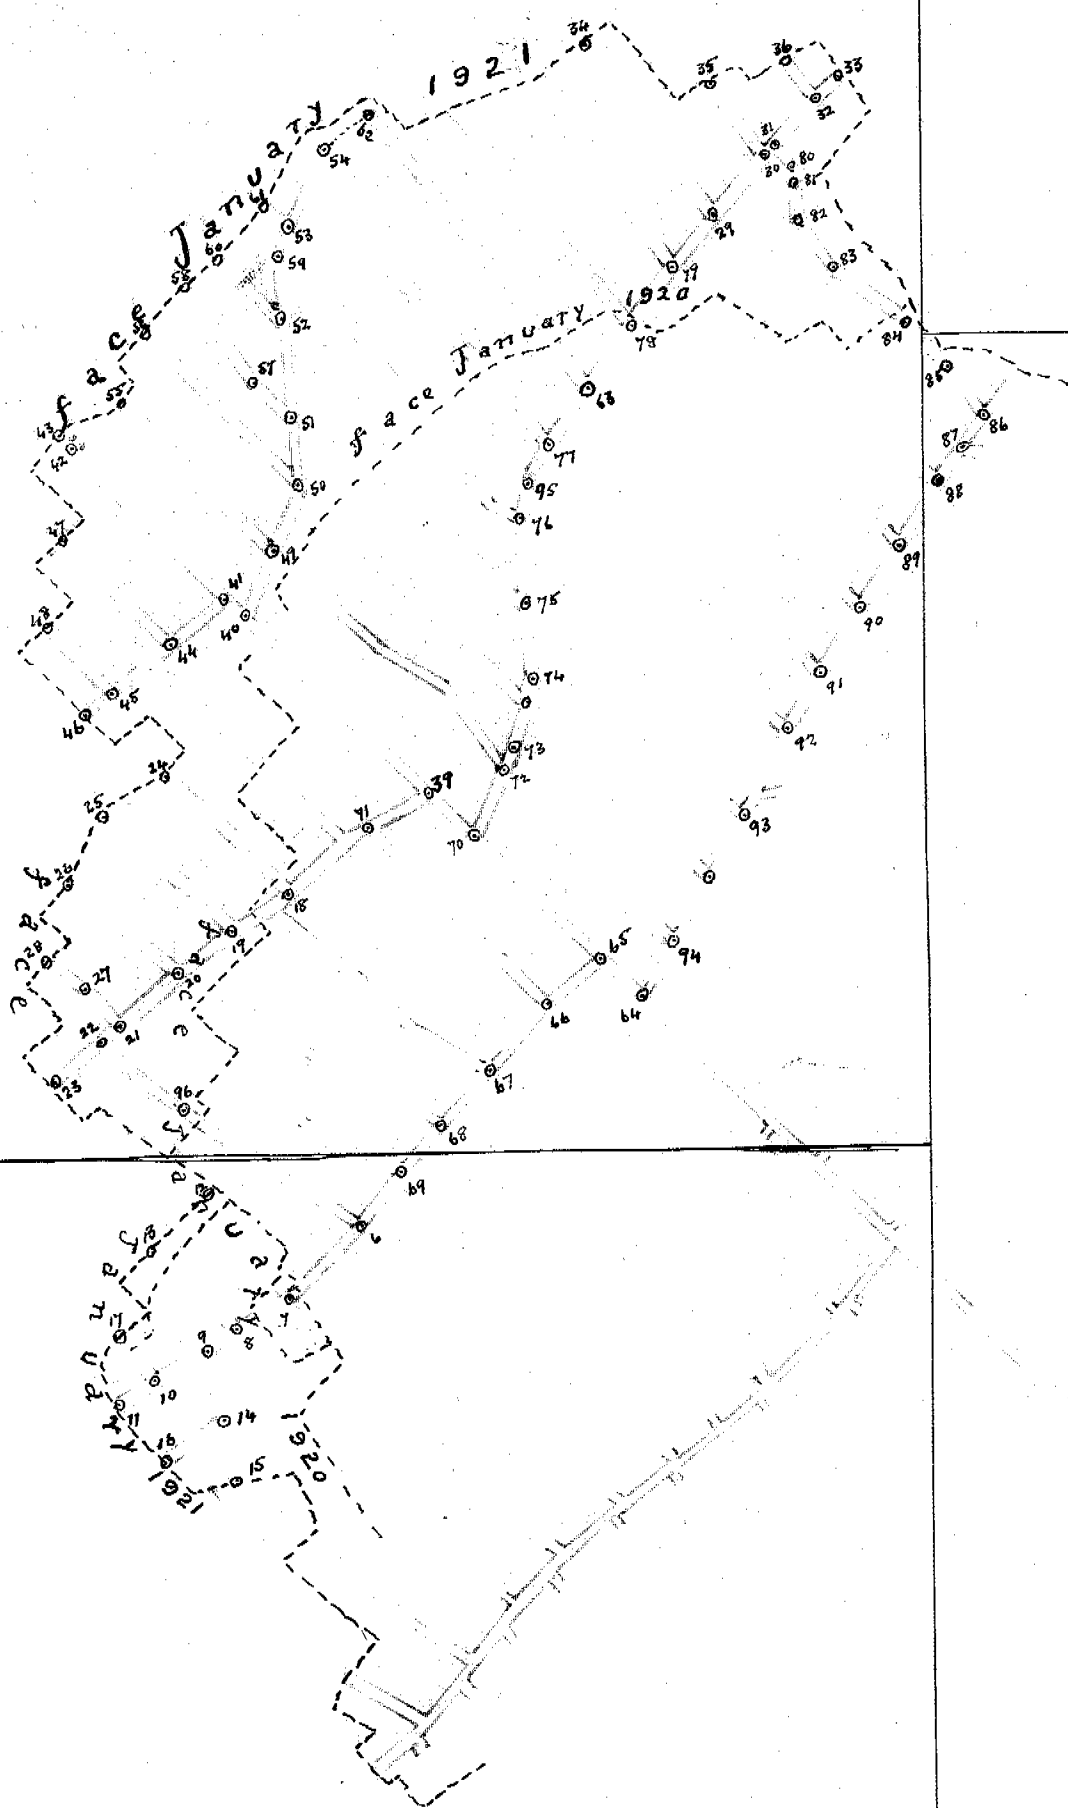

Lease N° 2116

Lease N° 2117

MOUNT NICHOLAS COLLIERY

Plan of extension of workings for Year 1920

Scale = 2 chains to one inch.

Wm. Ledger
December 28th & 29th 1920
& Jan 3. 1921

