


Printed by J. Smith
1894

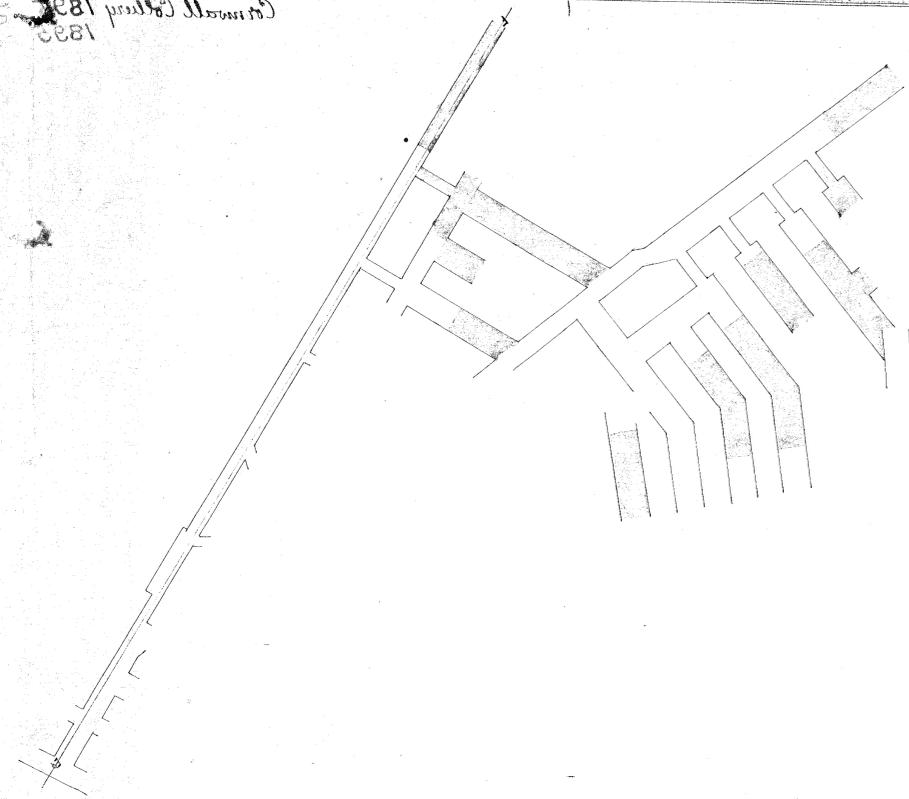



CORNWALL COAL MINE

PLAN
Of extension of workings during
1894.

H. S. Smith
Miner



187-04

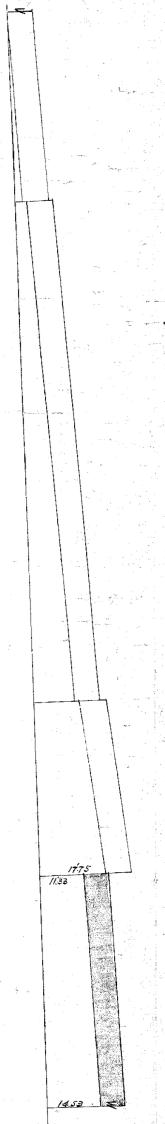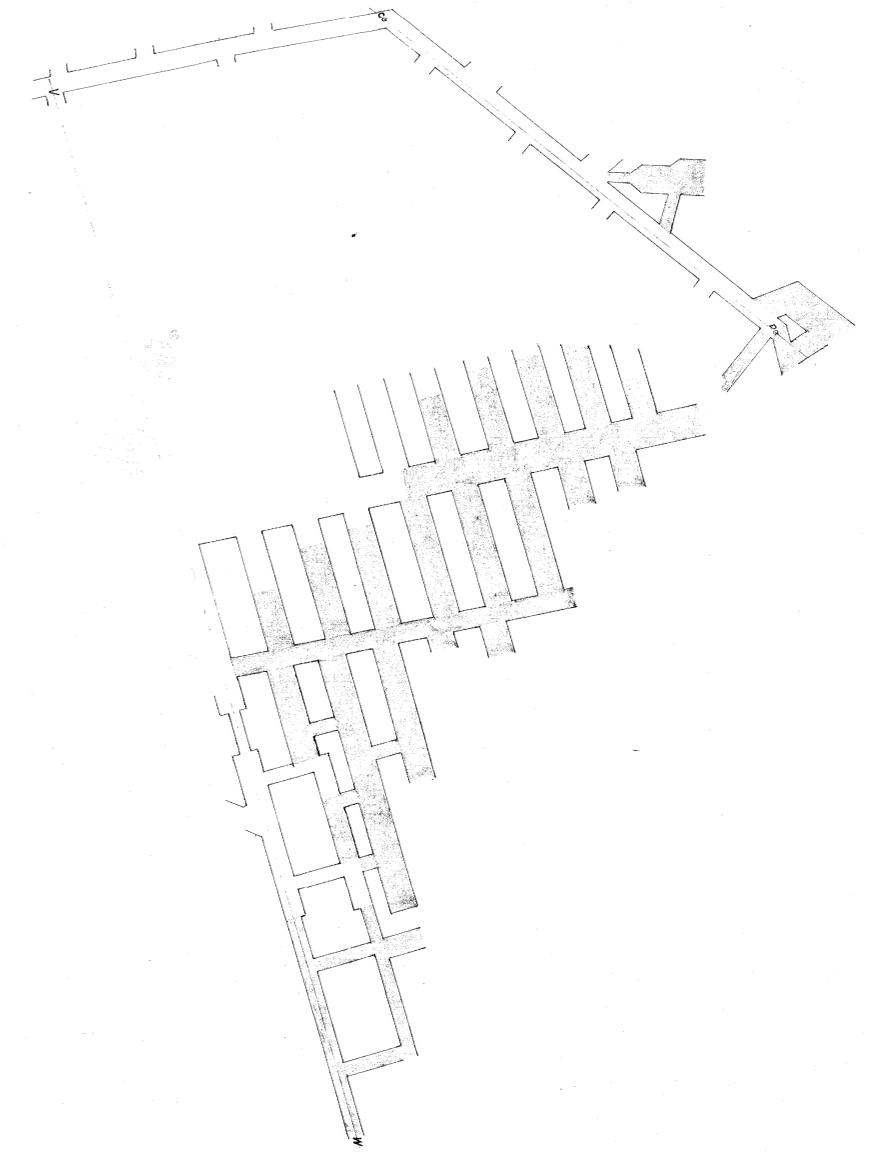

187-04

1894 Cornwall Coal Mine