

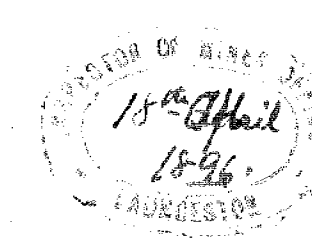
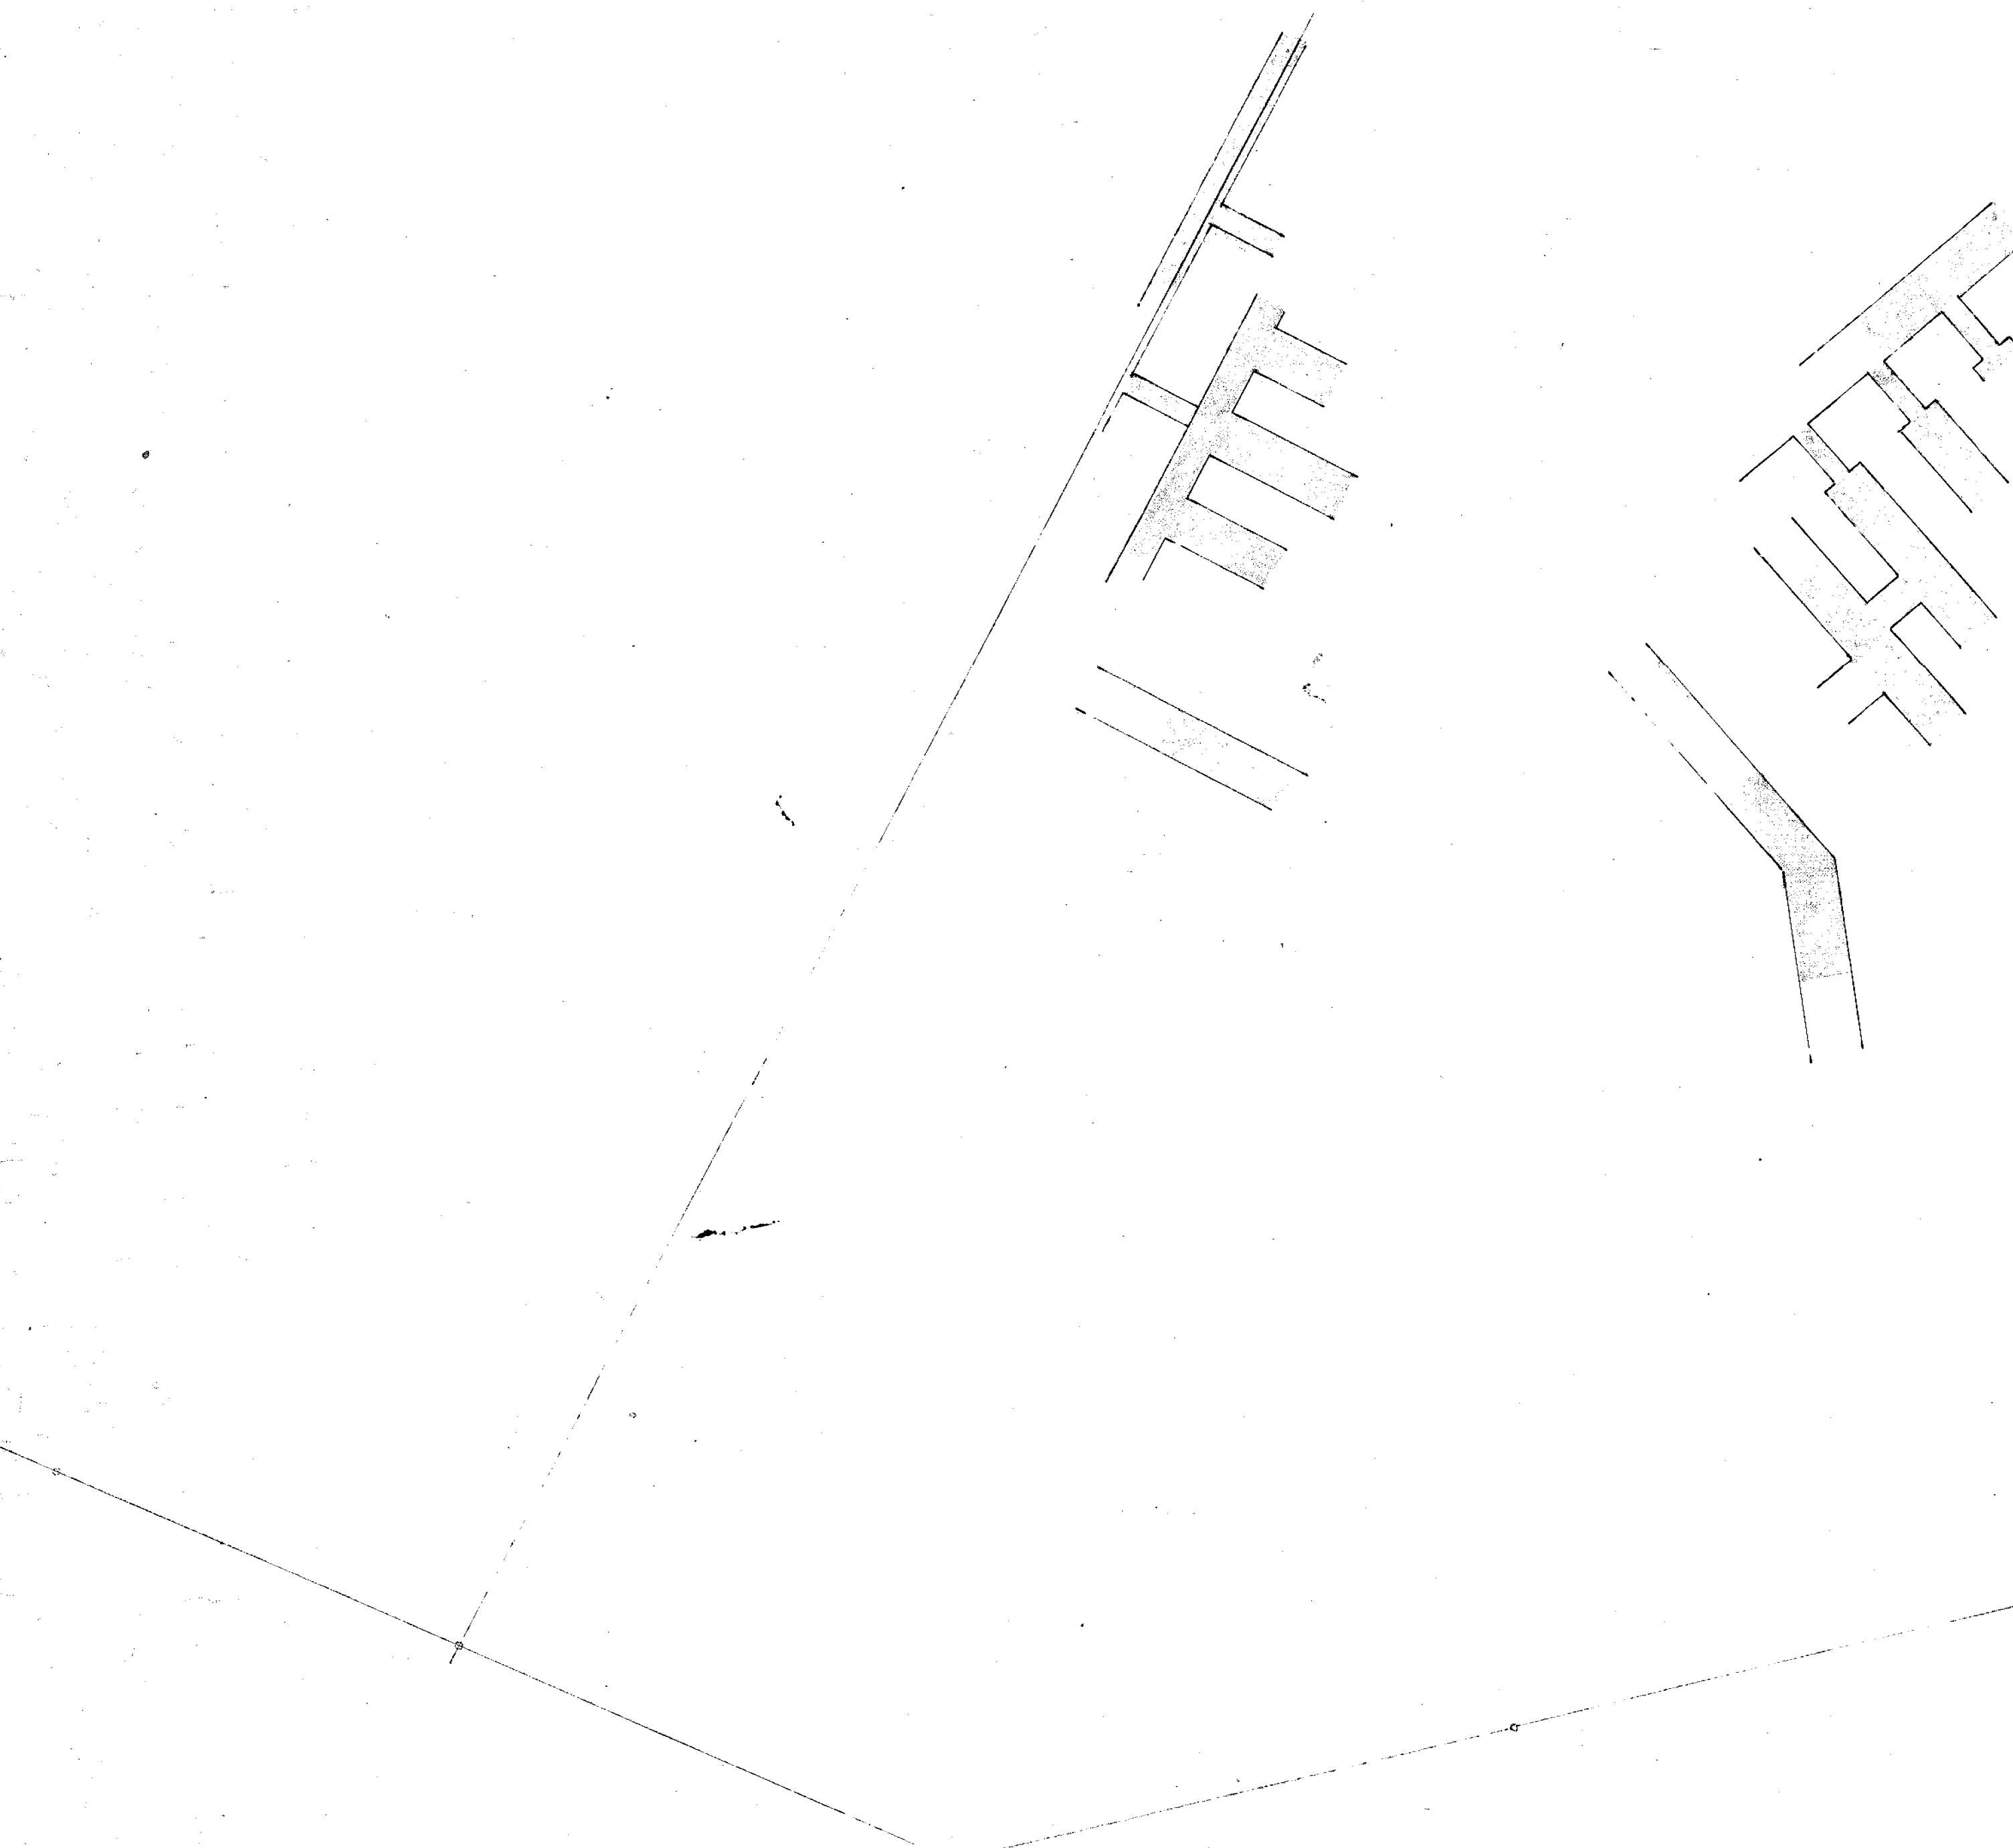


CORNWALL COAL MINE
Fragmentary
PLAN
Showing the work (colored green) during the Year
1895.

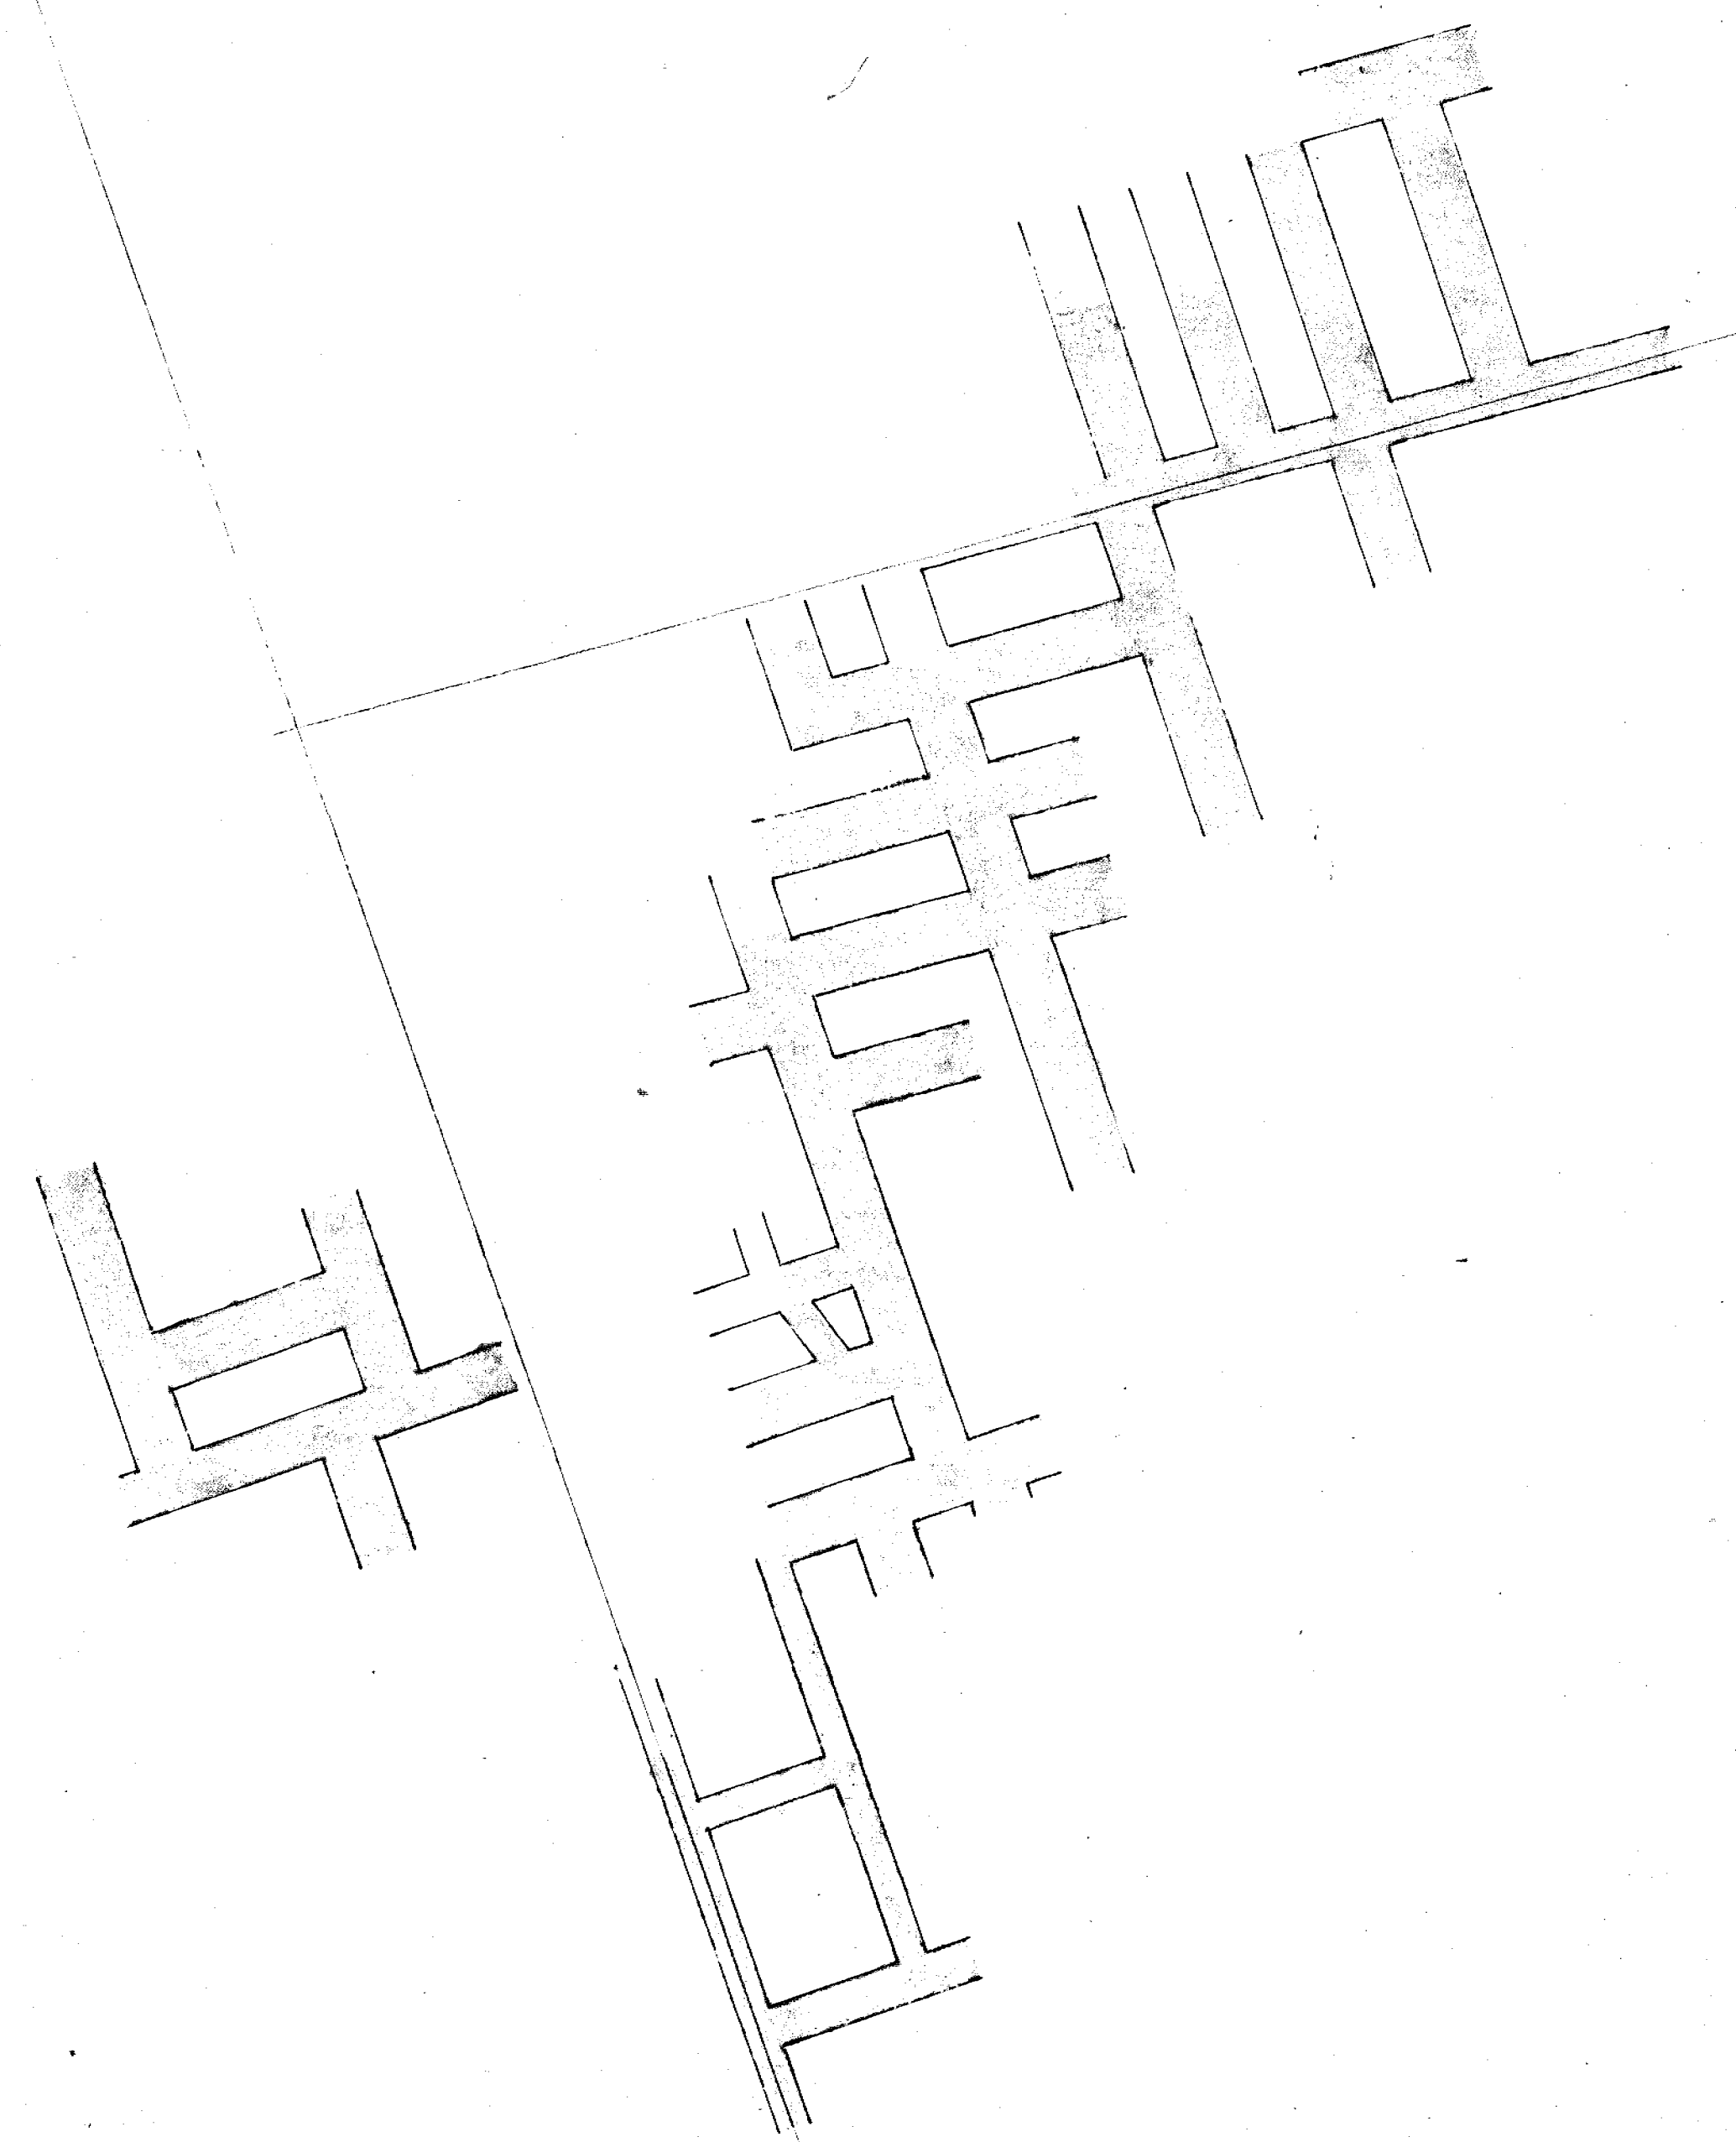

Mr. A. H. H. H.
Min. Secy.

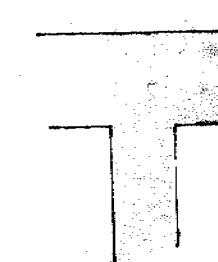

1895
50-18
1895
Cornwall Coal Mine

1895
Cornwall Coal Mine