
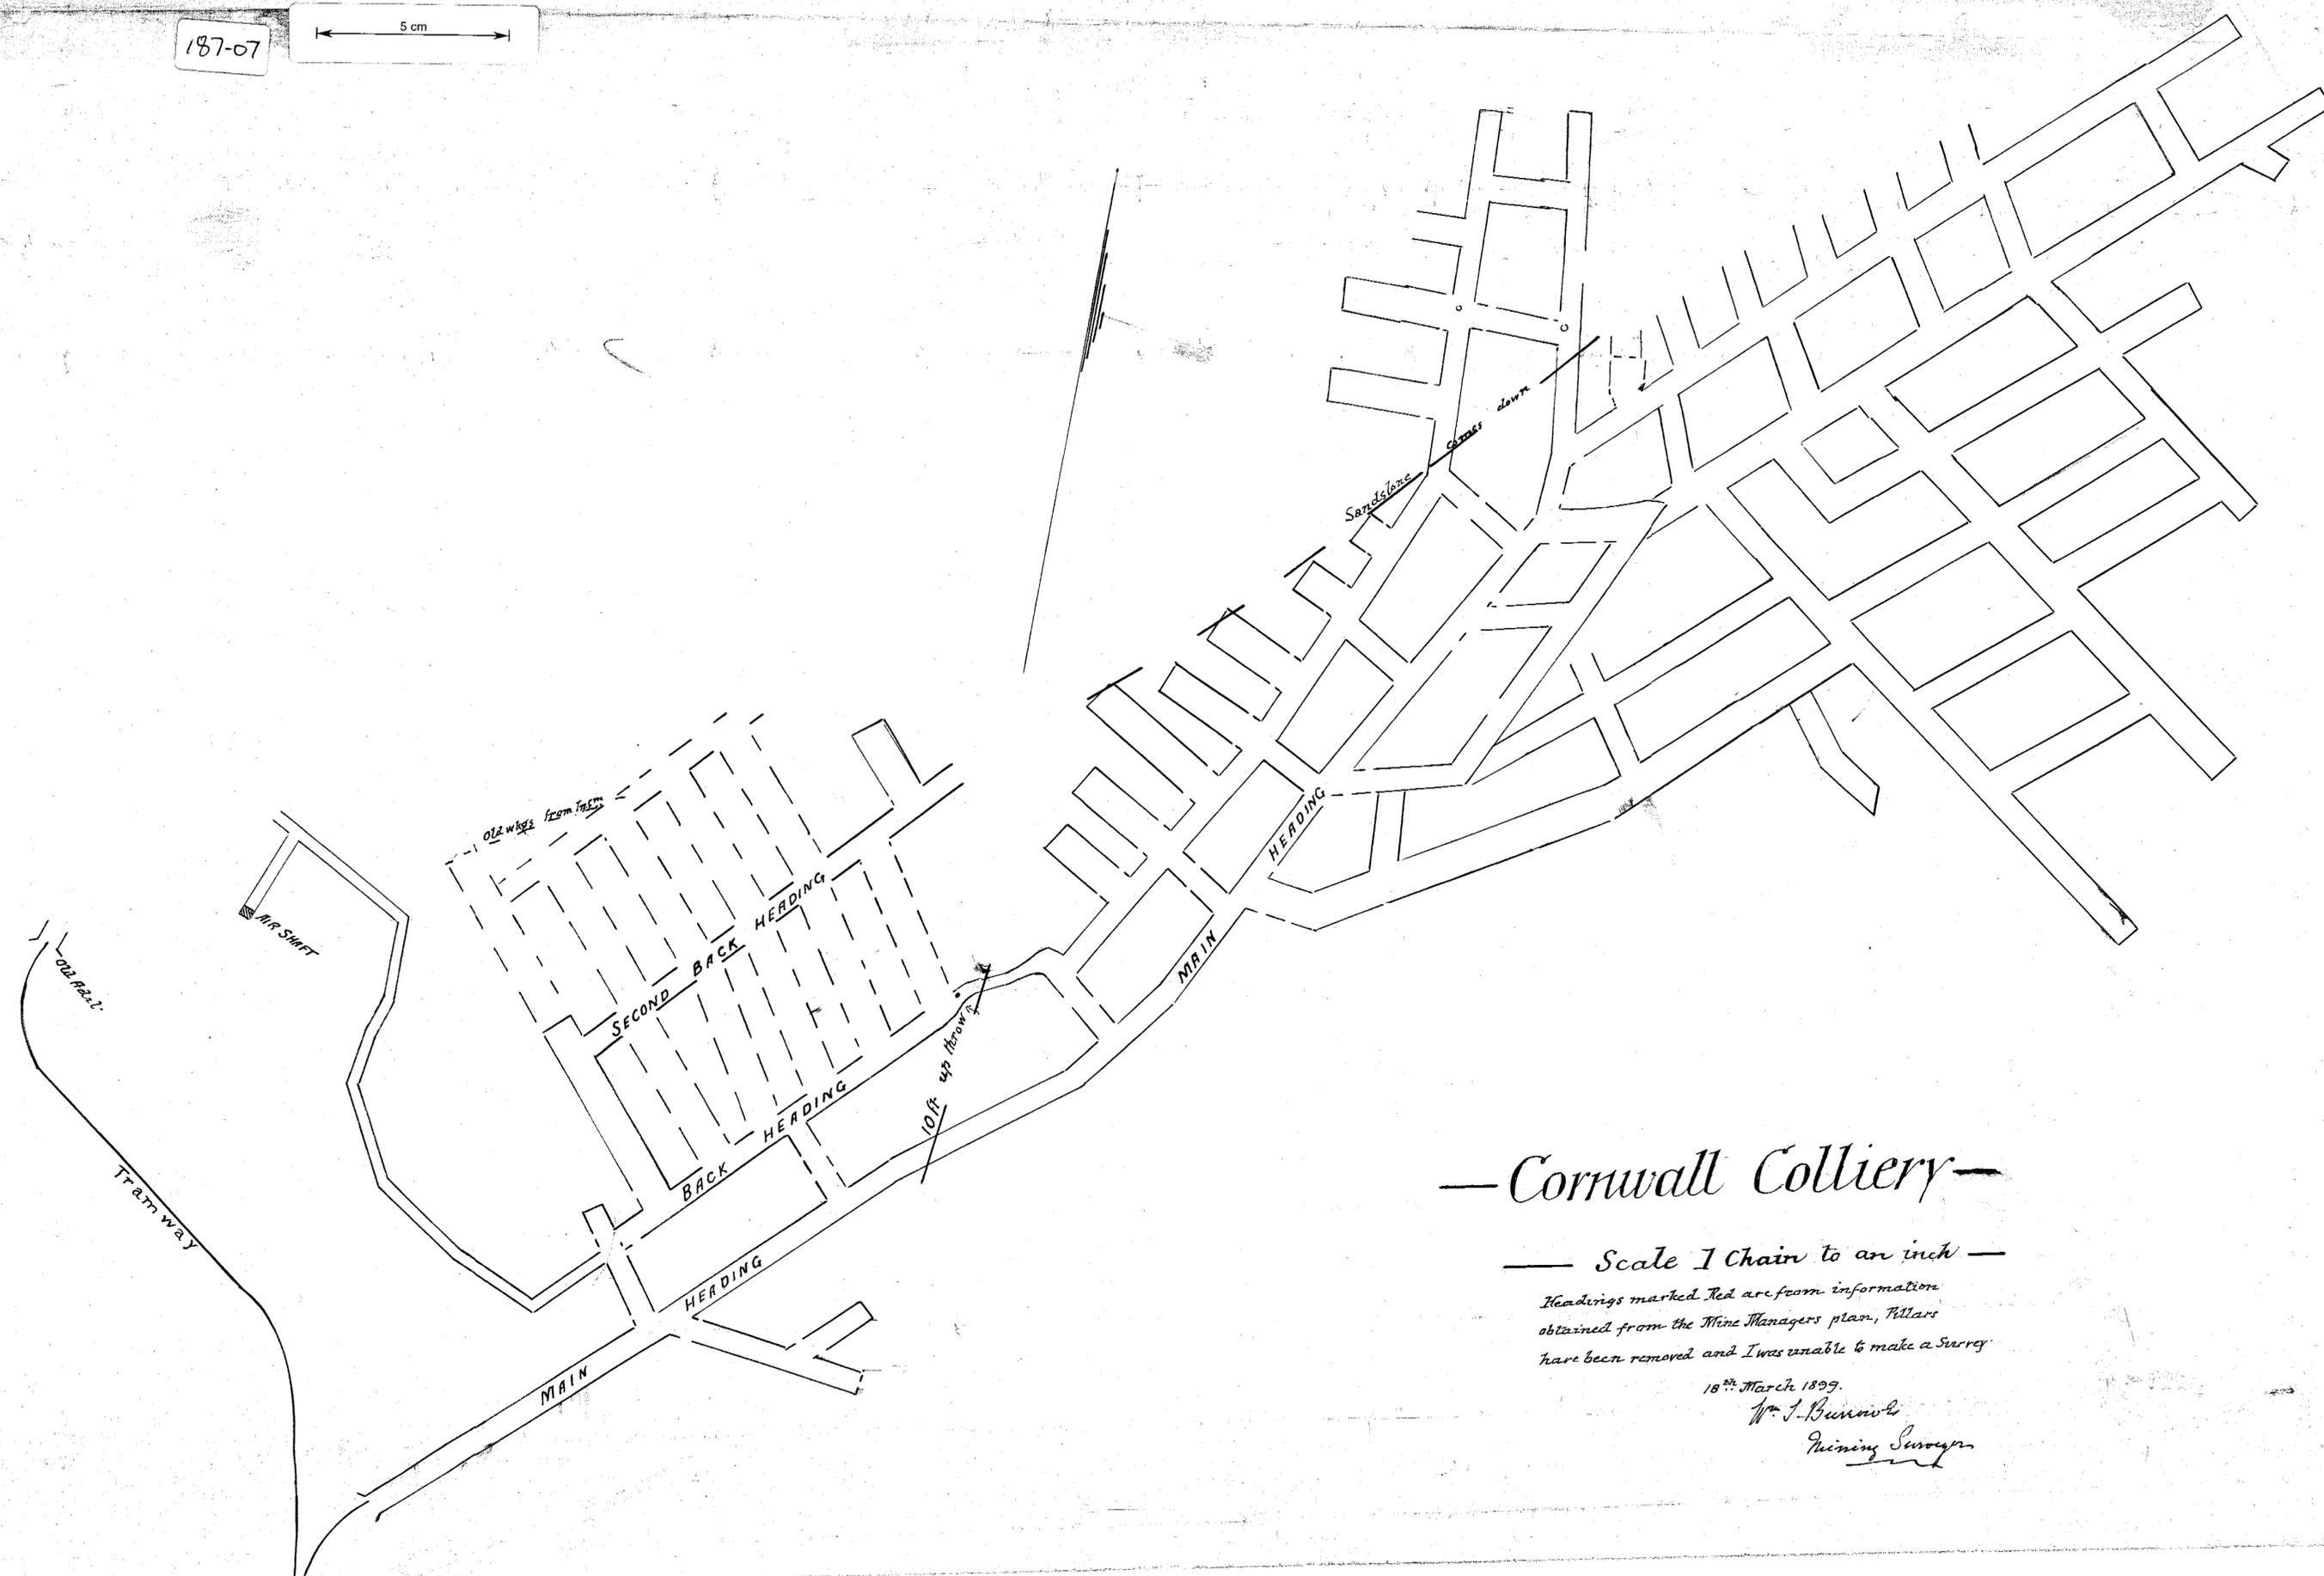


187-67

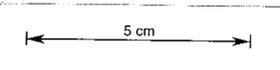

— Cornwall Colliery —

— Scale 1 chain to an inch —

Headings marked Red are from information obtained from the Mine Managers plan, Pillars have been removed and I was unable to make a survey

18th March 1899.

W. J. Burrows
Mining Surveyor