


1891 March 1899

5 cm

187-08

187-08

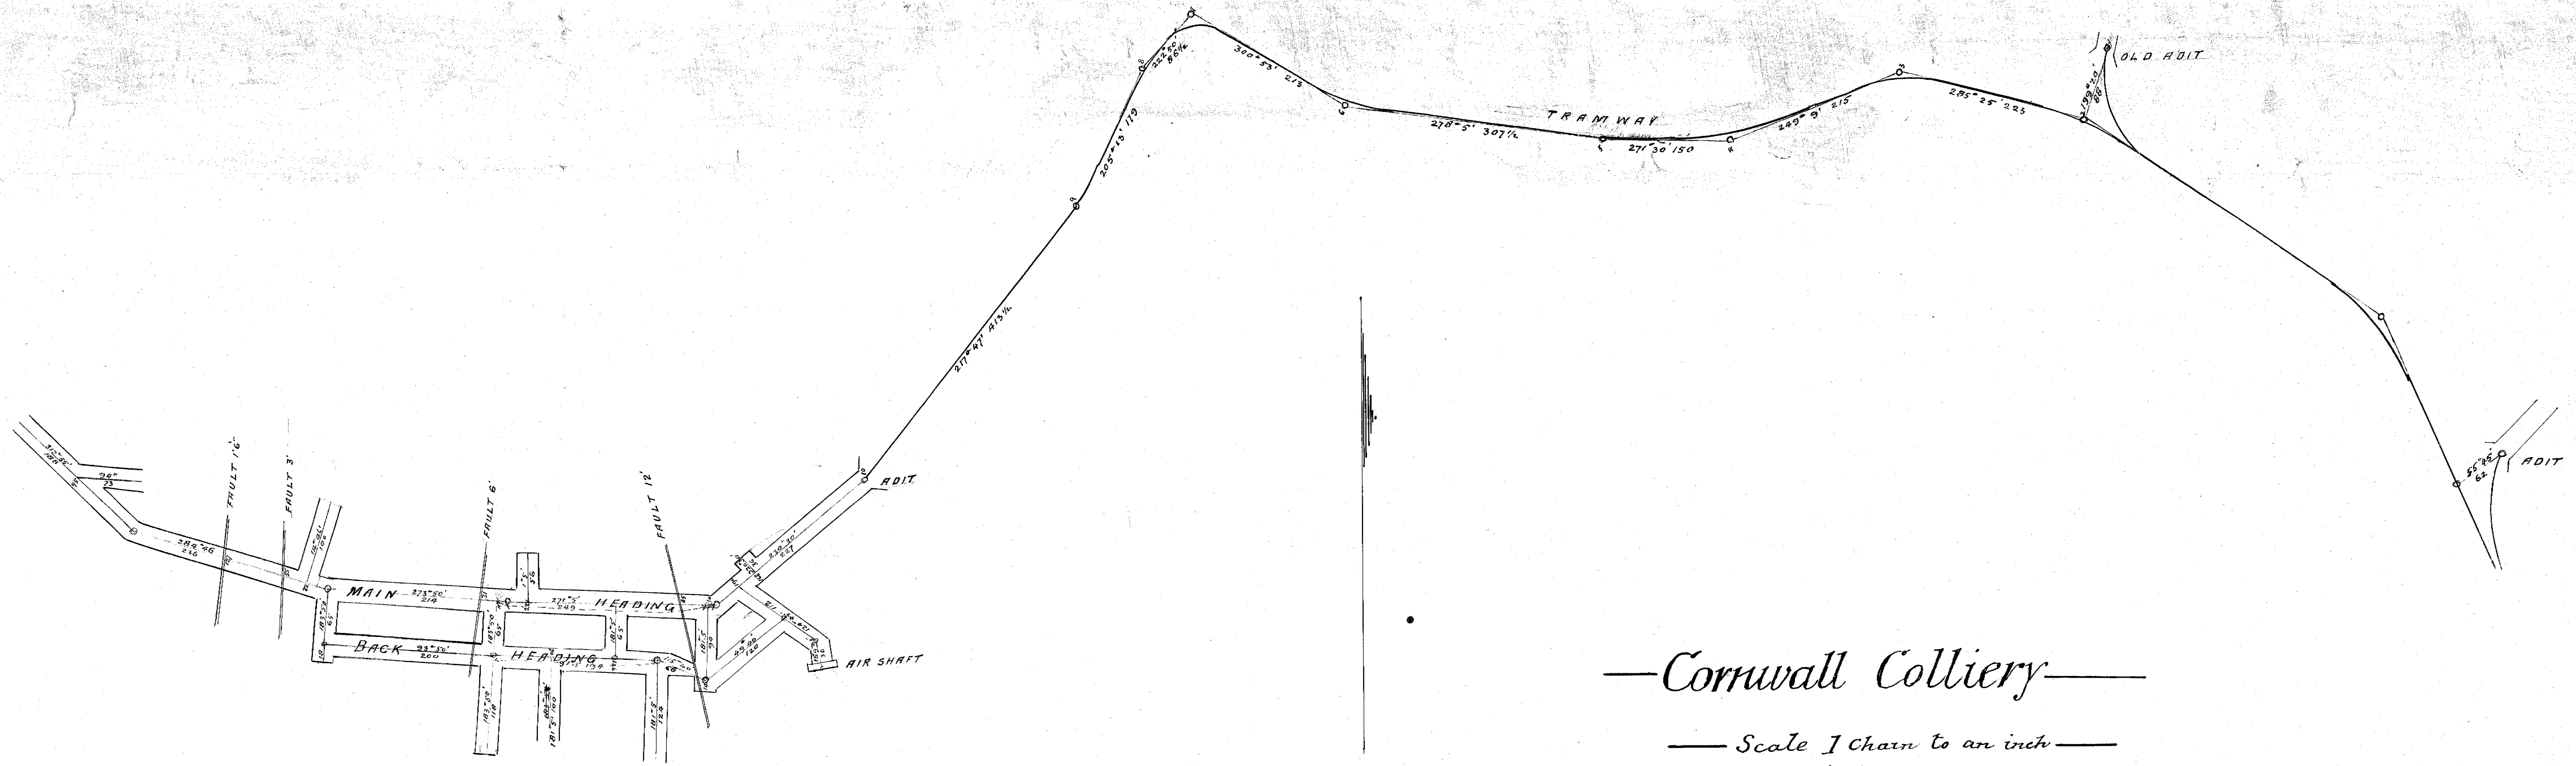

—Cornwall Colliery—

— Scale 1 chain to an inch —

18th March 1899

W. L. Burrows

Mining Surveyor.