


CORNWALL COAL MINE

Scale 1 chain to 1 inch.

187-09

187-09

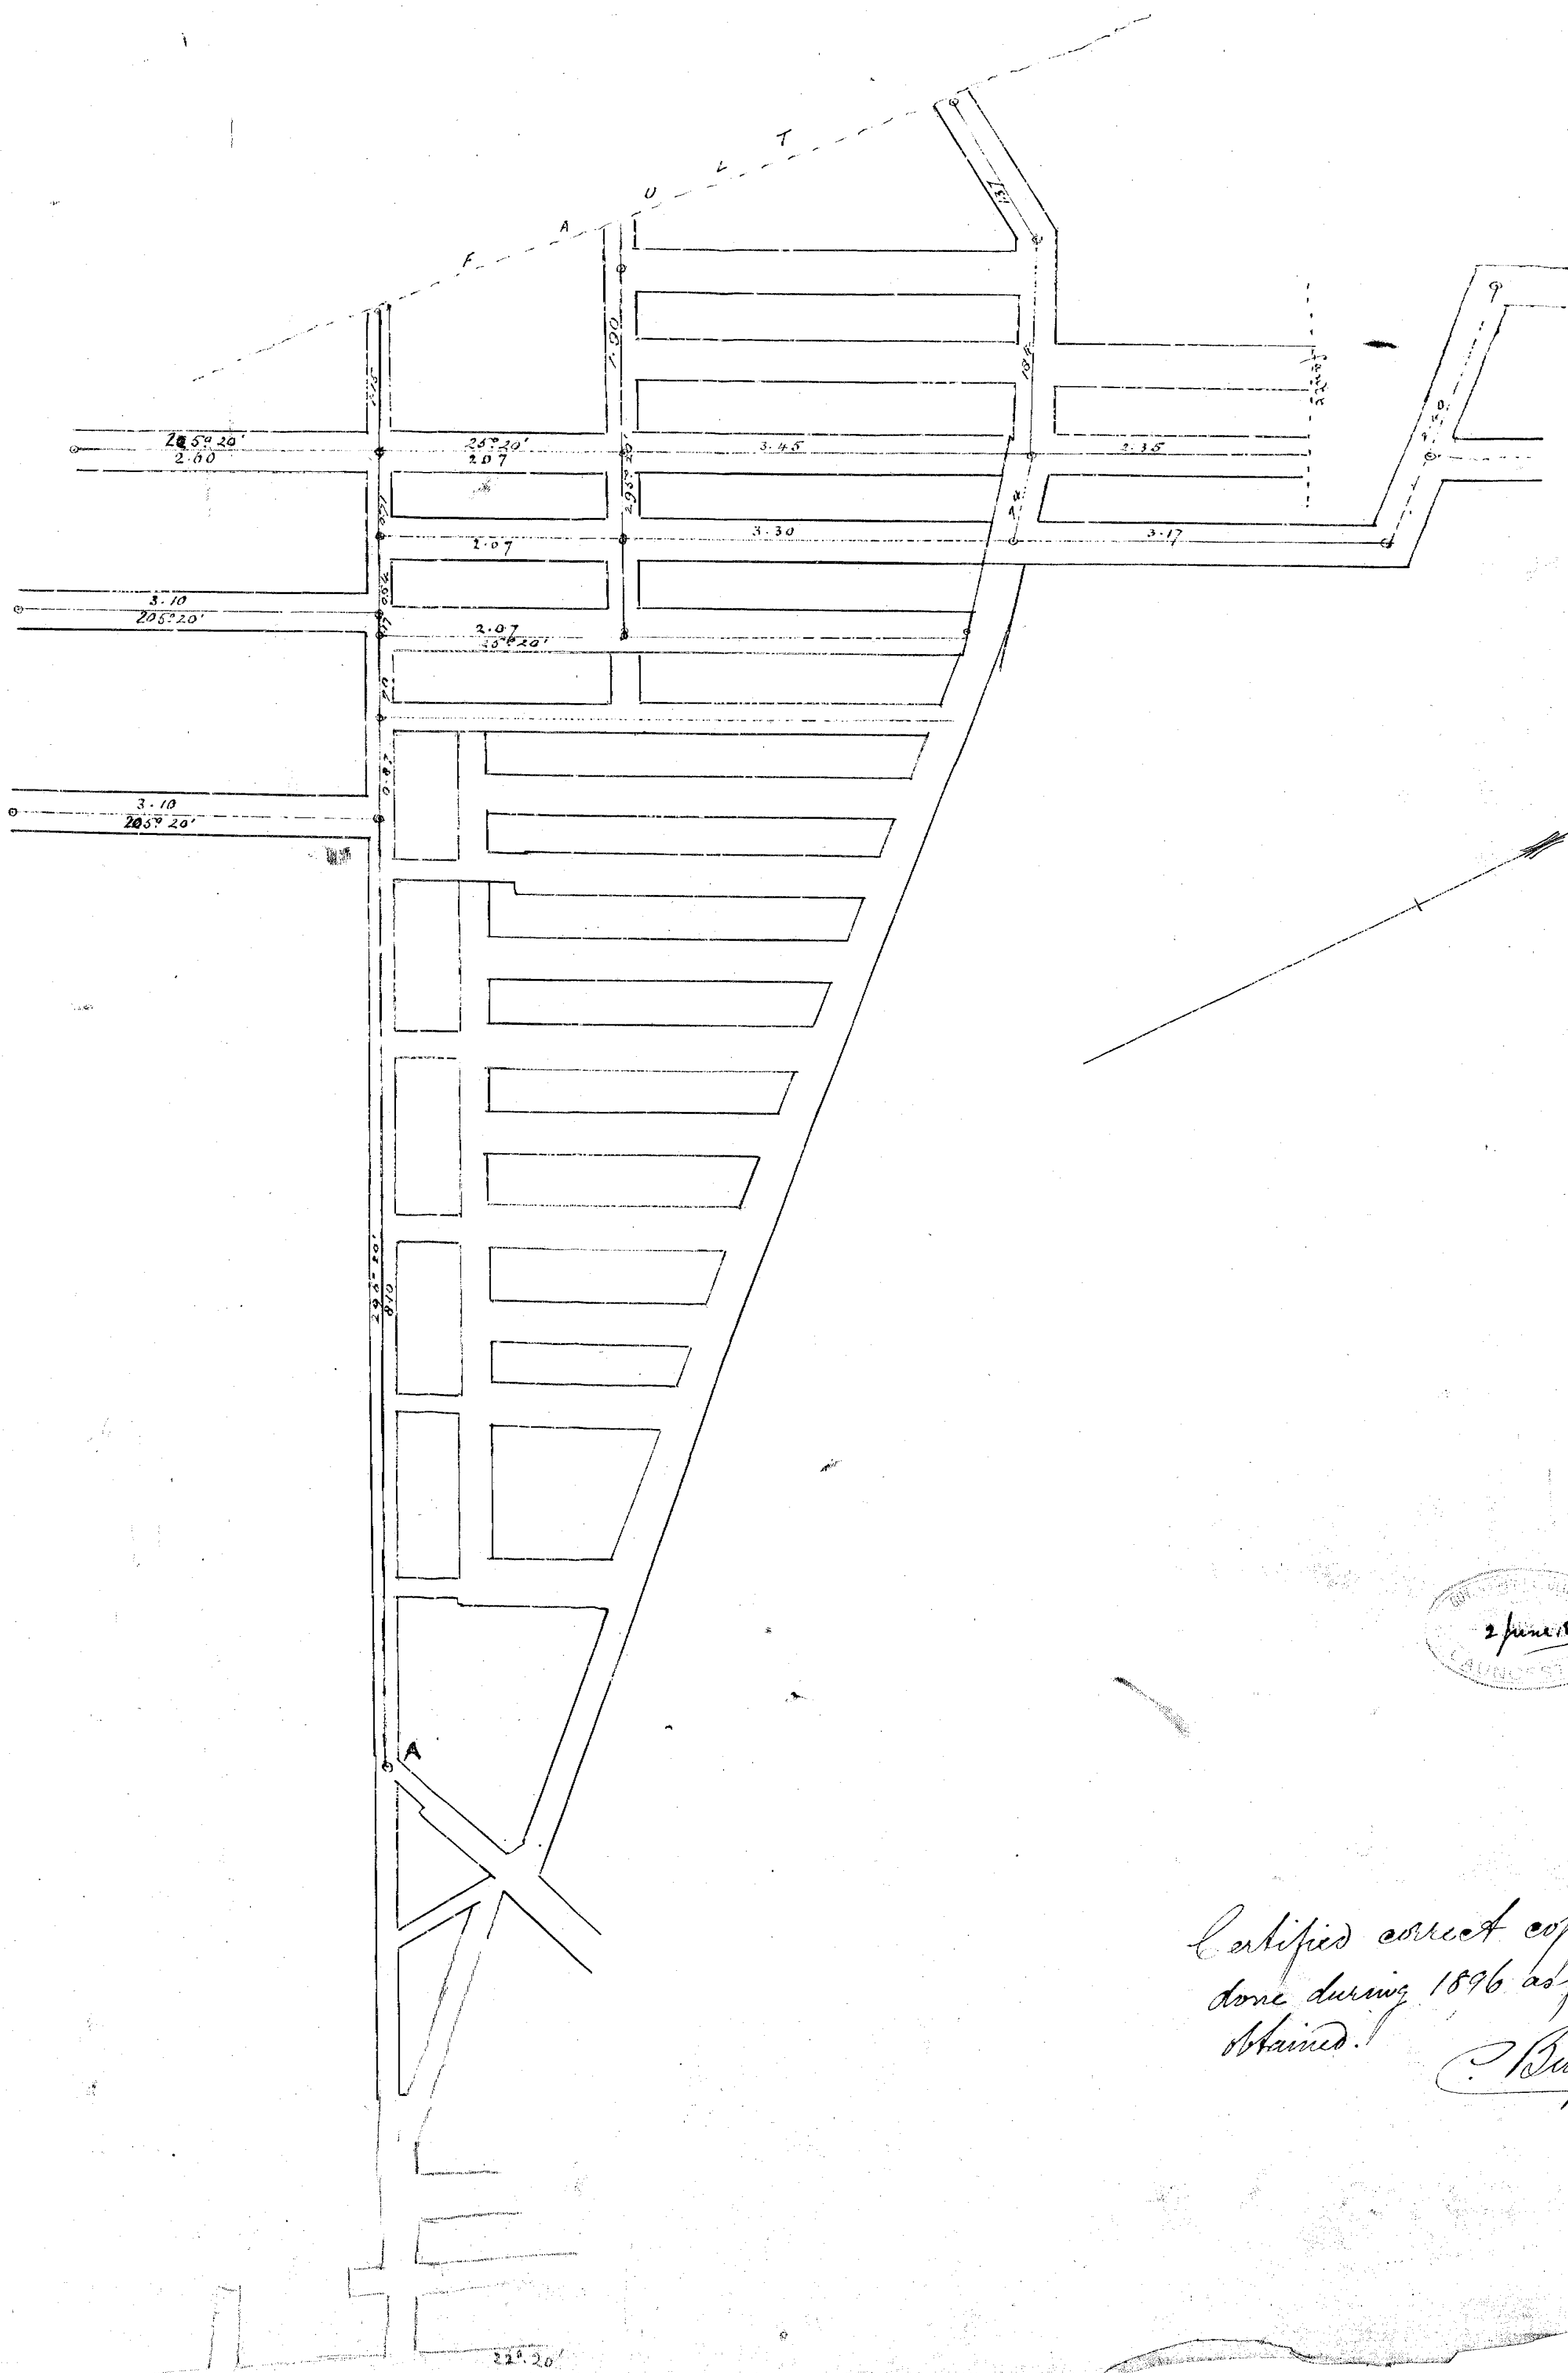

2 June 1897
LONDON

Certified correct copy of plan of work
done during 1896 as far as can be
obtained.
R. B. B. B. B.
R. B. B. B. B.
31/5/97

187-09