


CORNWALL COLLIERY

LOWER WORKINGS

SCALE 1 CHAIN TO 1 INCH

5 cm

187-10

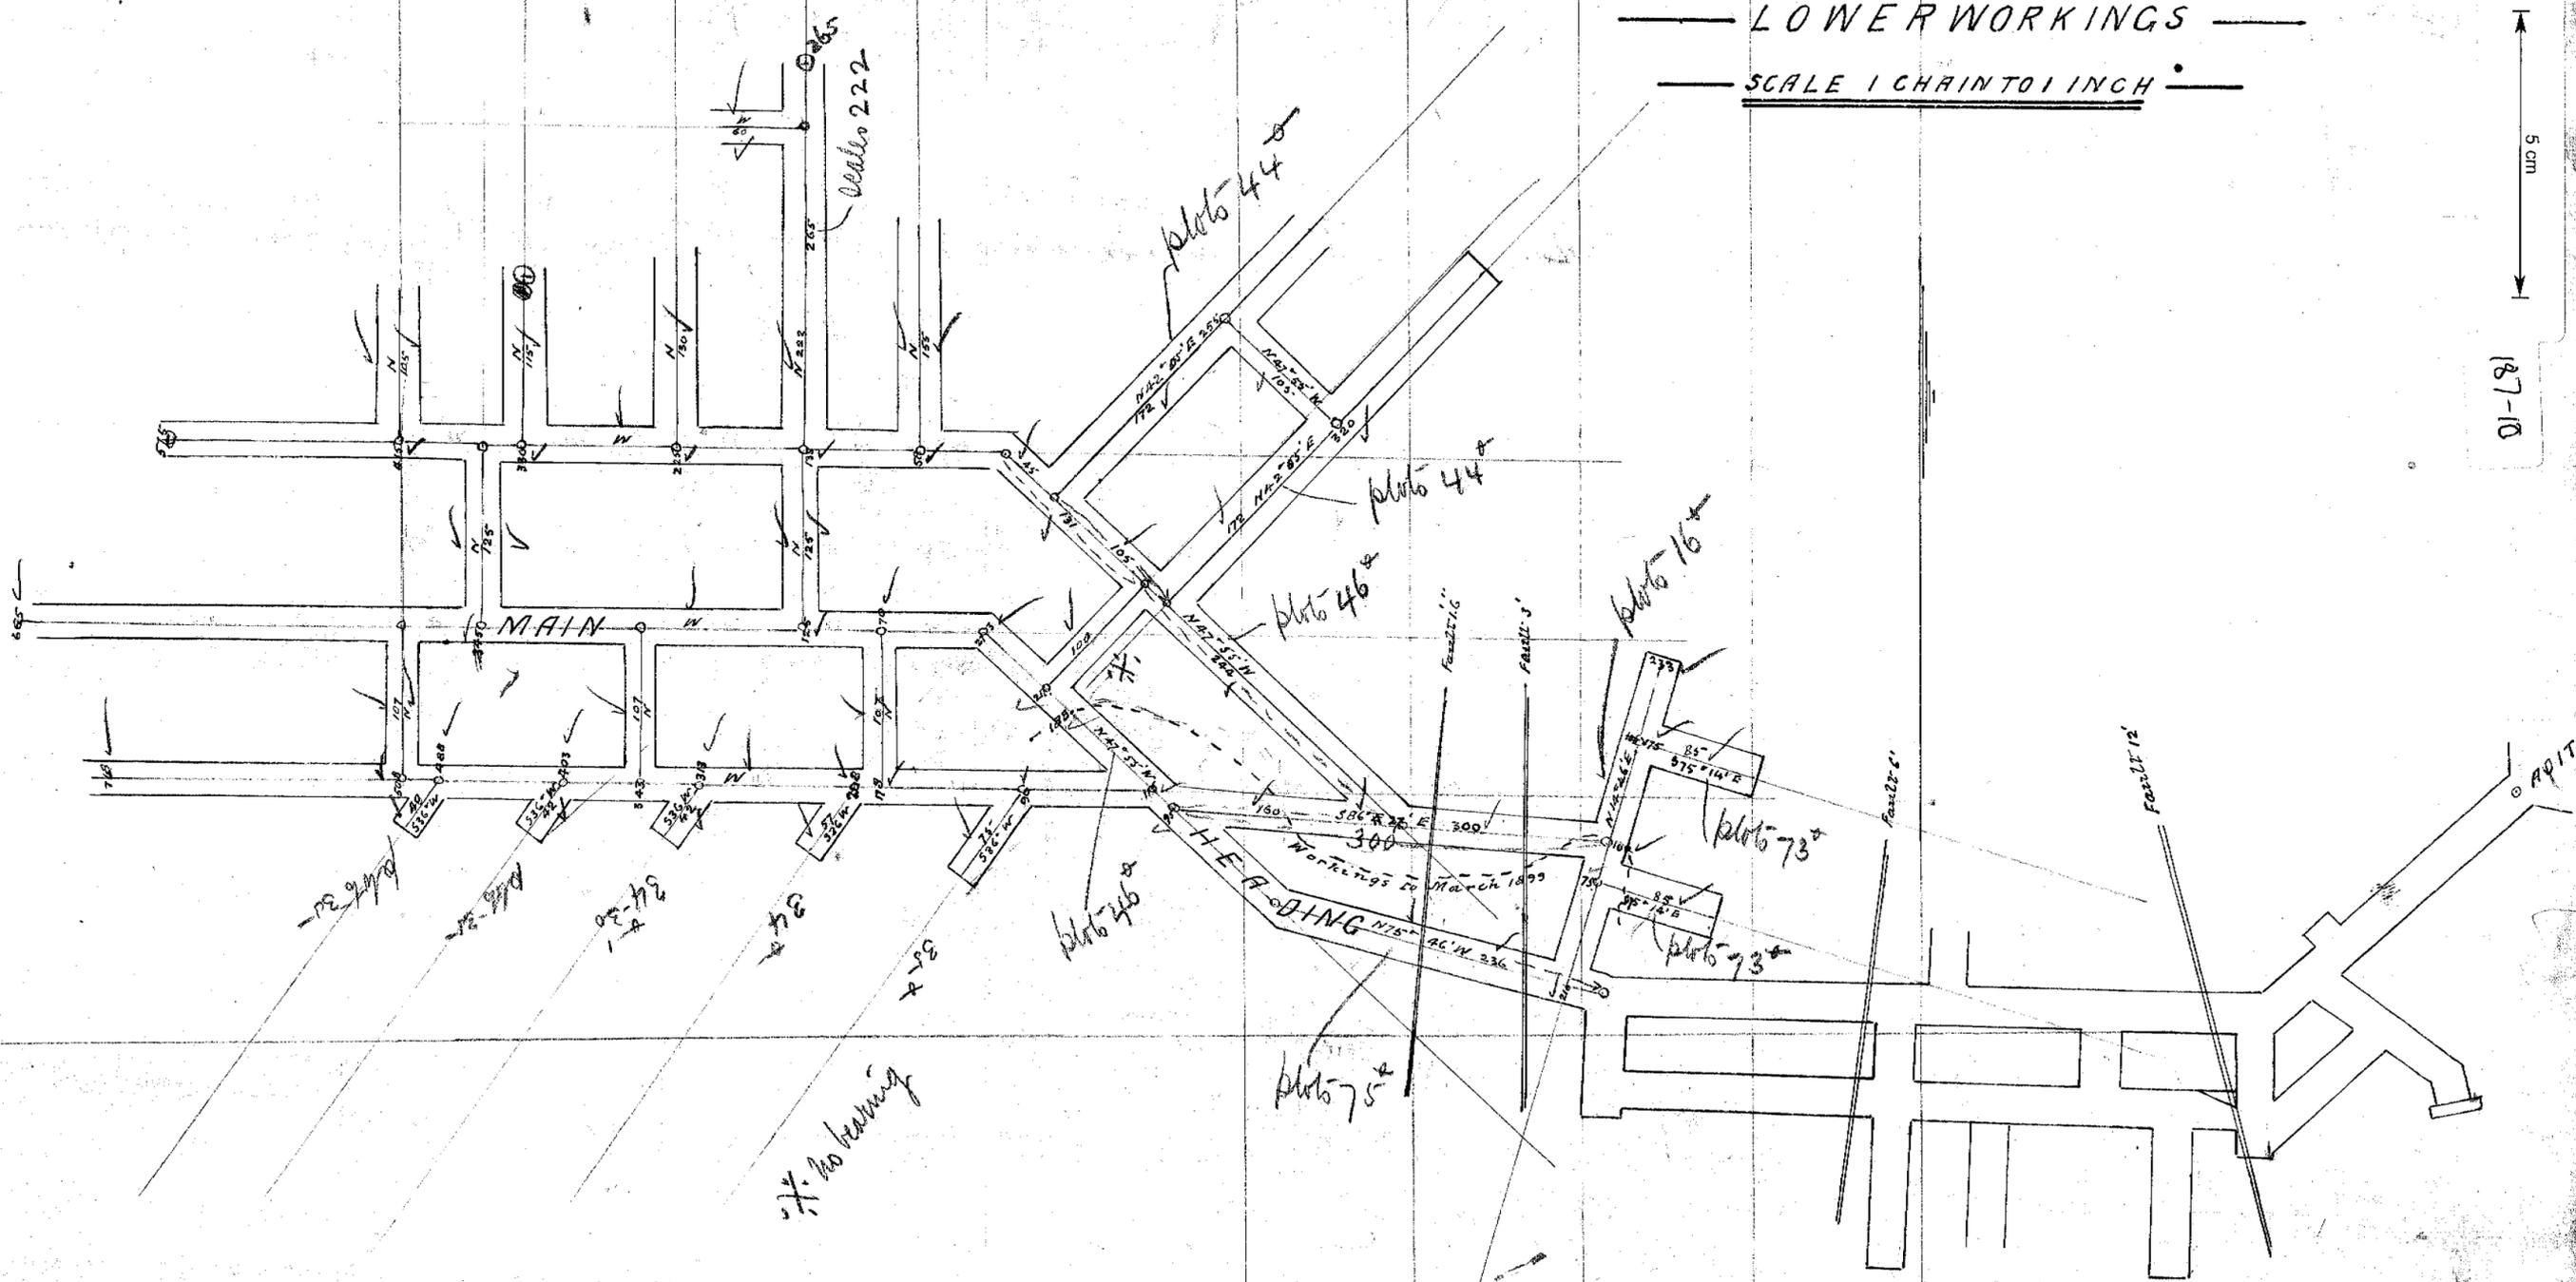

187-10

Wm. J. Burrows
 Mining Surveyor
 Cornwall
 Feb 1900
 the date used