

5 cm

# CORNWALL COLLIERY


— LOWER AND UPPER WORKINGS —

— DOTTED LINES SHOW WORKINGS FOR 1898 AND 99 —

— FULL LINES " " " 1900 —

— SCALE ONE CHAIN TO ONE INCH —

— INSTRUMENT USED THEODOLITE —

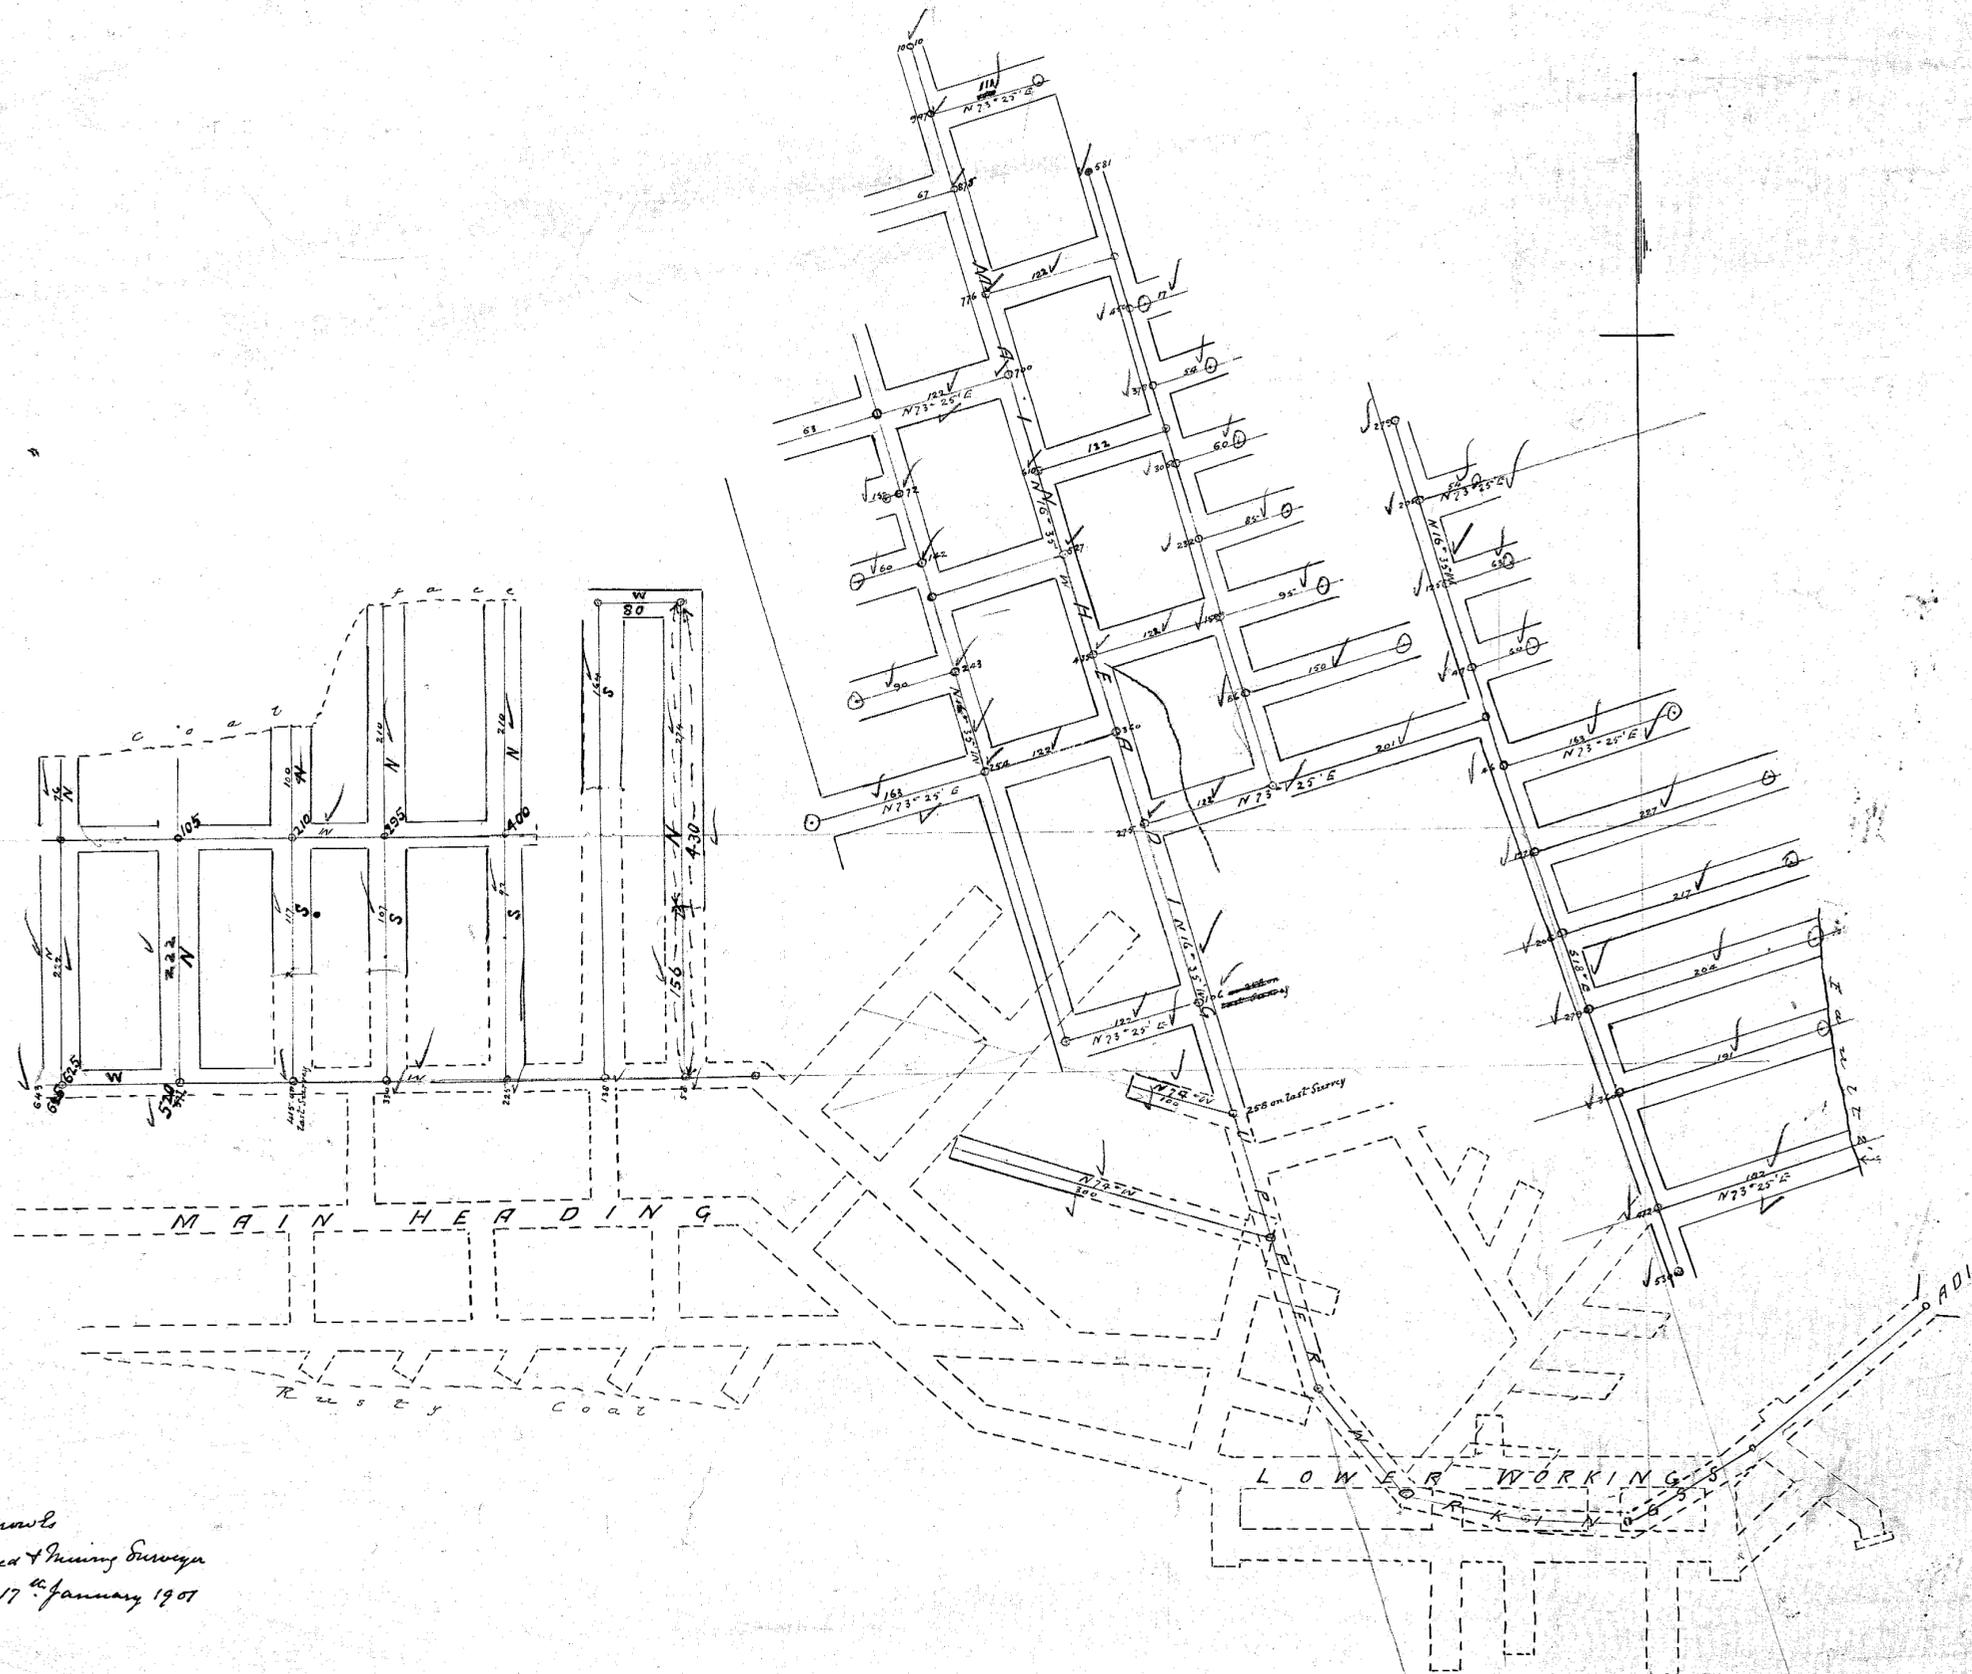

Handwritten notes on the right margin, possibly including the name 'W. J. Burrows'.



W. J. Burrows  
 Authorized Mining Surveyor  
 17<sup>th</sup> January 1901

Handwritten text at the bottom right corner, possibly a reference or date.