



187-13

187-13
1805
1001

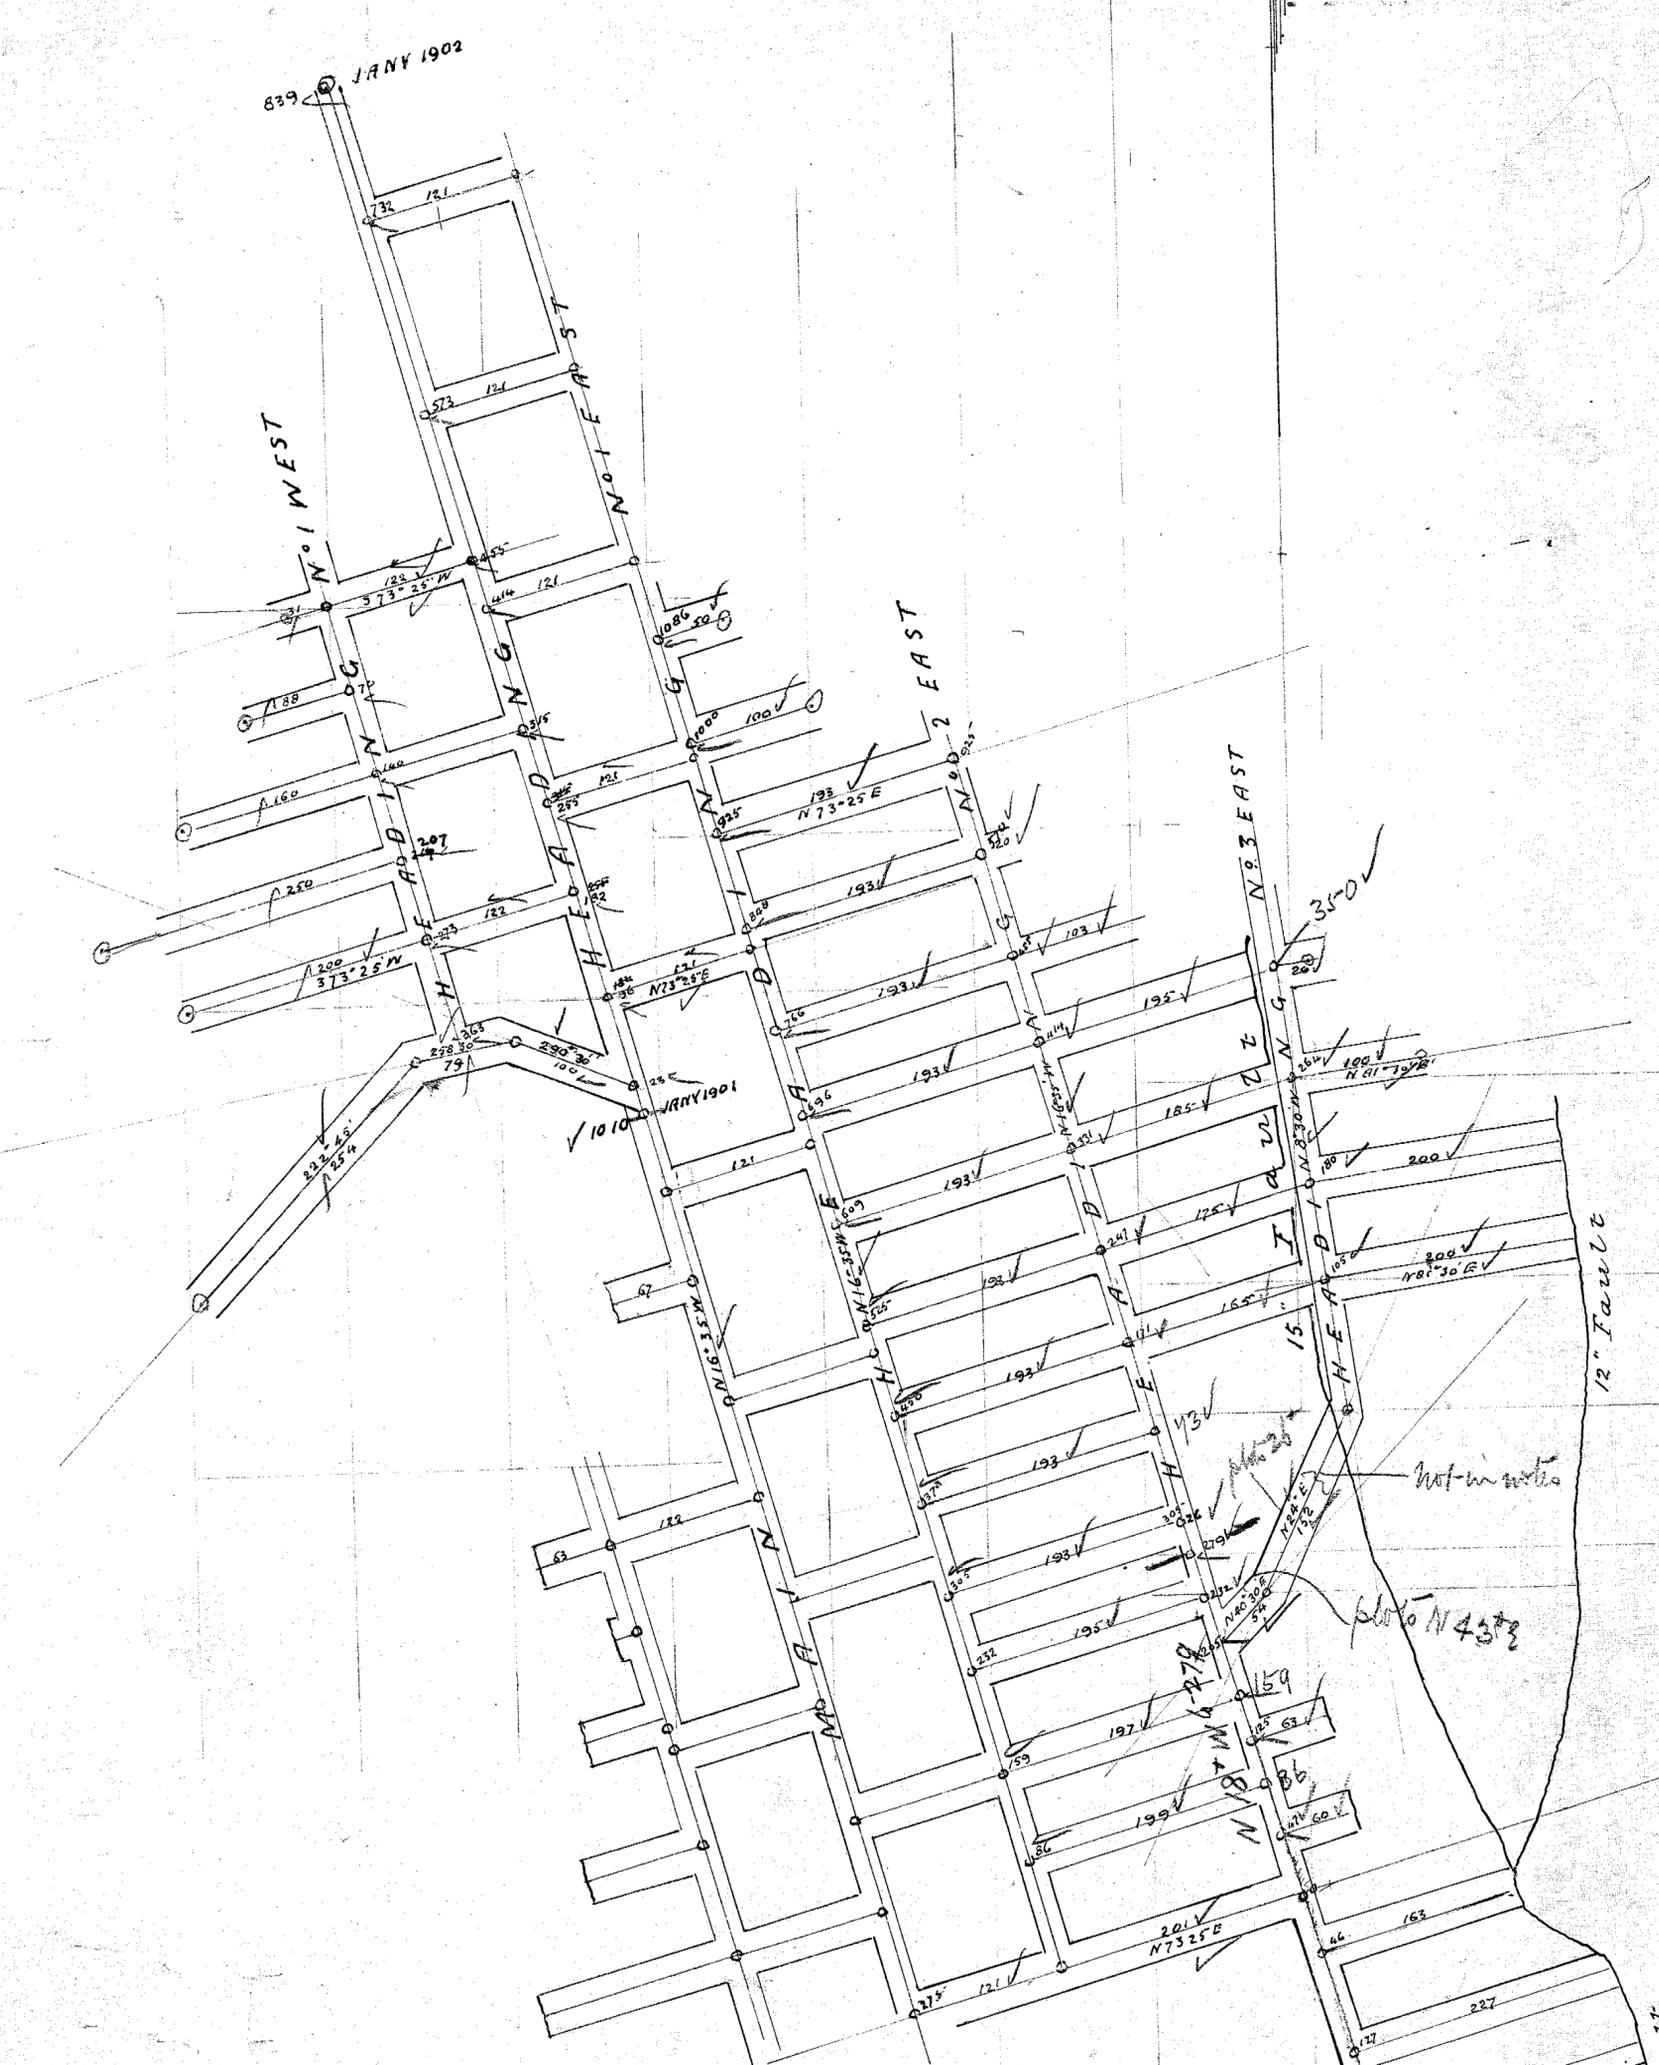

CORNWALL COLLIERY
UPPER WORKINGS

SCALE 1cm TO 1 INCH

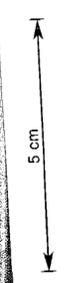

THEODOLITE USED
 Wm J. Burrows
 Authorised Mining Surveyor
 20th Jan'y 1902

12" Fault

2ft 6 in Fault

Not in section
 photo N 4373

187-13