



187-14  
MINE DEPARTMENT

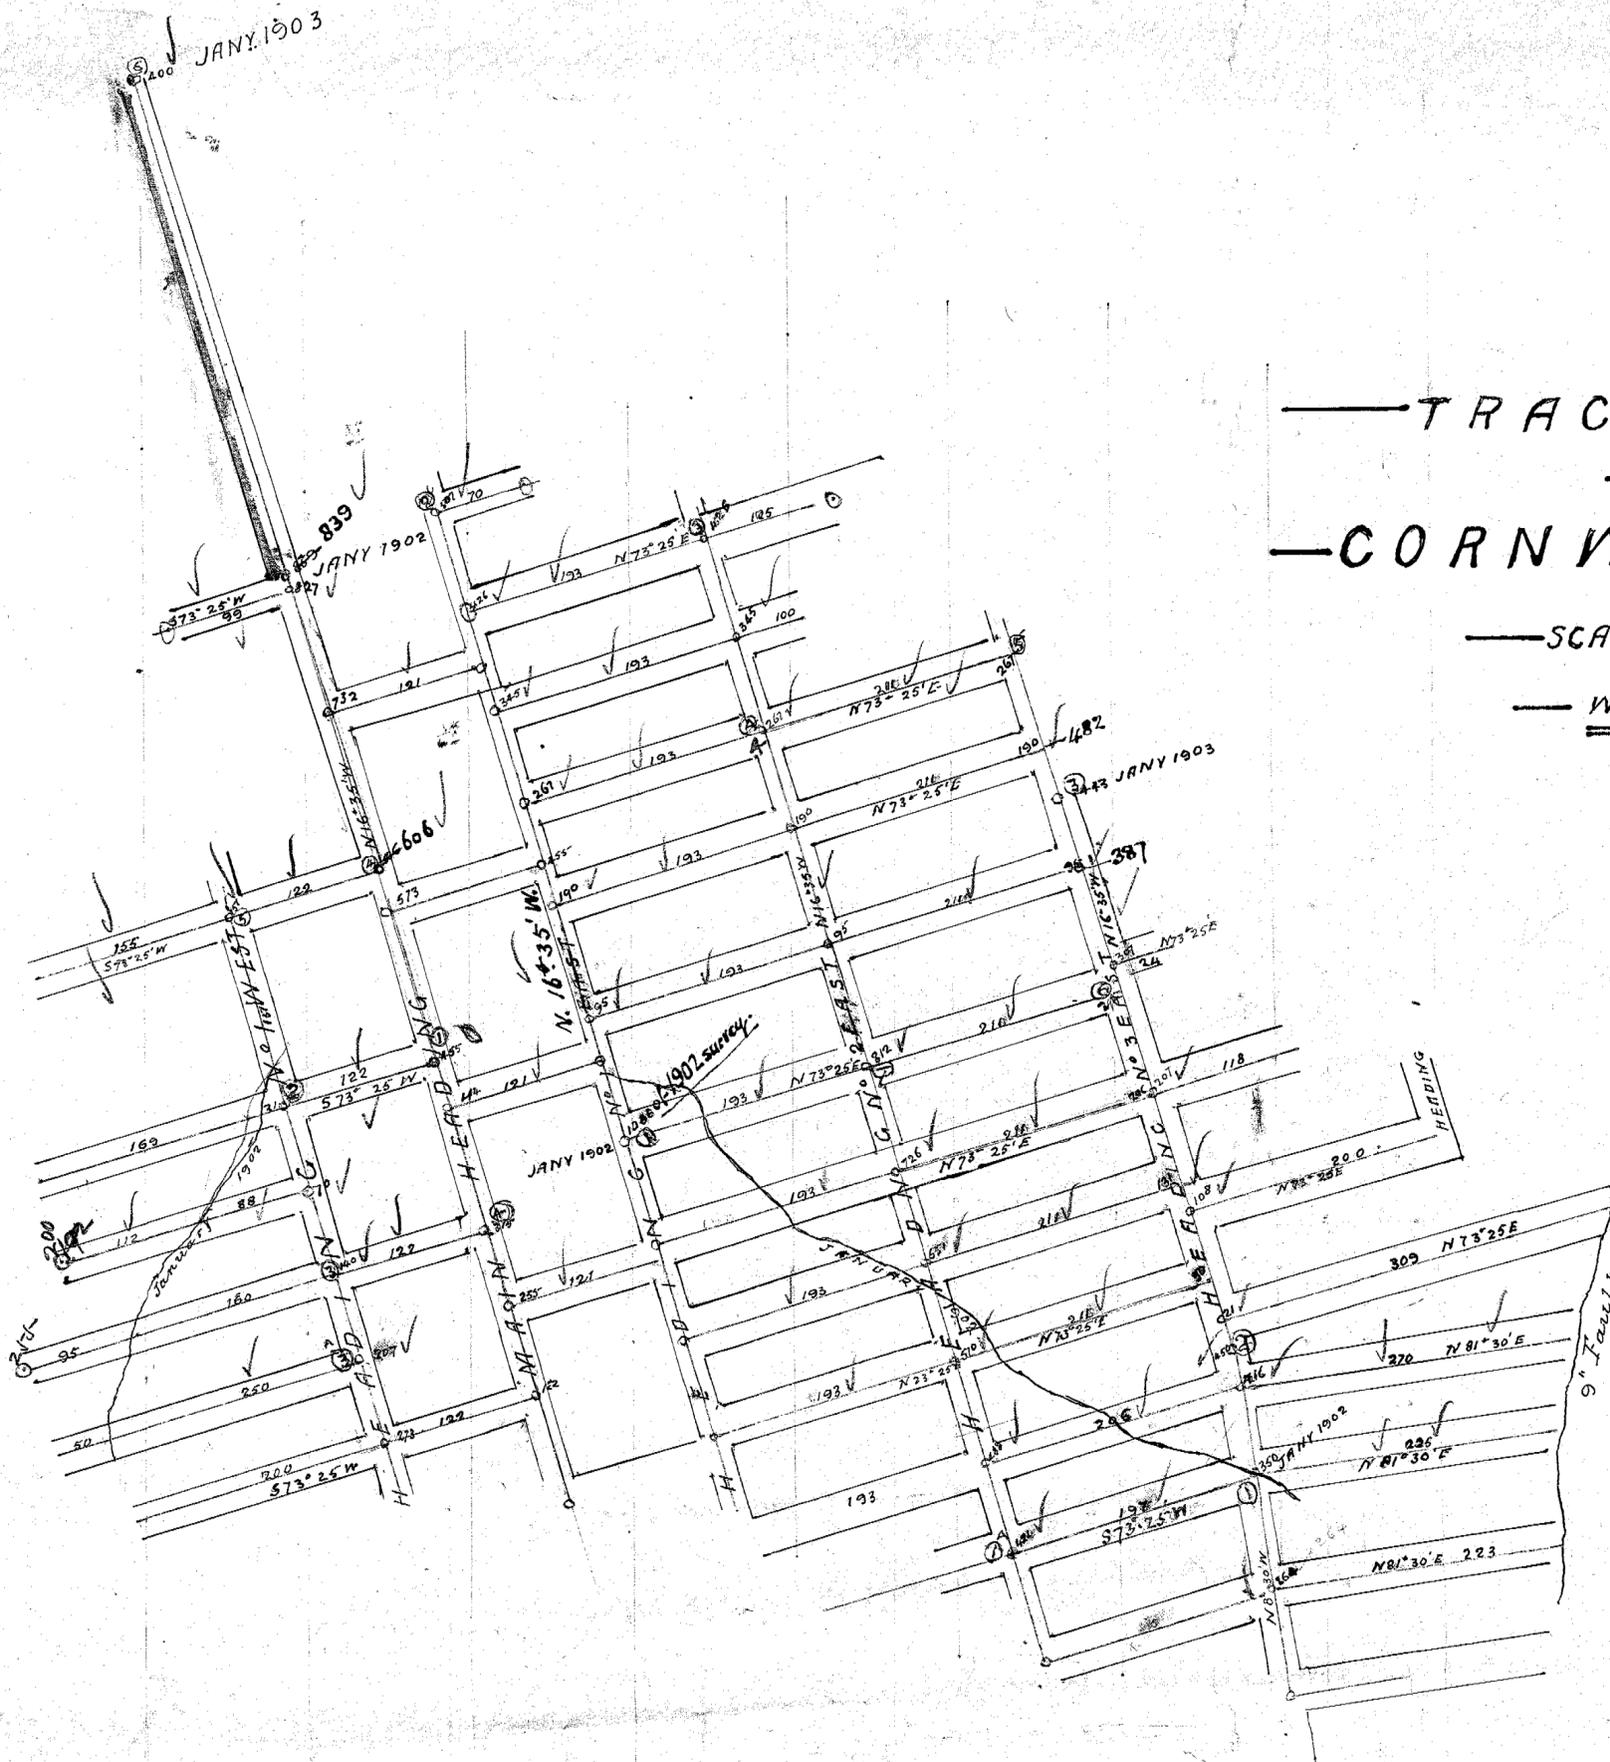

— TRACING OF SURVEY —  
— OF —  
— CORNWALL COLLIERY —  
— SCALE 1 CHAIN TO 1 INCH —  
— WORKINGS FOR 1902 —

W. S. Burrows  
Authorised Mining  
Surveyor  
9<sup>th</sup> Jany 1903  
Theodolite used

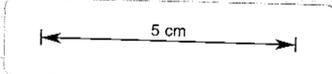