


Plan of  
 Extensions of Cornwall Coal Mine  
 For the year 1903  
 Scale 1 chain to 1 inch

MINES DEPARTMENT

Wm. J. Barrow  
 Authorised Surveyor  
 T. Woodhouse used



187-15  
 Cornwall Coal Mine

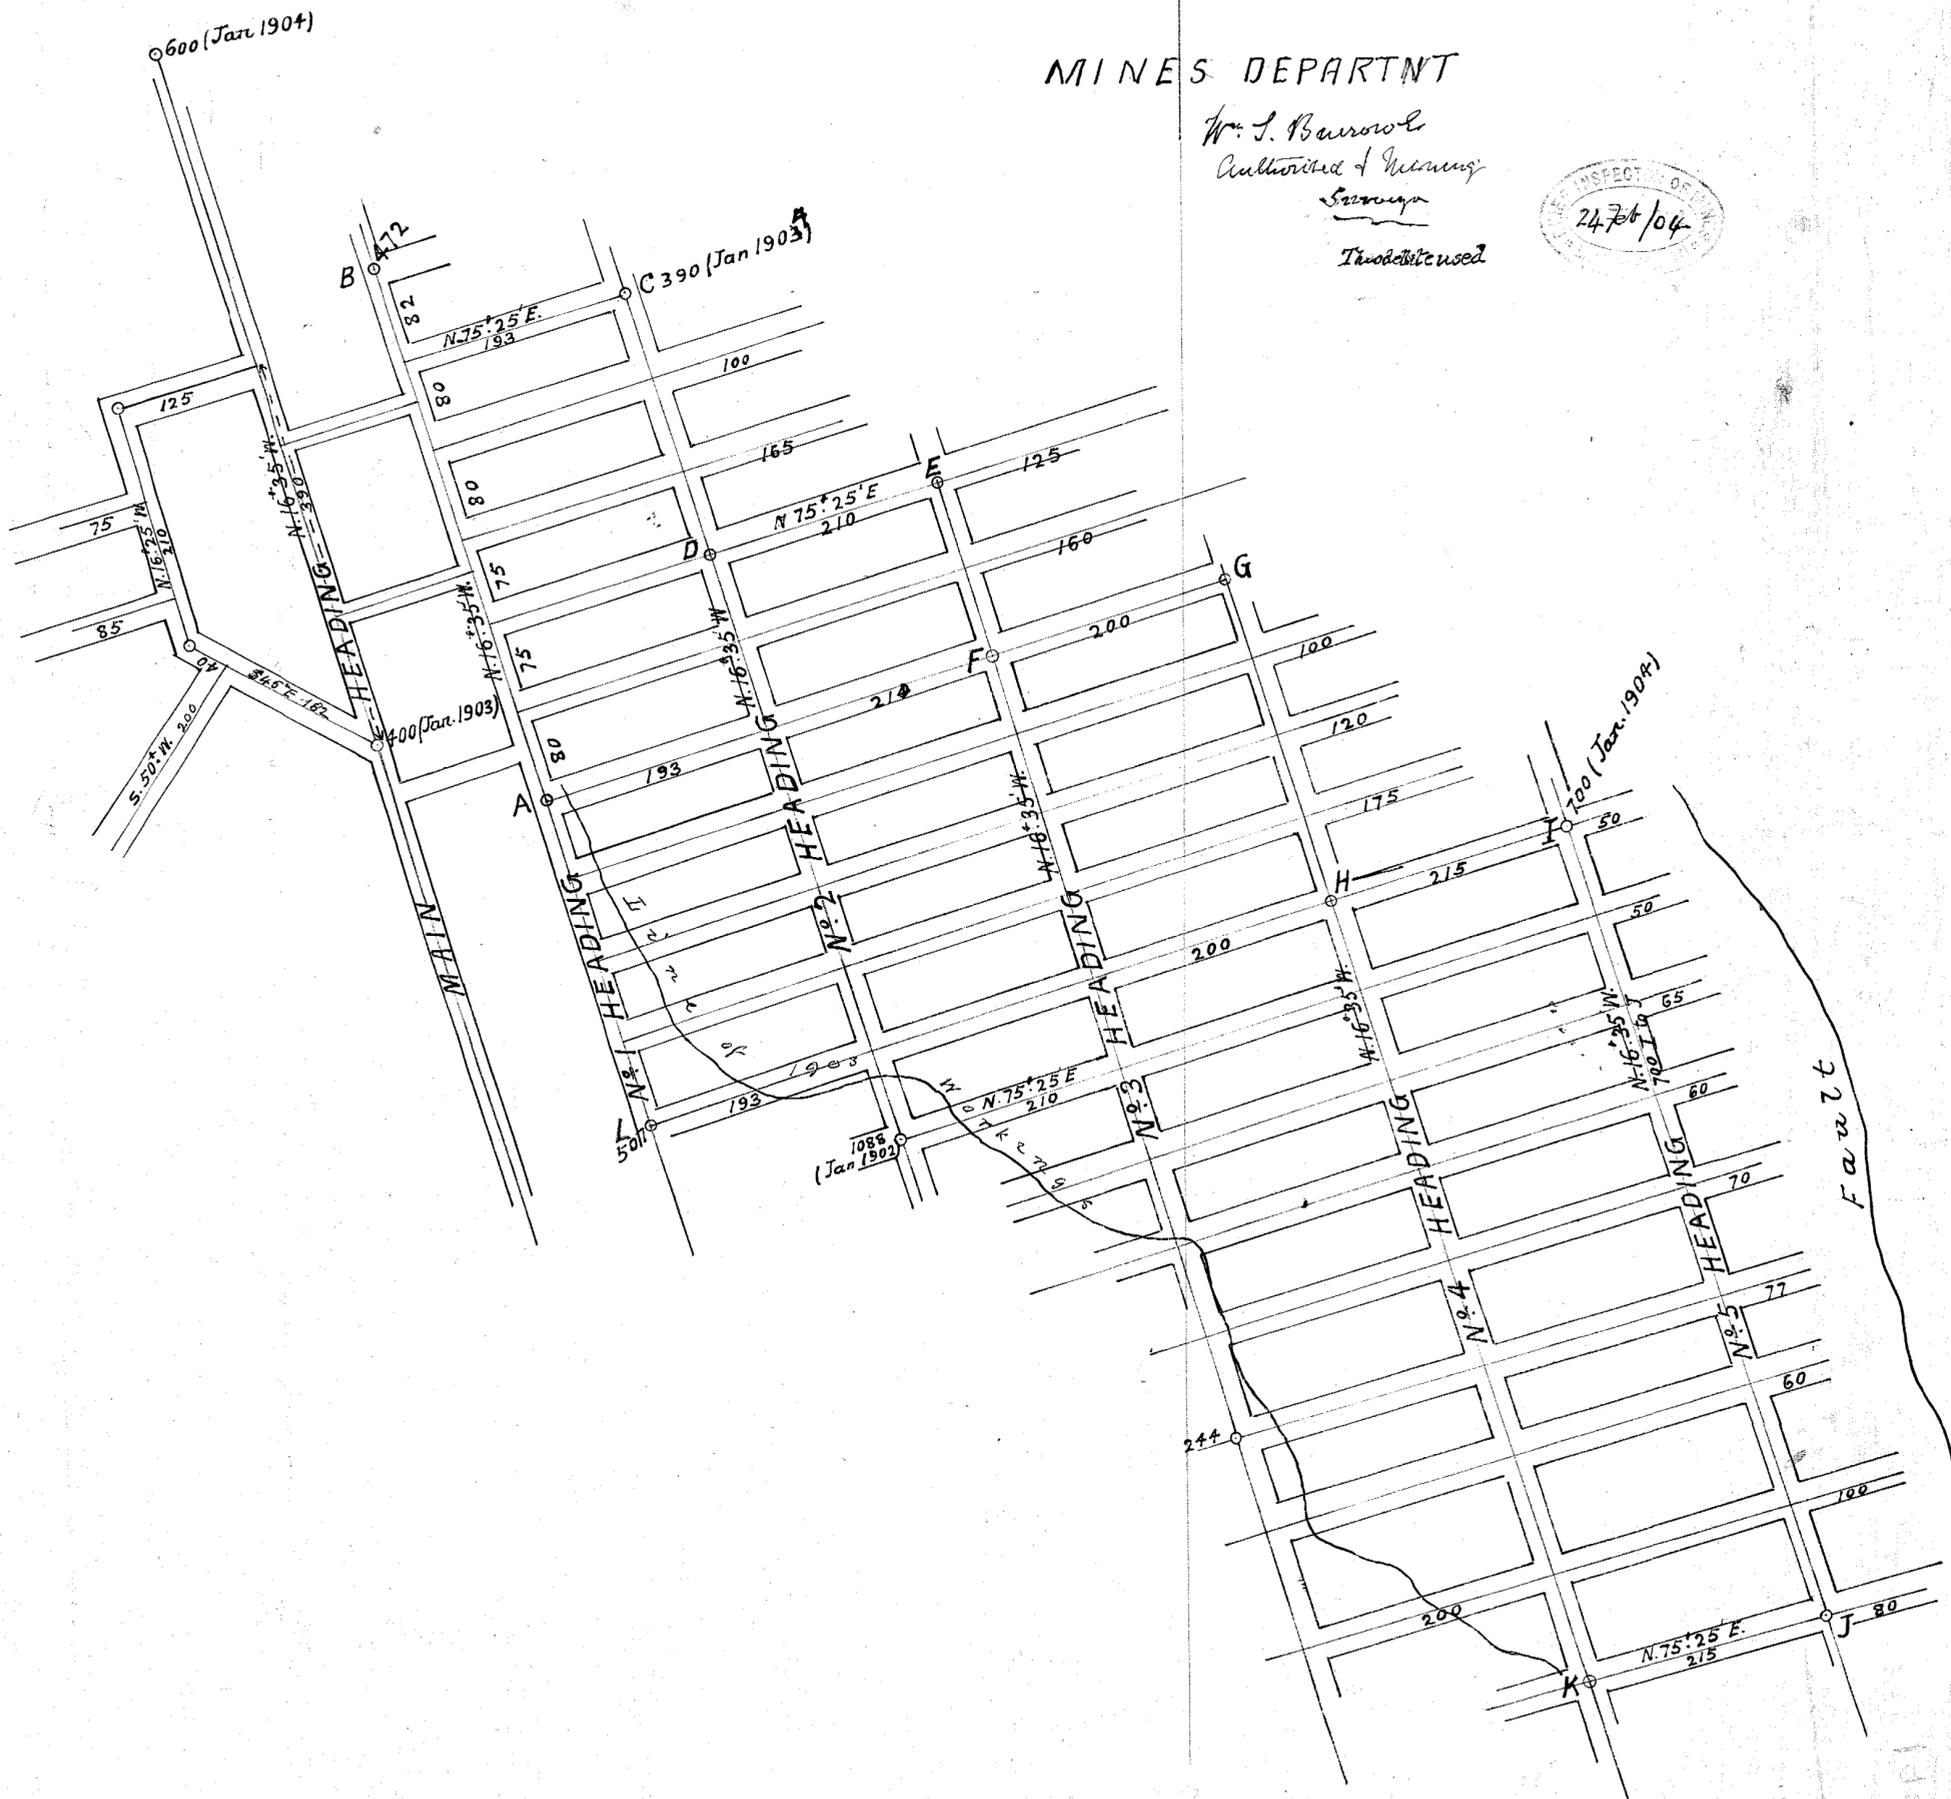

187-15  
 Wm. J. Barrow