


187-16
Jan 1905
C. B. B. B.

5 cm

187-16

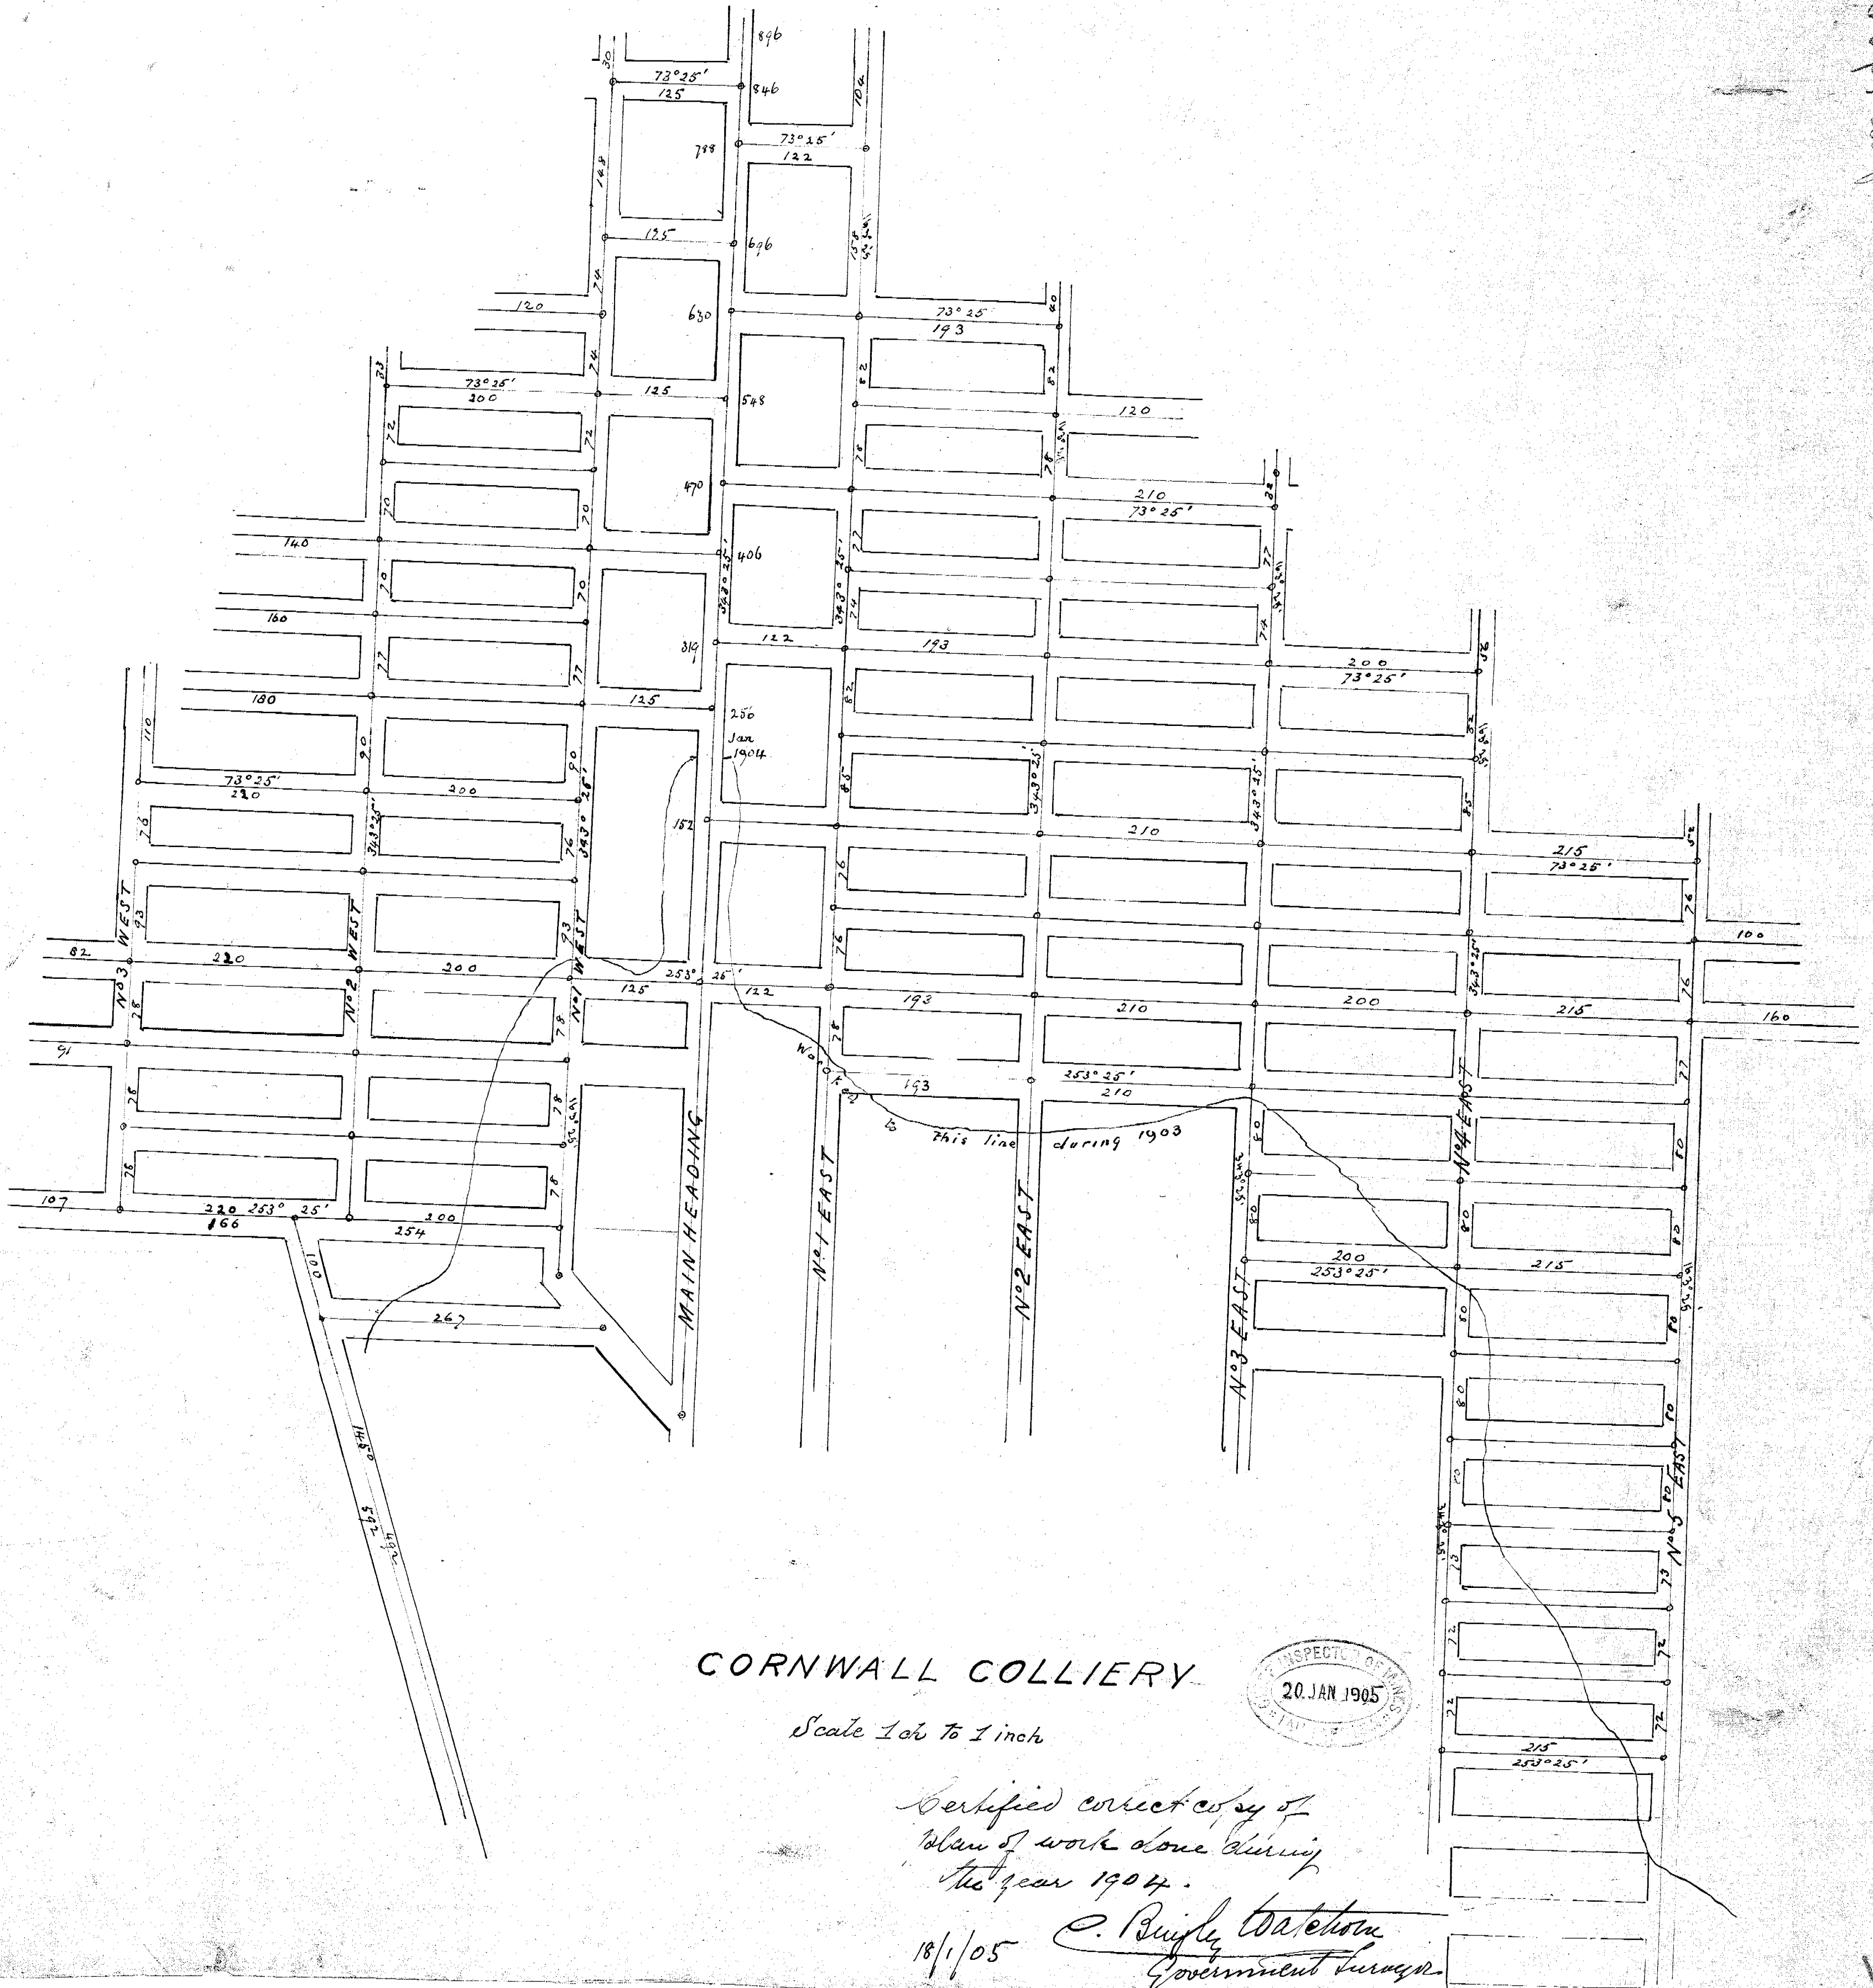

CORNWALL COLLIERY

Scale 1 in to 1 inch



Certified correct copy of
plan of work done during
the year 1904.

18/1/05 C. B. B. B.
Government Surveyor

187-16