

187-18

CORNWALL COLLIERY


Scale 1ch to 1inch

Showing work done during
the year 1906

C. Bingle, *Cartographer*
Government Surveyor
29/1/07

5 cm

187-18

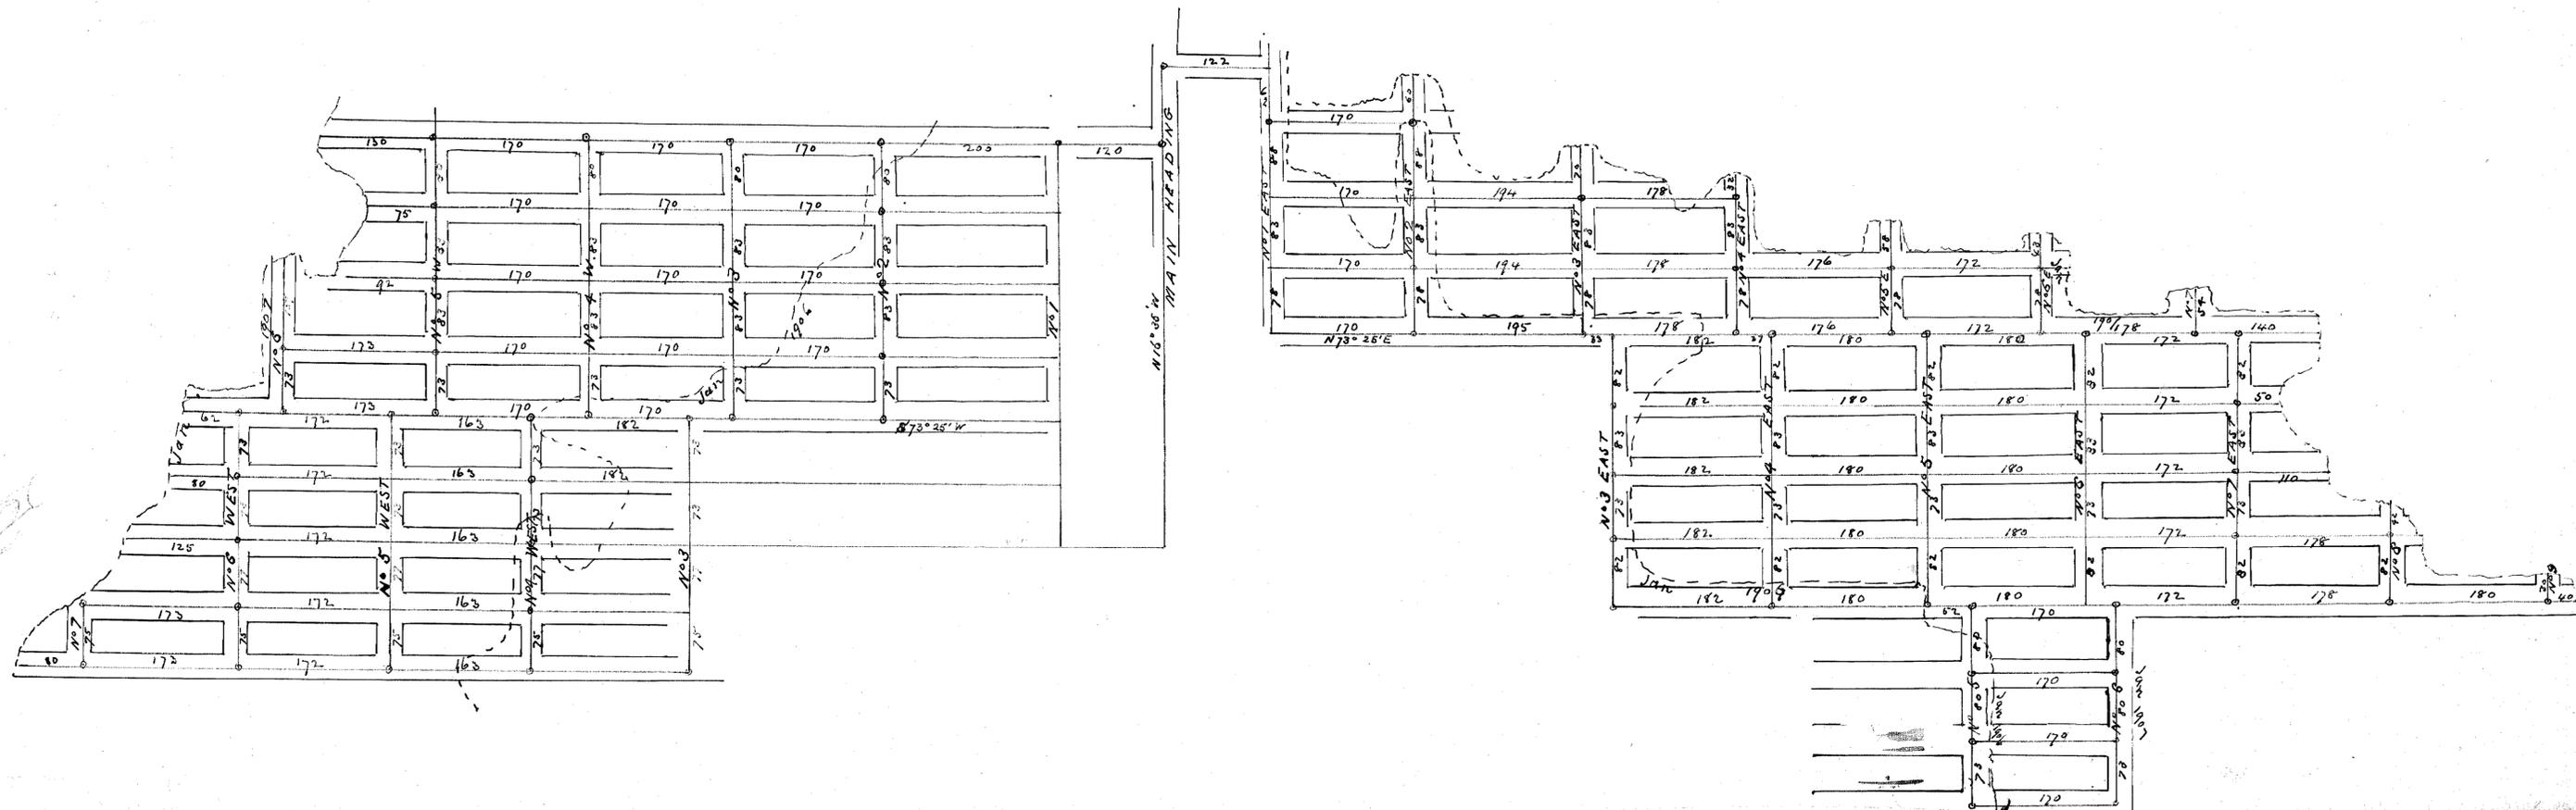

James Bingle