


CORNWALL C.C.

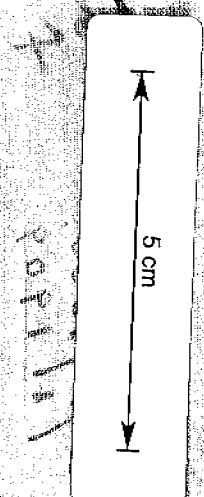

801 *mineral surveying*
187-20

Down Fault

Up Fault 4' 10"

Down Fault

MAIN HEADING

Jan 1908

No 4

No 3

No 2 West

No 1 West

Jan 1907

Jan 1906

*Work done during 1908
Copied from newspapers
Plan mine abandoned
C. Beagle, Watchman
God. Luregh
20.12.08*

187-20