


187-25

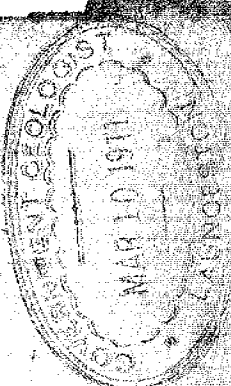

CORNWALL COLLIERY

Scale 1 ch. = 1 inch

Certified Copy of Work done
during year 1910. Surveyed
with theodolite & compass.
C. P. W. W. W. W. C. E.
C. P. L. S. A.

Wagon Road
Dip 2 1/2° N.E.
Cornwall Colliery
187-25