


187-27

187-27

5 cm

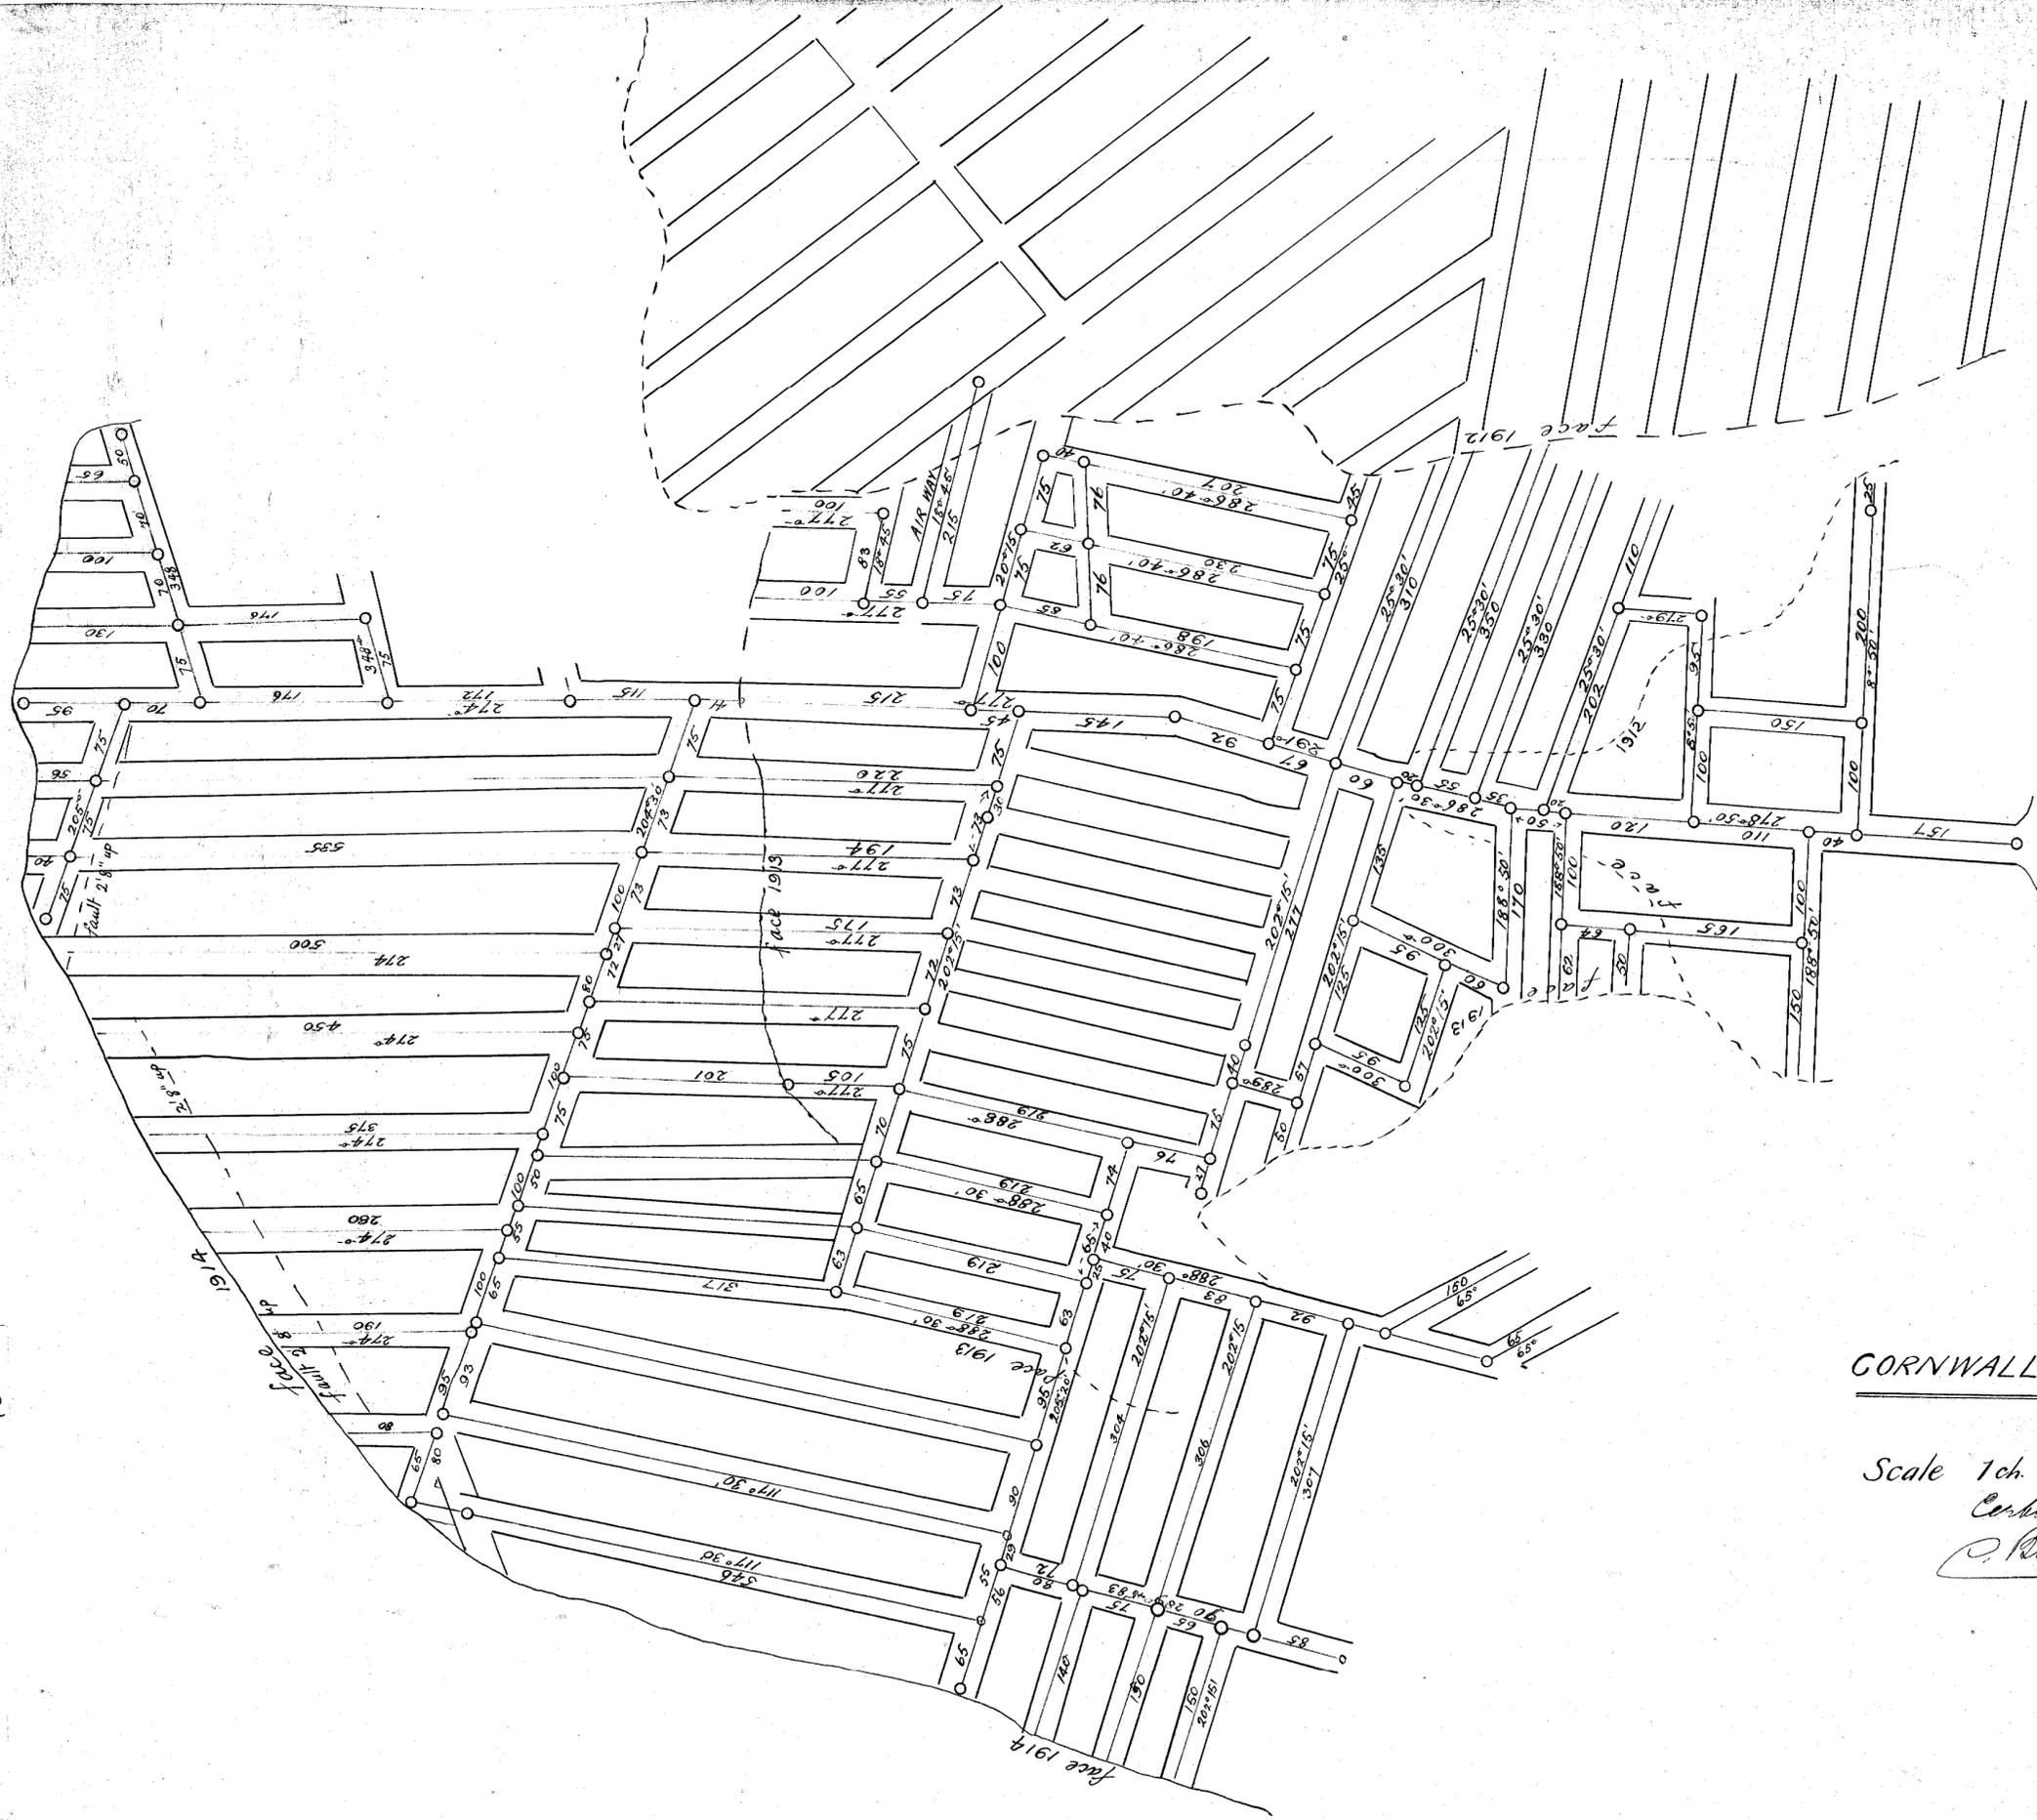

CORNWALL COLLIERY

Scale 1ch. to 1inch  
 Certified correct copy of work done during 1913  
 by C. R. King & Co. Ltd. Survey with theodolite when  
 purchased & compared for Cross  
 drives.

187