


5 cm

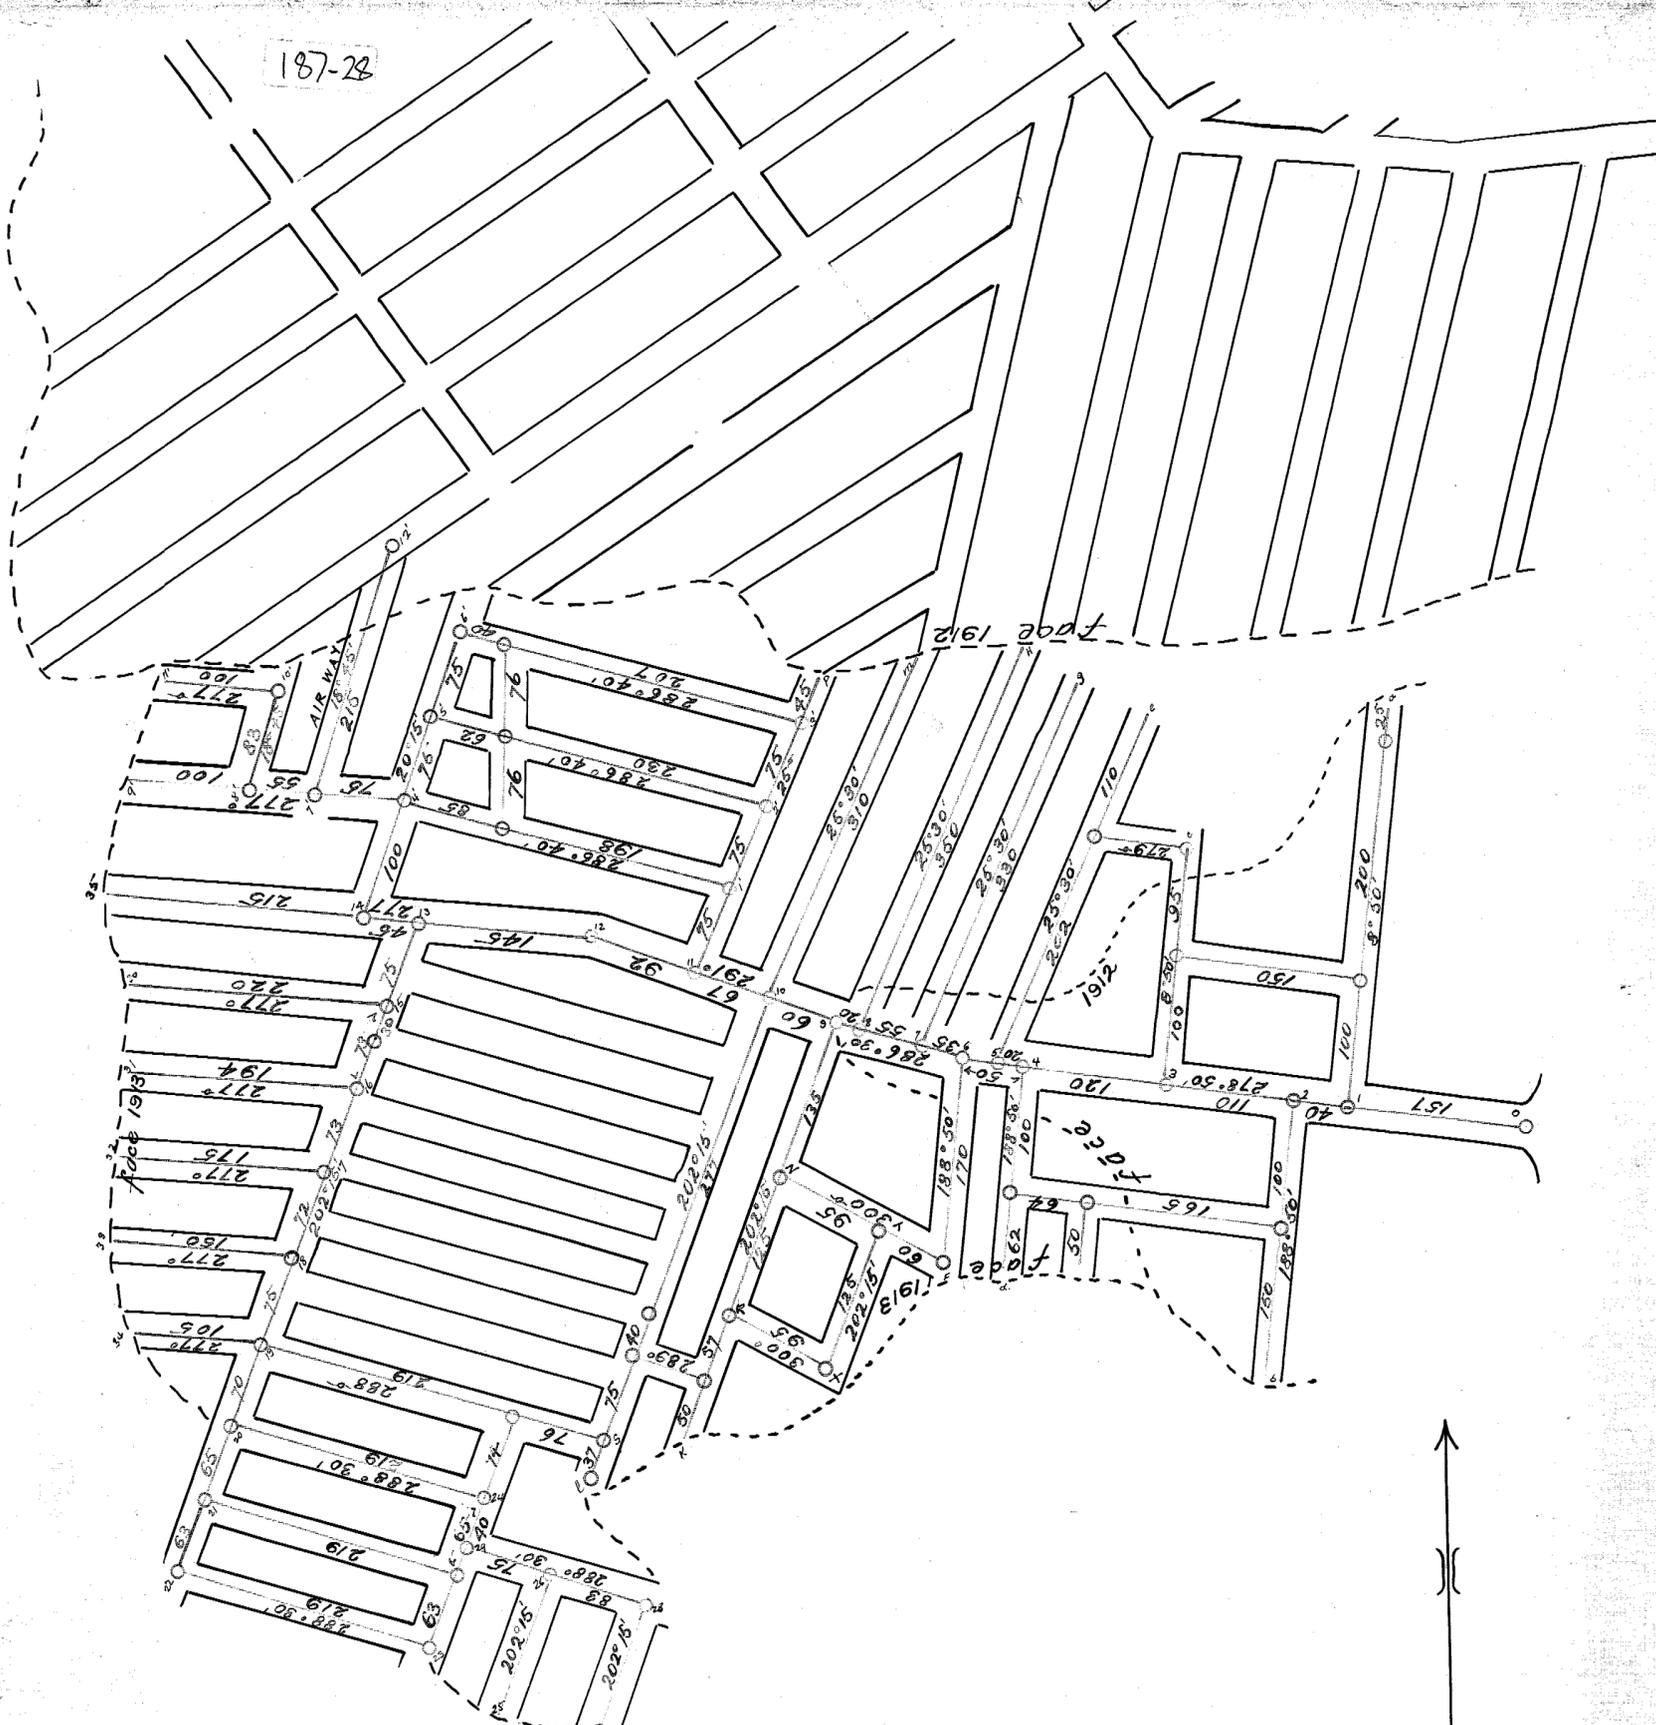

187  
 Cornwall  
 Colliery

# CORNWALL COLLIERY

Scale 1ch. to 1in



Certified correct copy of  
 work done during 1912  
 survey by theodolite & compass  
 by C. P. B. [Signature]  
 14.2.13

191  
 3  
 8