


5 cm

187-21

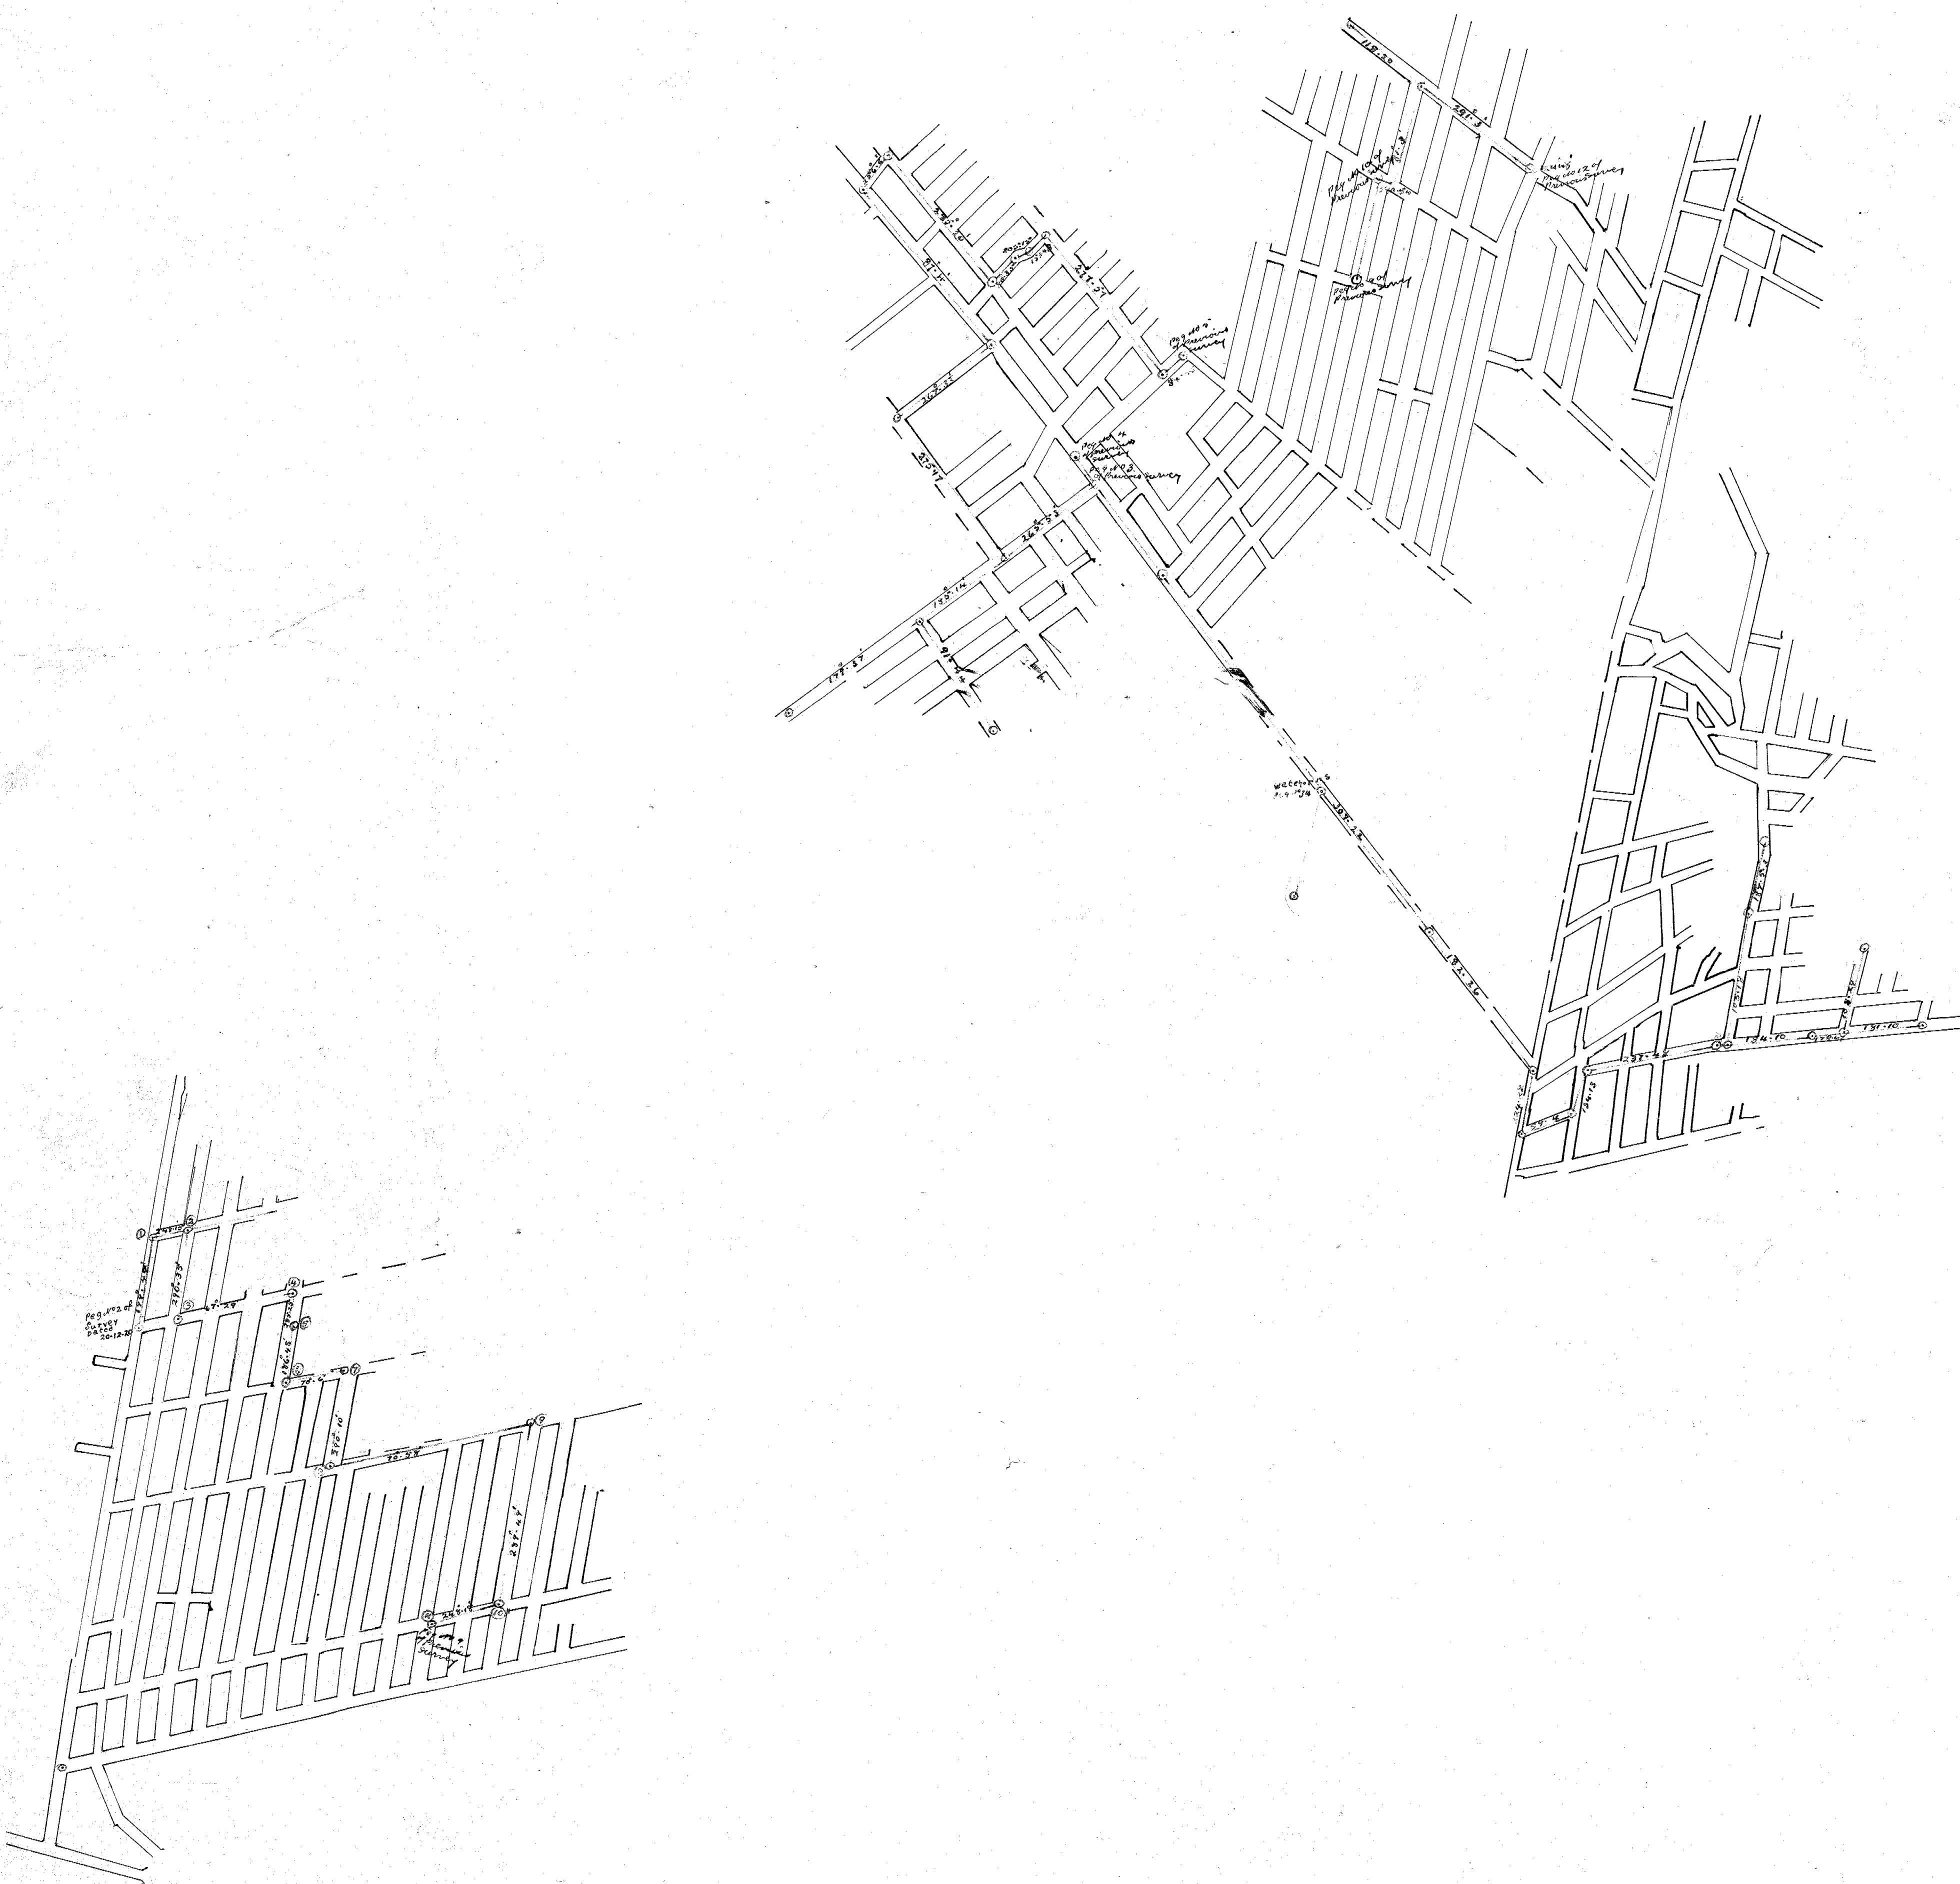

Survey made with theodolite
PLAN of Cornwall Battery workings to 31st December 1921. Certified correct
S. J. Hood Battery Manager
Cornwall Tasmania

Fig. 1
8/26/22