
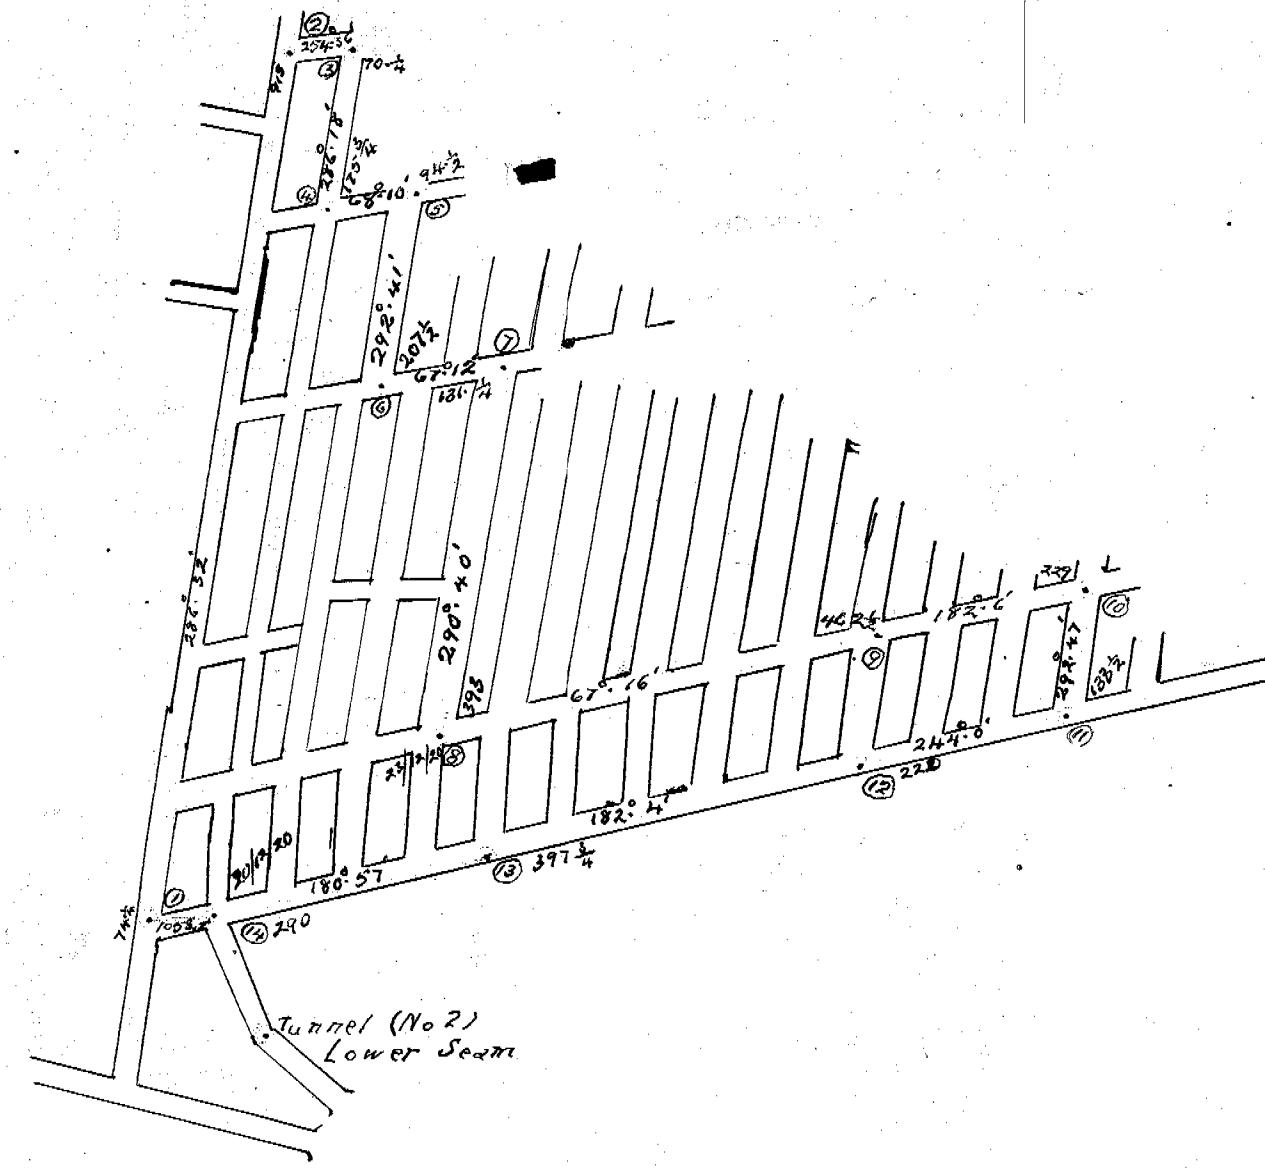


5 cm

187-32

PLAN of Cornwall killing workings
scamped with the date by C.S. & Hood killing manager
and certified as correct by C.S. & Hood killing manager
of Cornwall

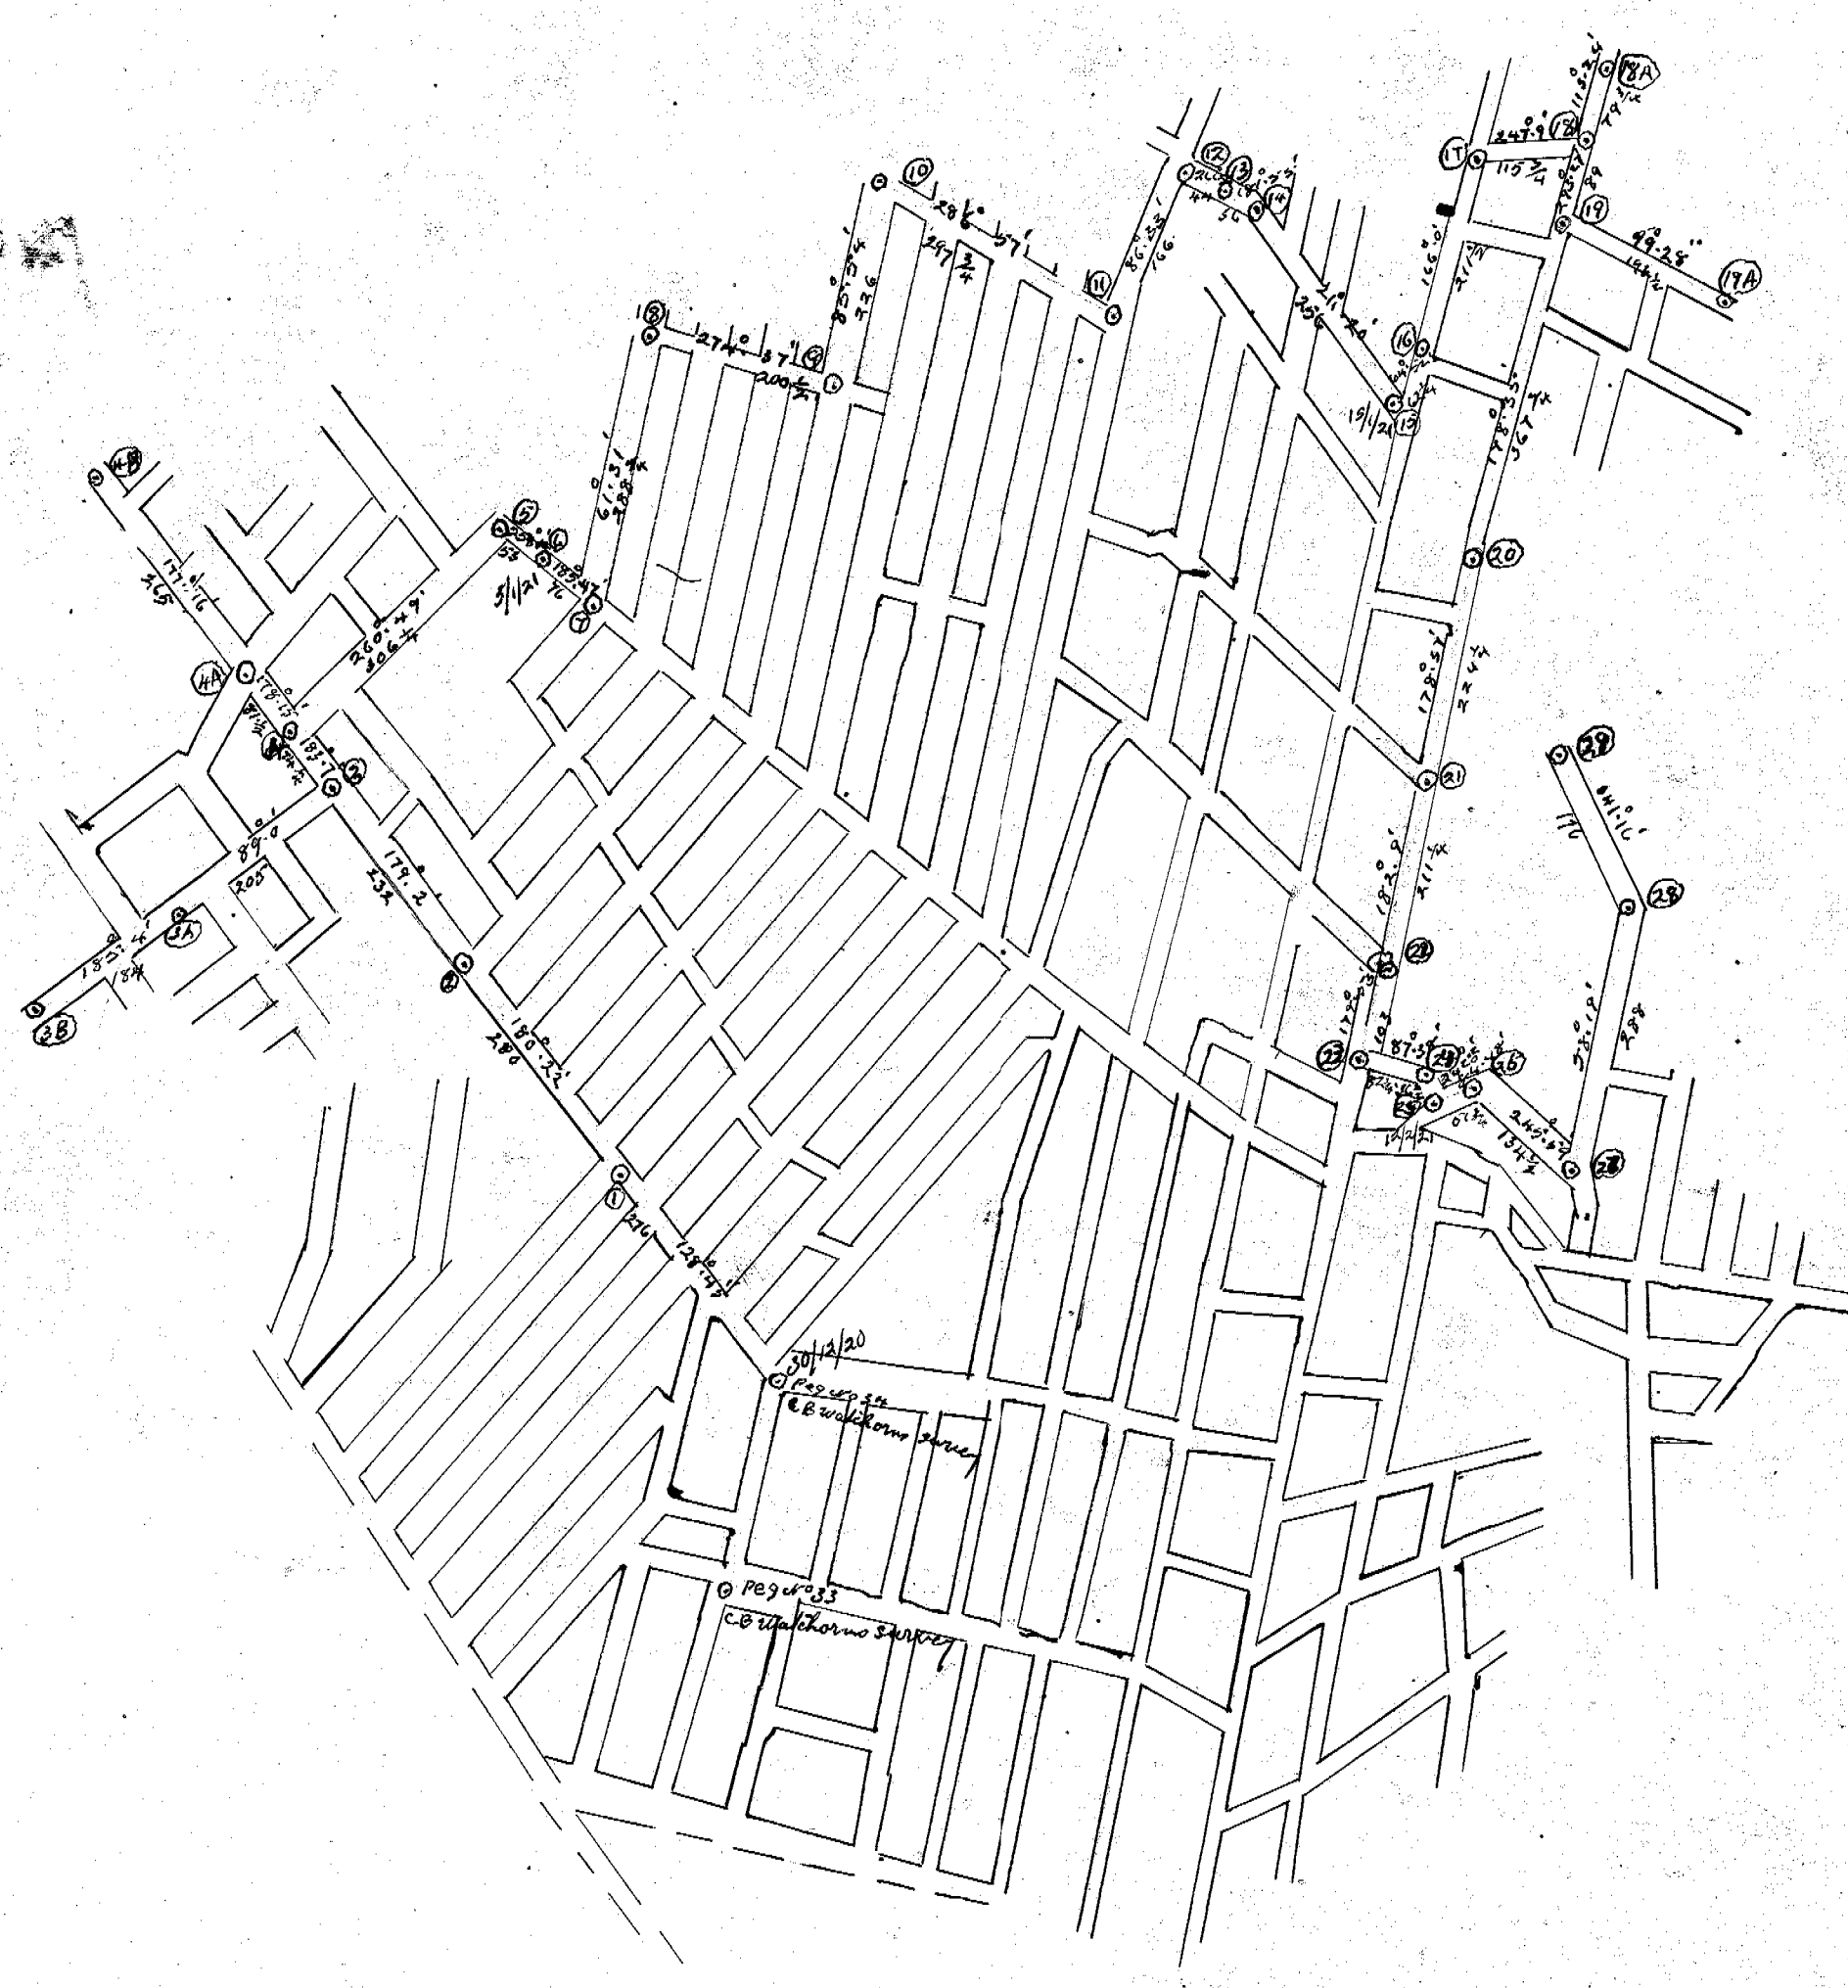

CORNWALL