
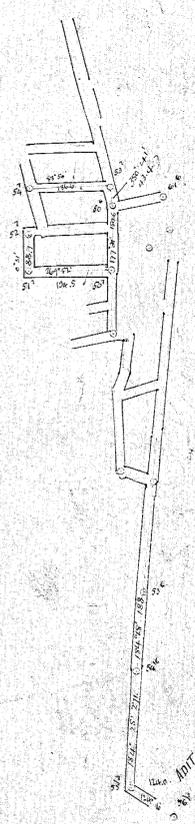
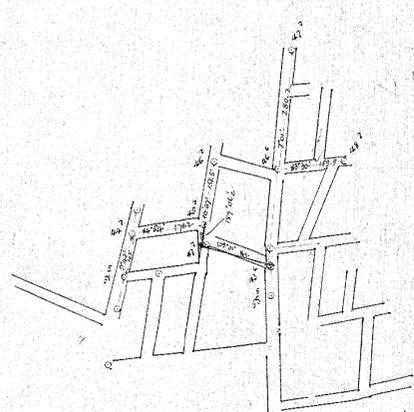


5 cm

187-33

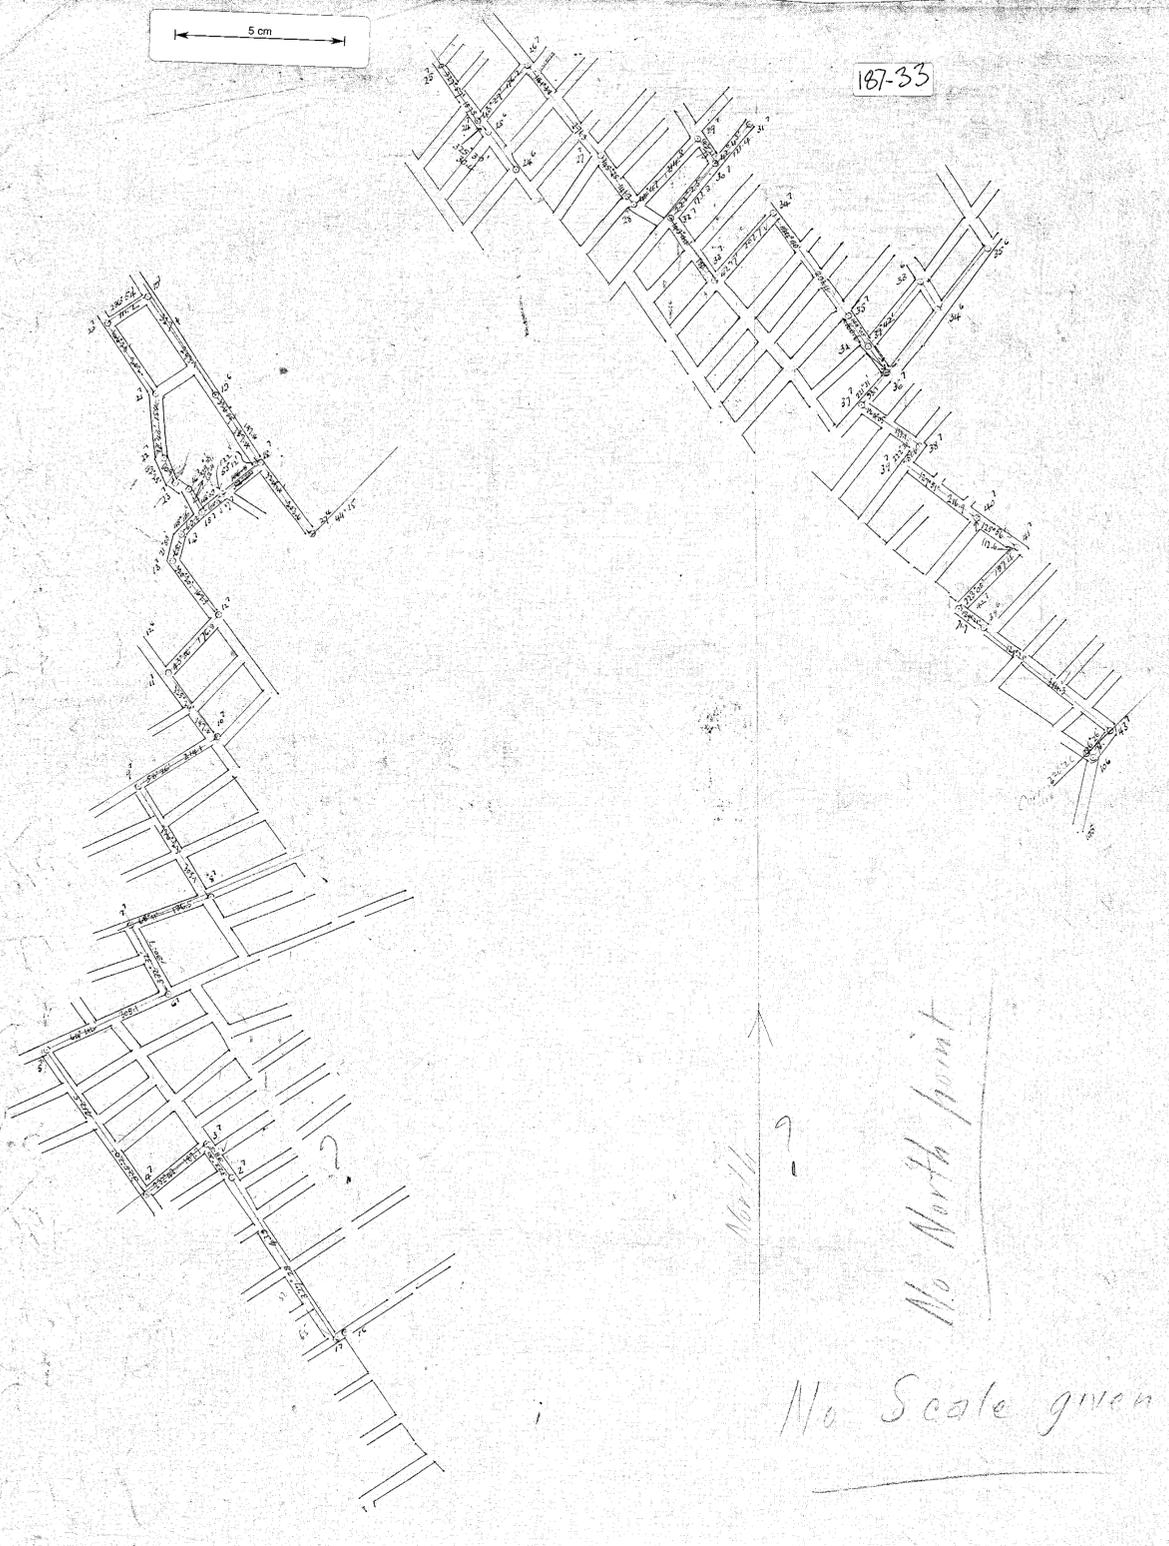

North  
 No North point  
 No Scale given

Additions to CORNWALL COLLIERY 1926-1927  
 Surveyed with 5" theodolite 4 Jan. 1927  
 Lance Colours  
 A. H. T. Surveyor