




187-38

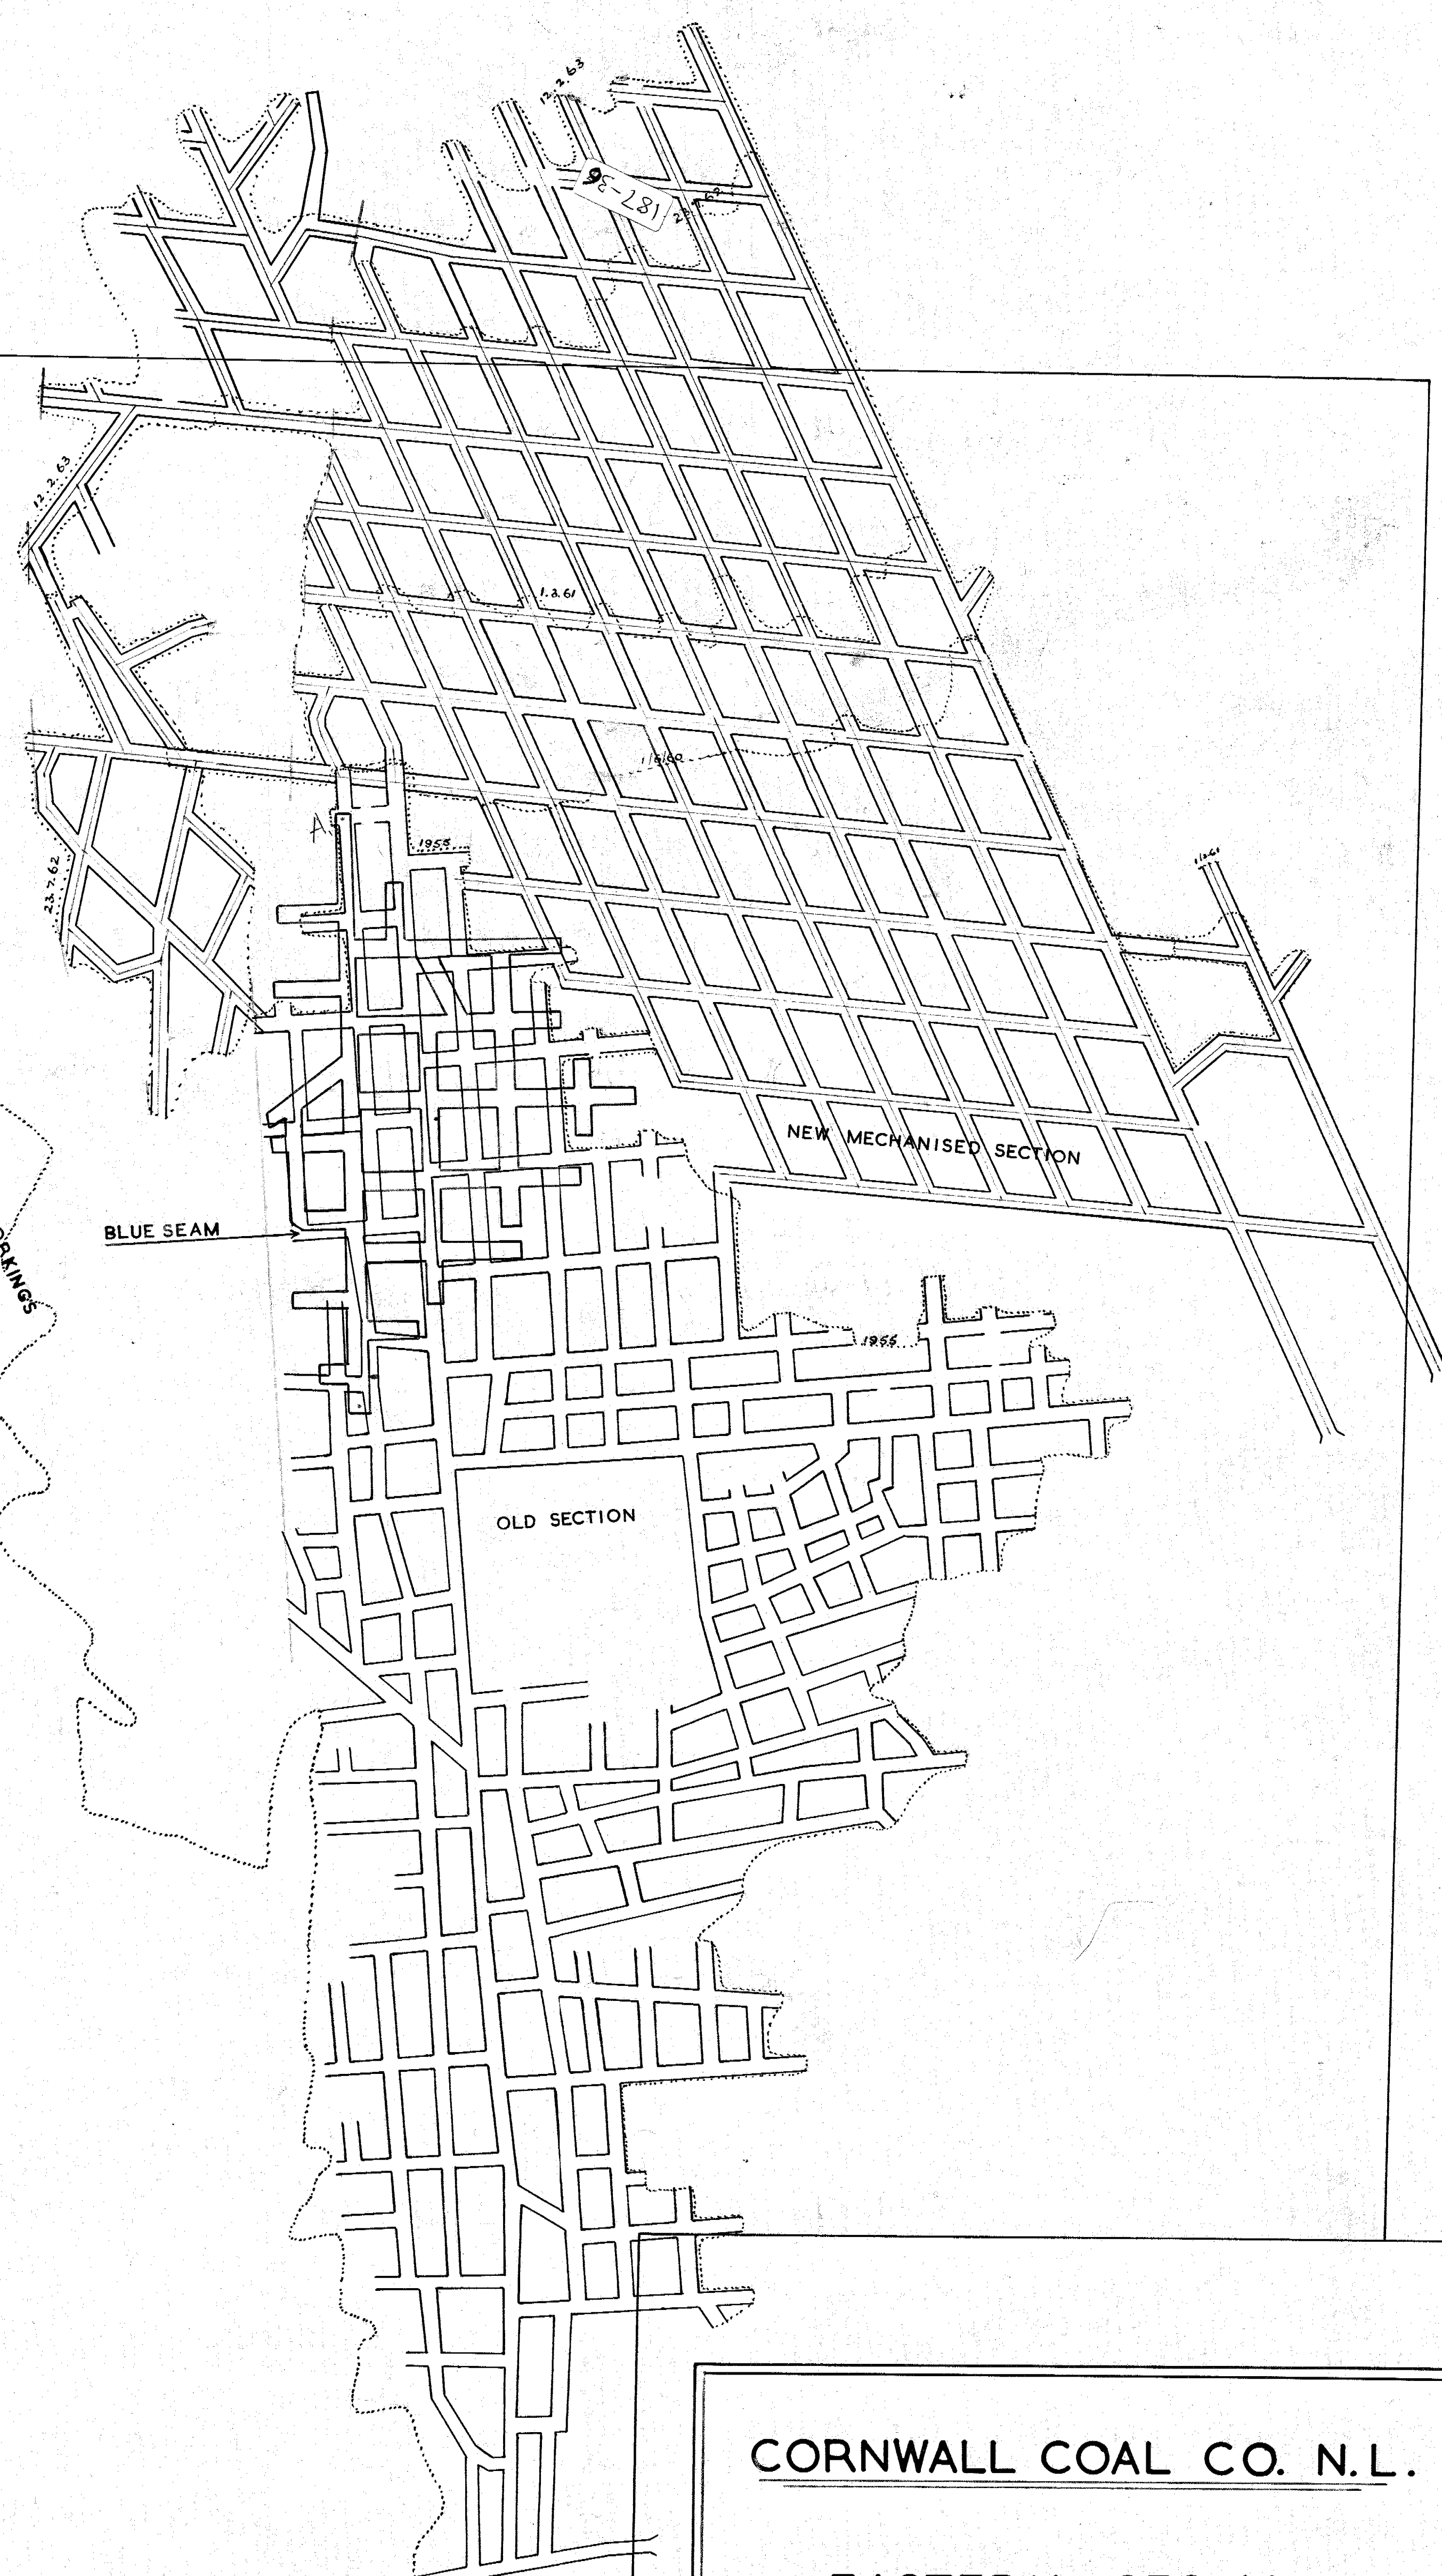

EASTERN - SECTION

SCALE 2 CHAINS TO AN INCH

L.H.GATTY. C.C.C.

COMPLETE SECTION ABANDONED 31.1.1964 L.H.G.