



0187-049

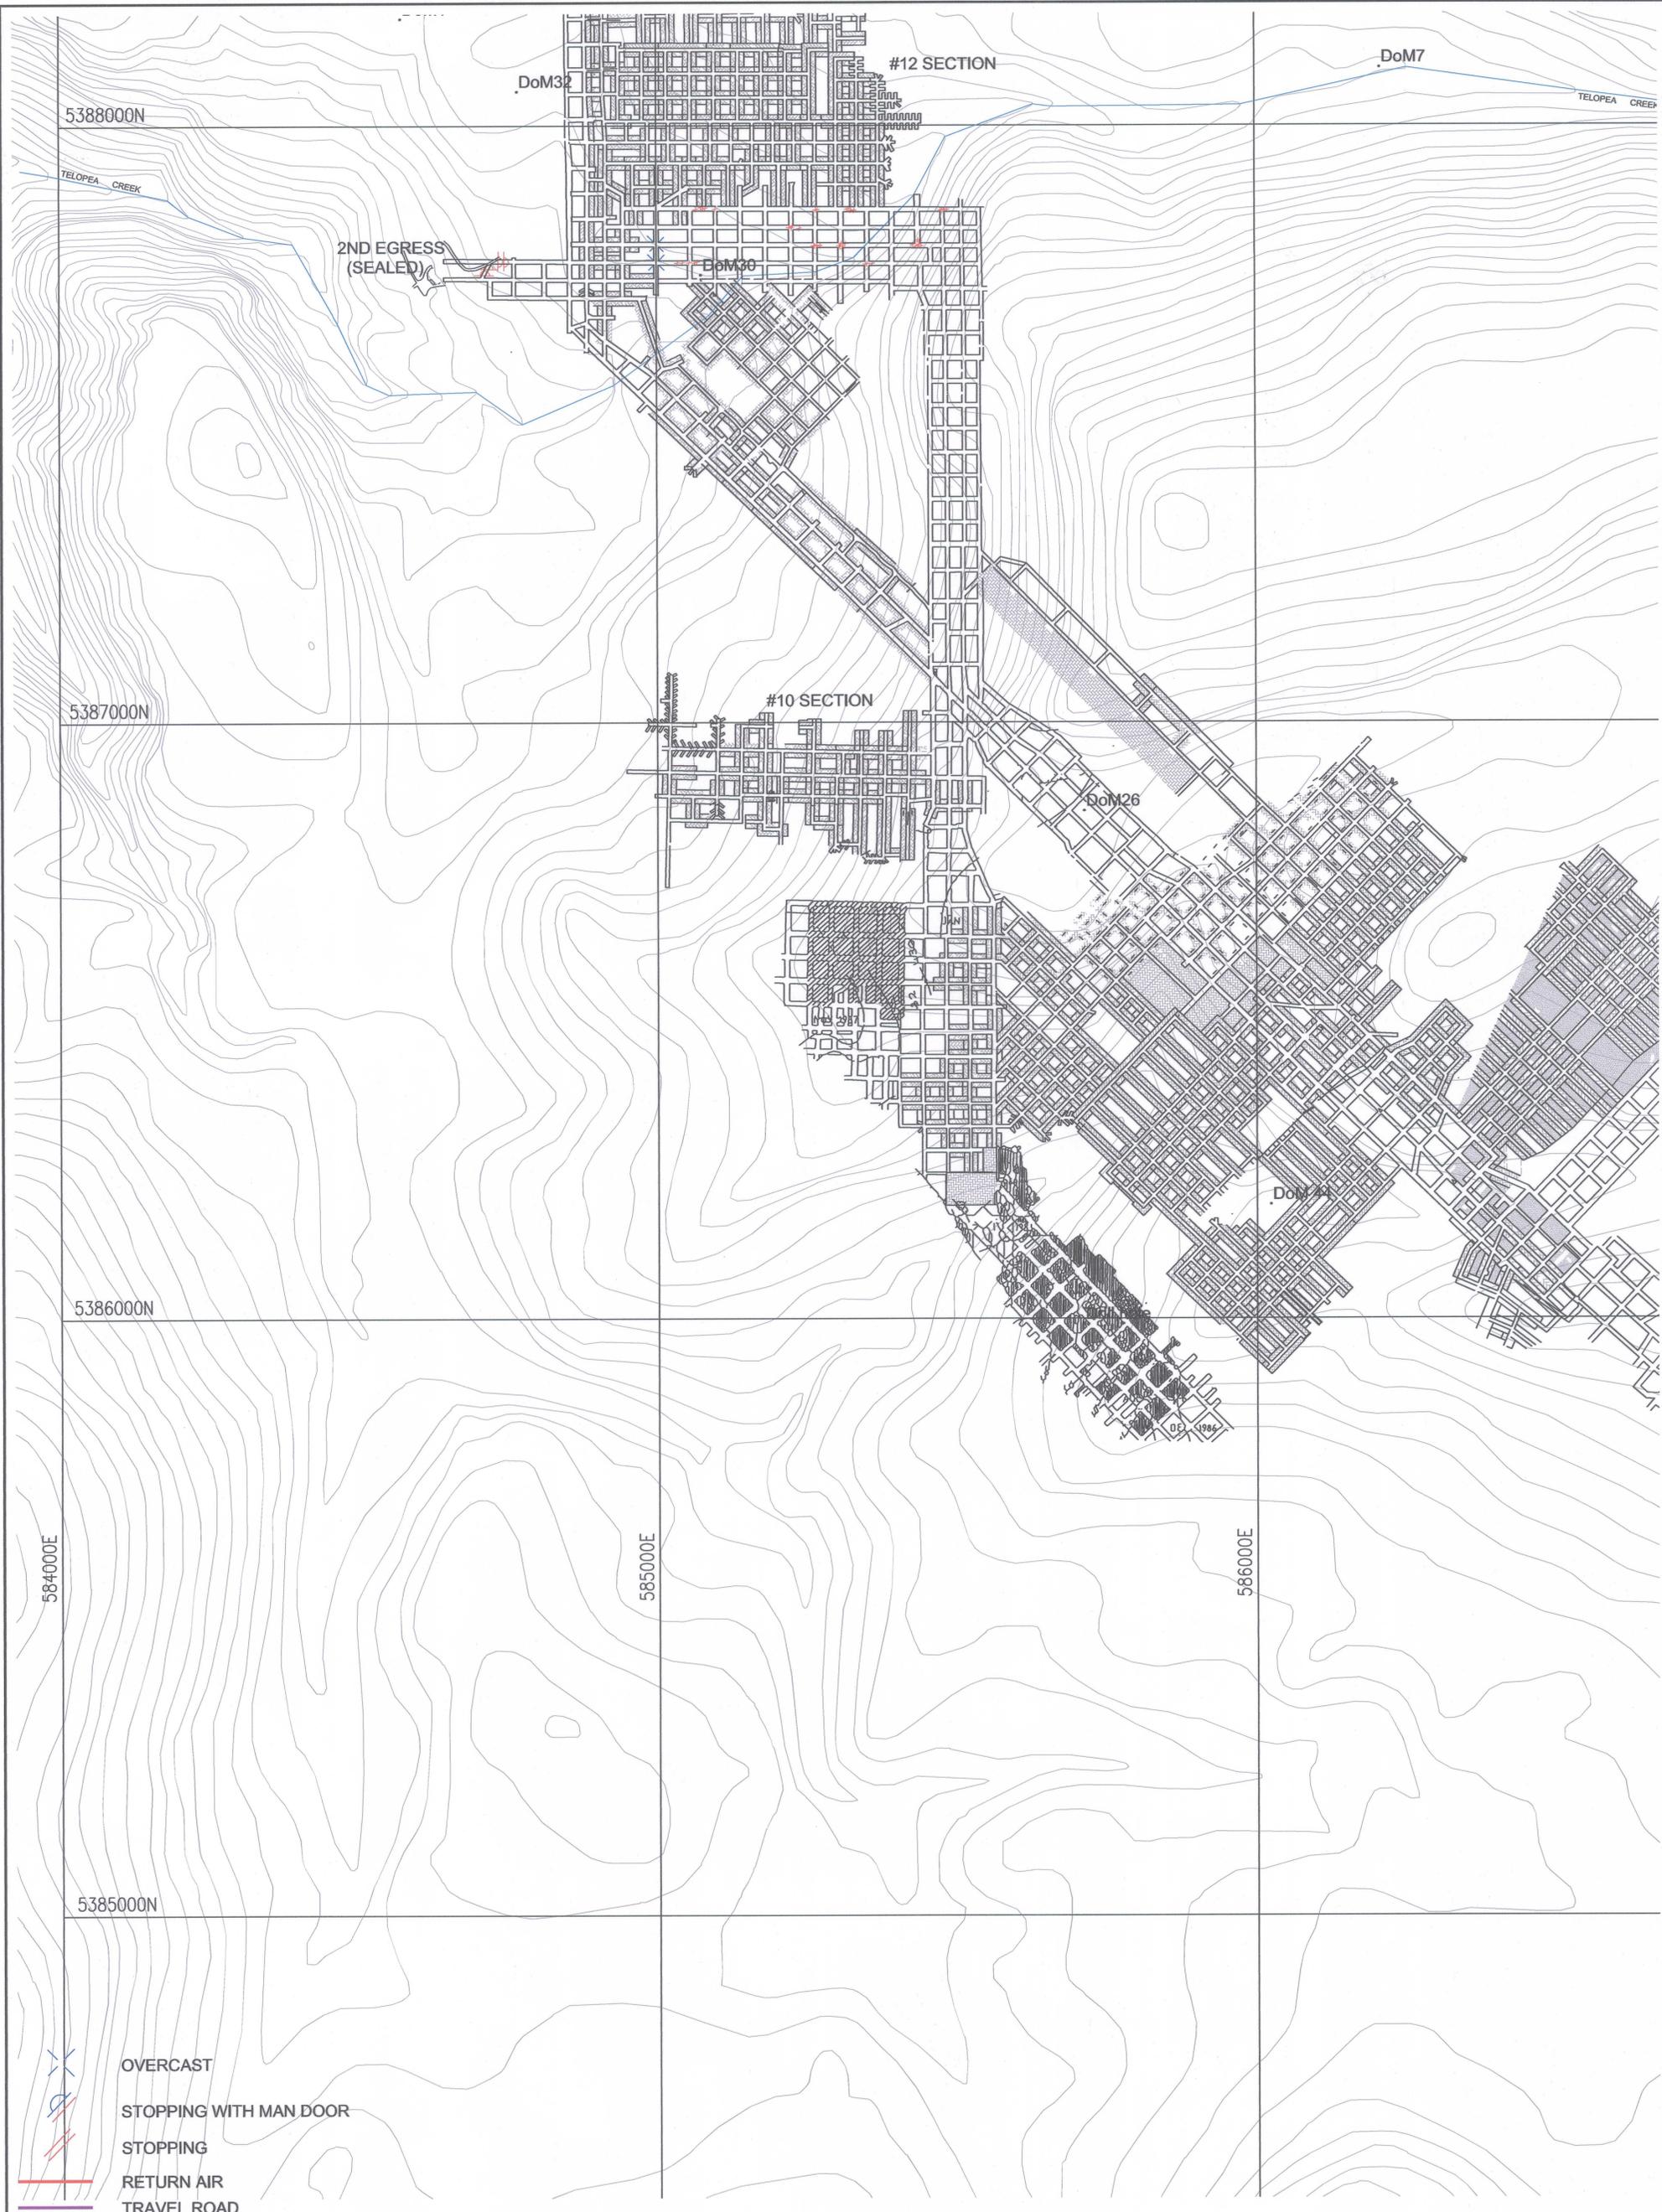

- OVERCAST
- STOPPING WITH MAN DOOR
- STOPPING
- RETURN AIR
- TRAVEL ROAD
- BELT ROAD

This Schematic Plan is compiled from scanned historical data, some surveyed headings & diagrams supplied by Cornwall Coal N/L.

NOTES:
 1. Extents of workings derived from digitized hardcopy plans of old historic workings as available and survey measurement of modern workings.
 Relative positions +/- 2 metres, absolute positions +/- 15 metres. The full extent of underground workings is unknown, and this plan is based only on the historical data available and survey of modern workings, plus diagrams supplied by Cornwall Coal N/L.

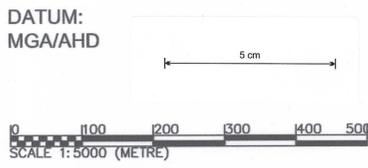

SURVEY RESOURCES Land, Engineering & Mining Surveyors

26 Holbrook St. Inveresk PO Box 1192 Launceston Tasmania 7250
 Telephone: (03) 6331 5721 Facsimile: (03) 6331 5741 Email: admin@surveyresources.com.au

SCALE:	1:5000 AT A1
DRAWN:	CLP, NP
SURVEYED:	C. Pedersen & others
DATE:	11/12/2012

CORNWALL COAL
 MRT ANNUAL RETURN 2012
 EXISTING WORKINGS AS AT 12/2012
 (MINE CLOSURE)
DUNCAN COLLIERY

REFERENCE:
 06.001
 GCV72
V02