
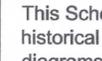
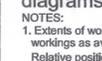


-  OVERCAST
-  STOPPING WITH MAN DOOR
-  STOPPING
-  RETURN AIR
-  TRAVEL ROAD
-  BELT ROAD

This Schematic Plan is compiled from scanned historical data, some surveyed headings & diagrams supplied by Cornwall Coal N/L.

NOTES:
 1. Extents of workings derived from digitized hardcopy plans of old historic workings as available and survey measurement of modern workings.
 Relative positions +/- 2 metres, absolute positions +/- 15 metres. The full extent of underground workings is unknown, and this plan is based only on the historical data available and survey of modern workings, plus diagrams supplied by Cornwall Coal N/L.

DATUM: MGA/AHD

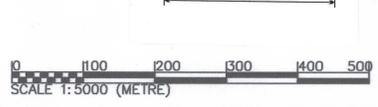

SURVEY RESOURCES Land, Engineering & Mining Surveyors

26 Holbrook St. Inveresk
 PO Box 1192
 Launceston
 Tasmania 7250

Telephone: (03) 6331 5721
 Facsimile: (03) 6331 5741
 Email: admth@surveyresources.com.au

SCALE:	1:5000 AT A1
DRAWN:	CLP, NP
SURVEYED:	C. Pedersen & others
DATE:	11/12/2012

CORNWALL COAL
 MRT ANNUAL RETURN 2012
 EXISTING WORKINGS AS AT 12/2012
 (MINE CLOSURE)
DUNCAN COLLIERY

REFERENCE:
 06.001
 GCV72
 V03