


BRUNNEN

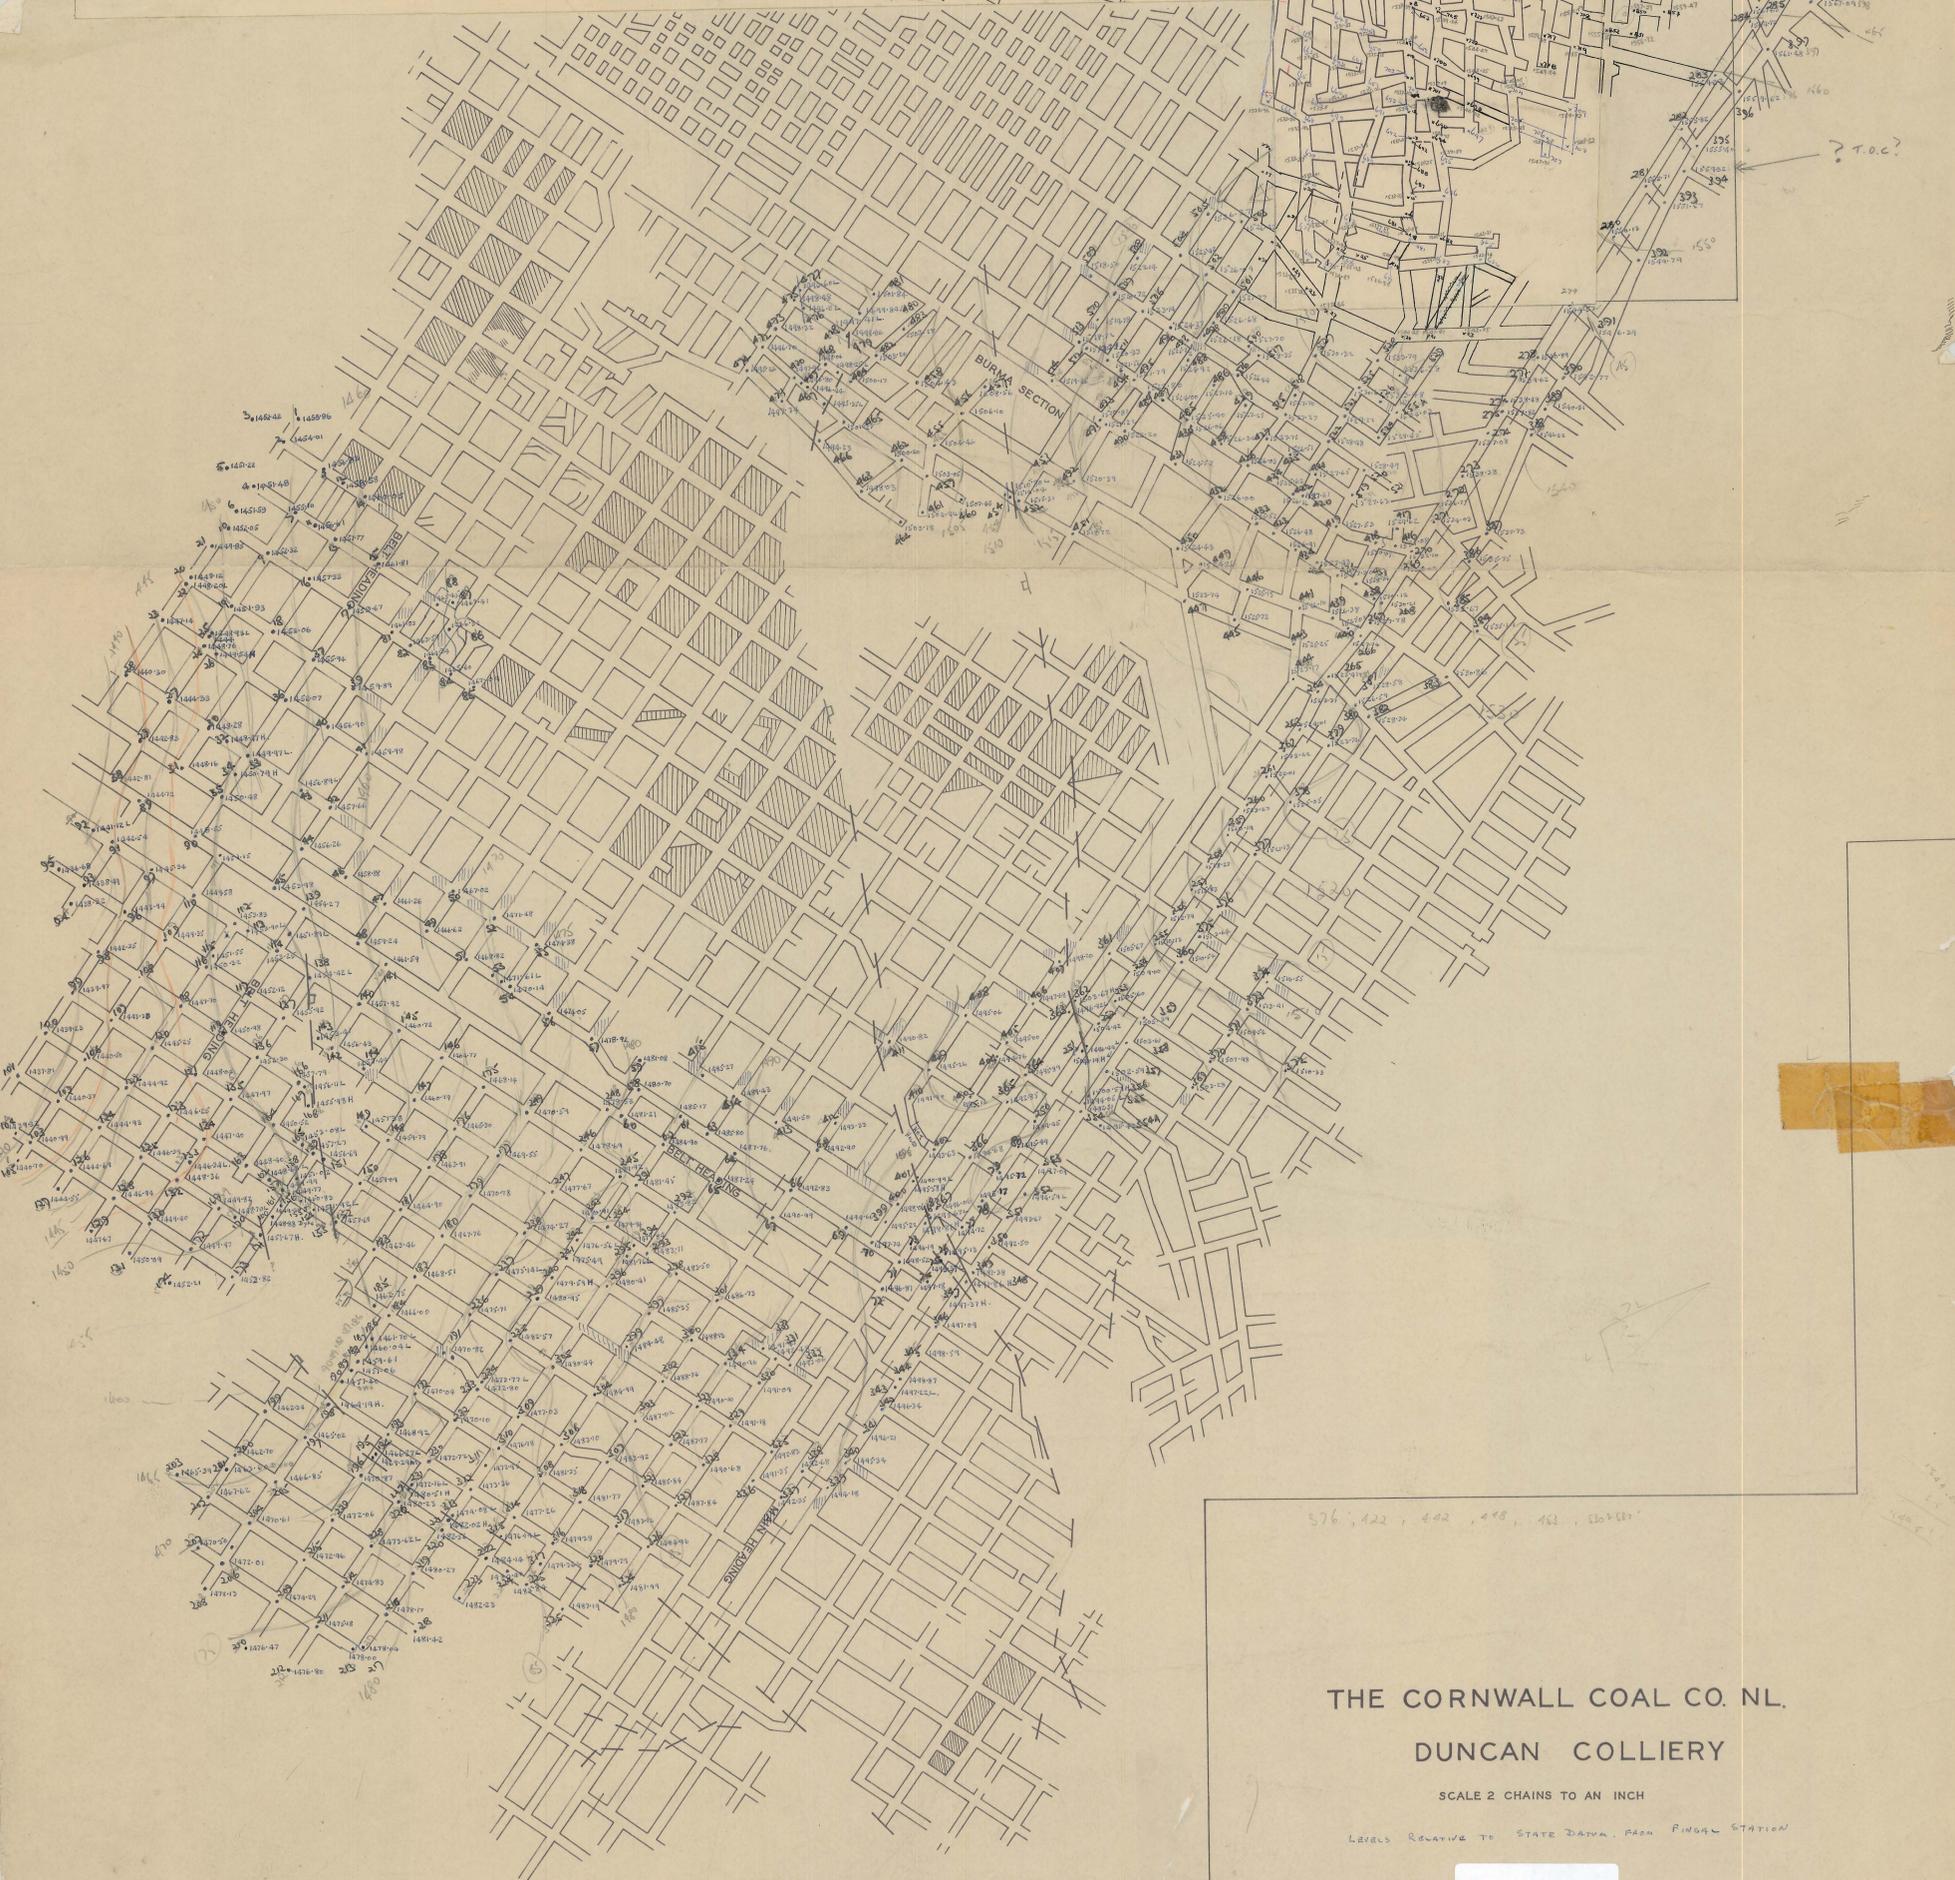

576, 422, 442, 448, 463, 504, 507

THE CORNWALL COAL CO. NL.  
DUNCAN COLLIERY

SCALE 2 CHAINS TO AN INCH

LEVELS RELATIVE TO STATE DATUM FROM FINCH STATION

