


189-01

# CLARENCE G. M. C. LEFROY

Plan of Underground Work  
Scale 25ft to an inch

Scholar's  
Mining Surveyor  
12/2/96

Note - Bearings read to Trigs

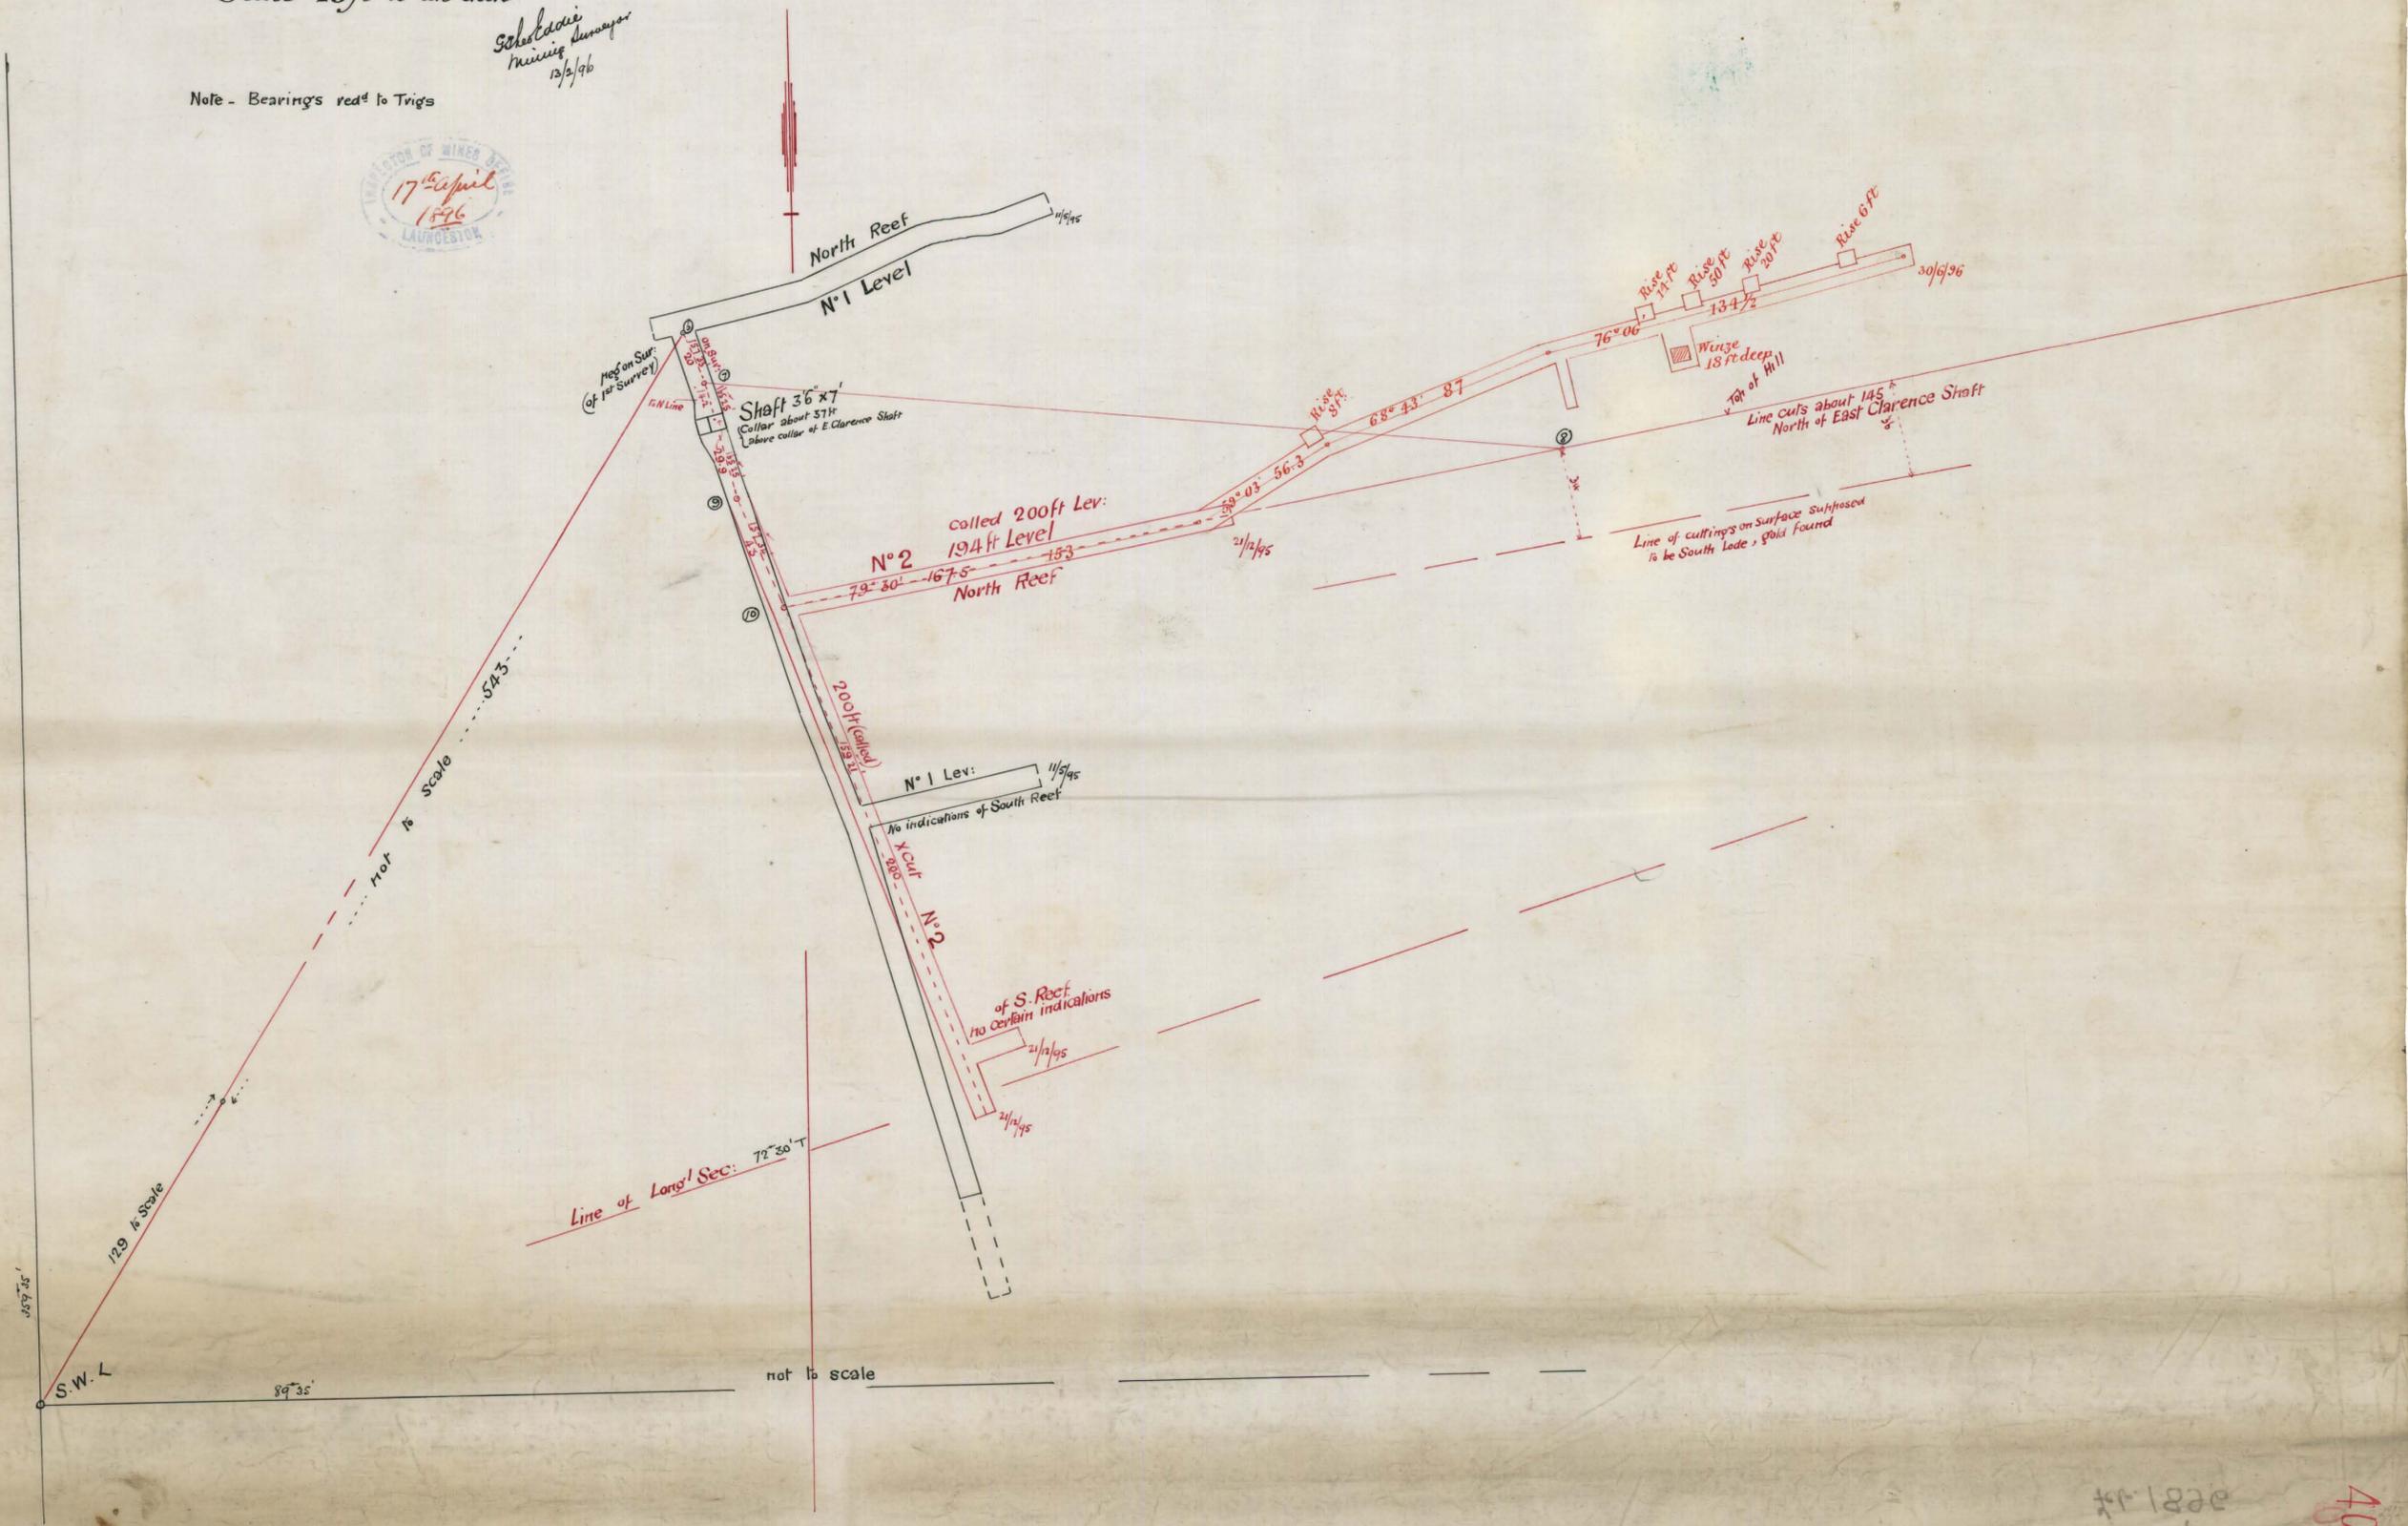

189-01  
G. M. C. Lefroy

40

40

40

40