

189-04

5 cm


189-04

04

Clarence G.M. Co  
Jeffroy

Longitudinal Section

Scale - 25 ft to an inch

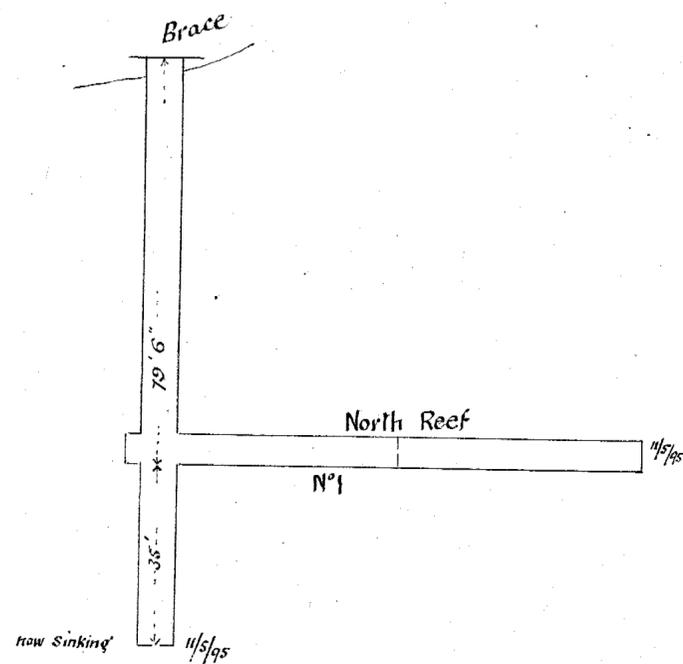

17<sup>th</sup> May  
1895.

Scheffler  
District Engineer  
14/5/95

04