


KING RIVER P. AND G. M. ASSOC.<sup>NS</sup>

PLAN OF WORKINGS  
Scale. 24<sup>th</sup> of inch to 1 foot

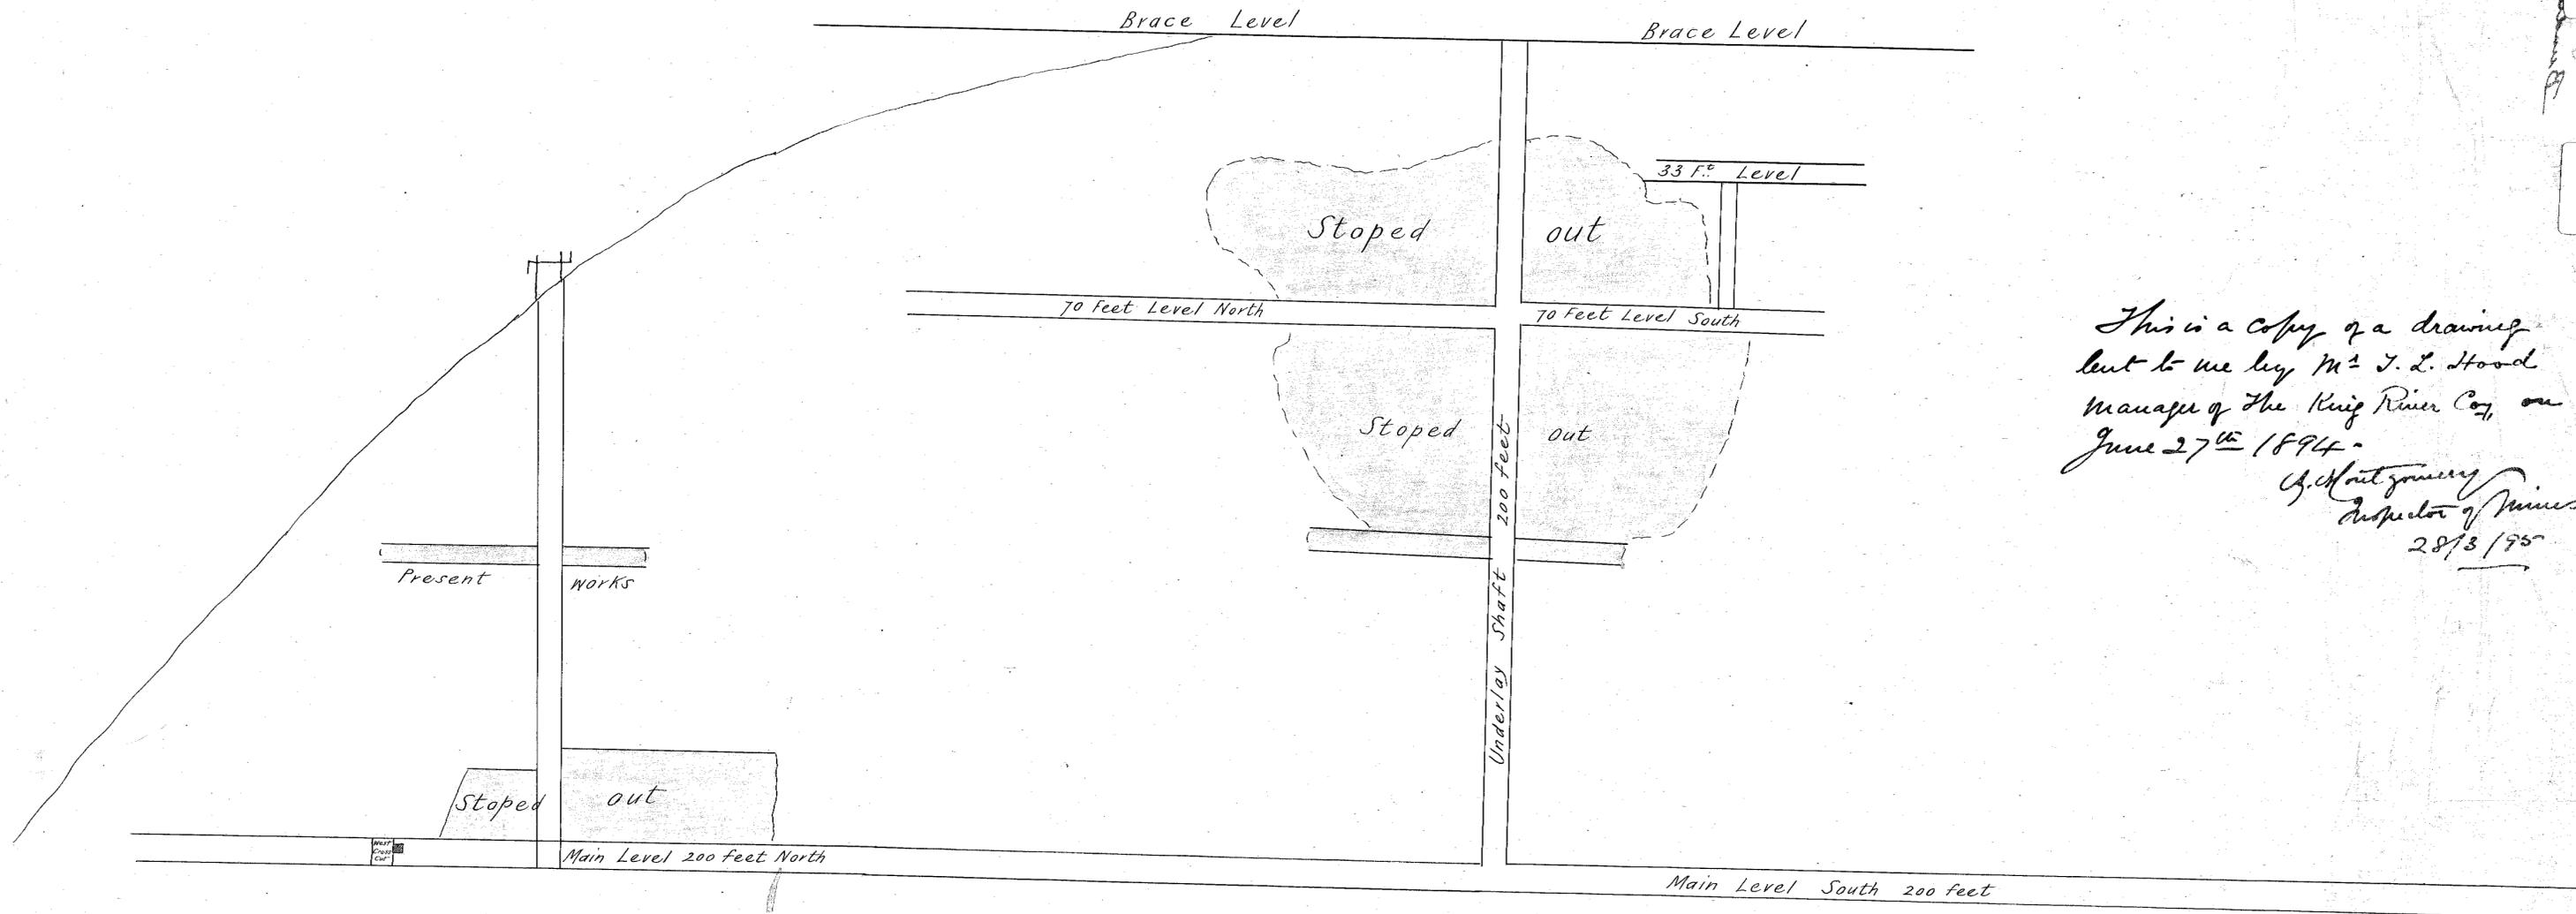

5 cm

191-02

191-02

This is a copy of a drawing  
lent to me by Mr. J. L. Hood  
manager of the King River Co., on  
June 27<sup>th</sup> 1894.

A. Houtzinger  
Inspector of Mines  
28/3/95

191-02