


192-01

# PLAN OF THE NEW ELDORADO G. M. C<sup>o</sup>

Scale. 30 feet to an inch of plan

### REFERENCES

- Rise from tunnel peg on crown of hill 138 ft
- Fall from peg on hill to shaft 45 ft 6 in
- Depth of No 1 level below tunnel 27 ft 6 in
- Depth of main shaft 6 ft 11 in level 162
- Depth of No 1 level below tunnel

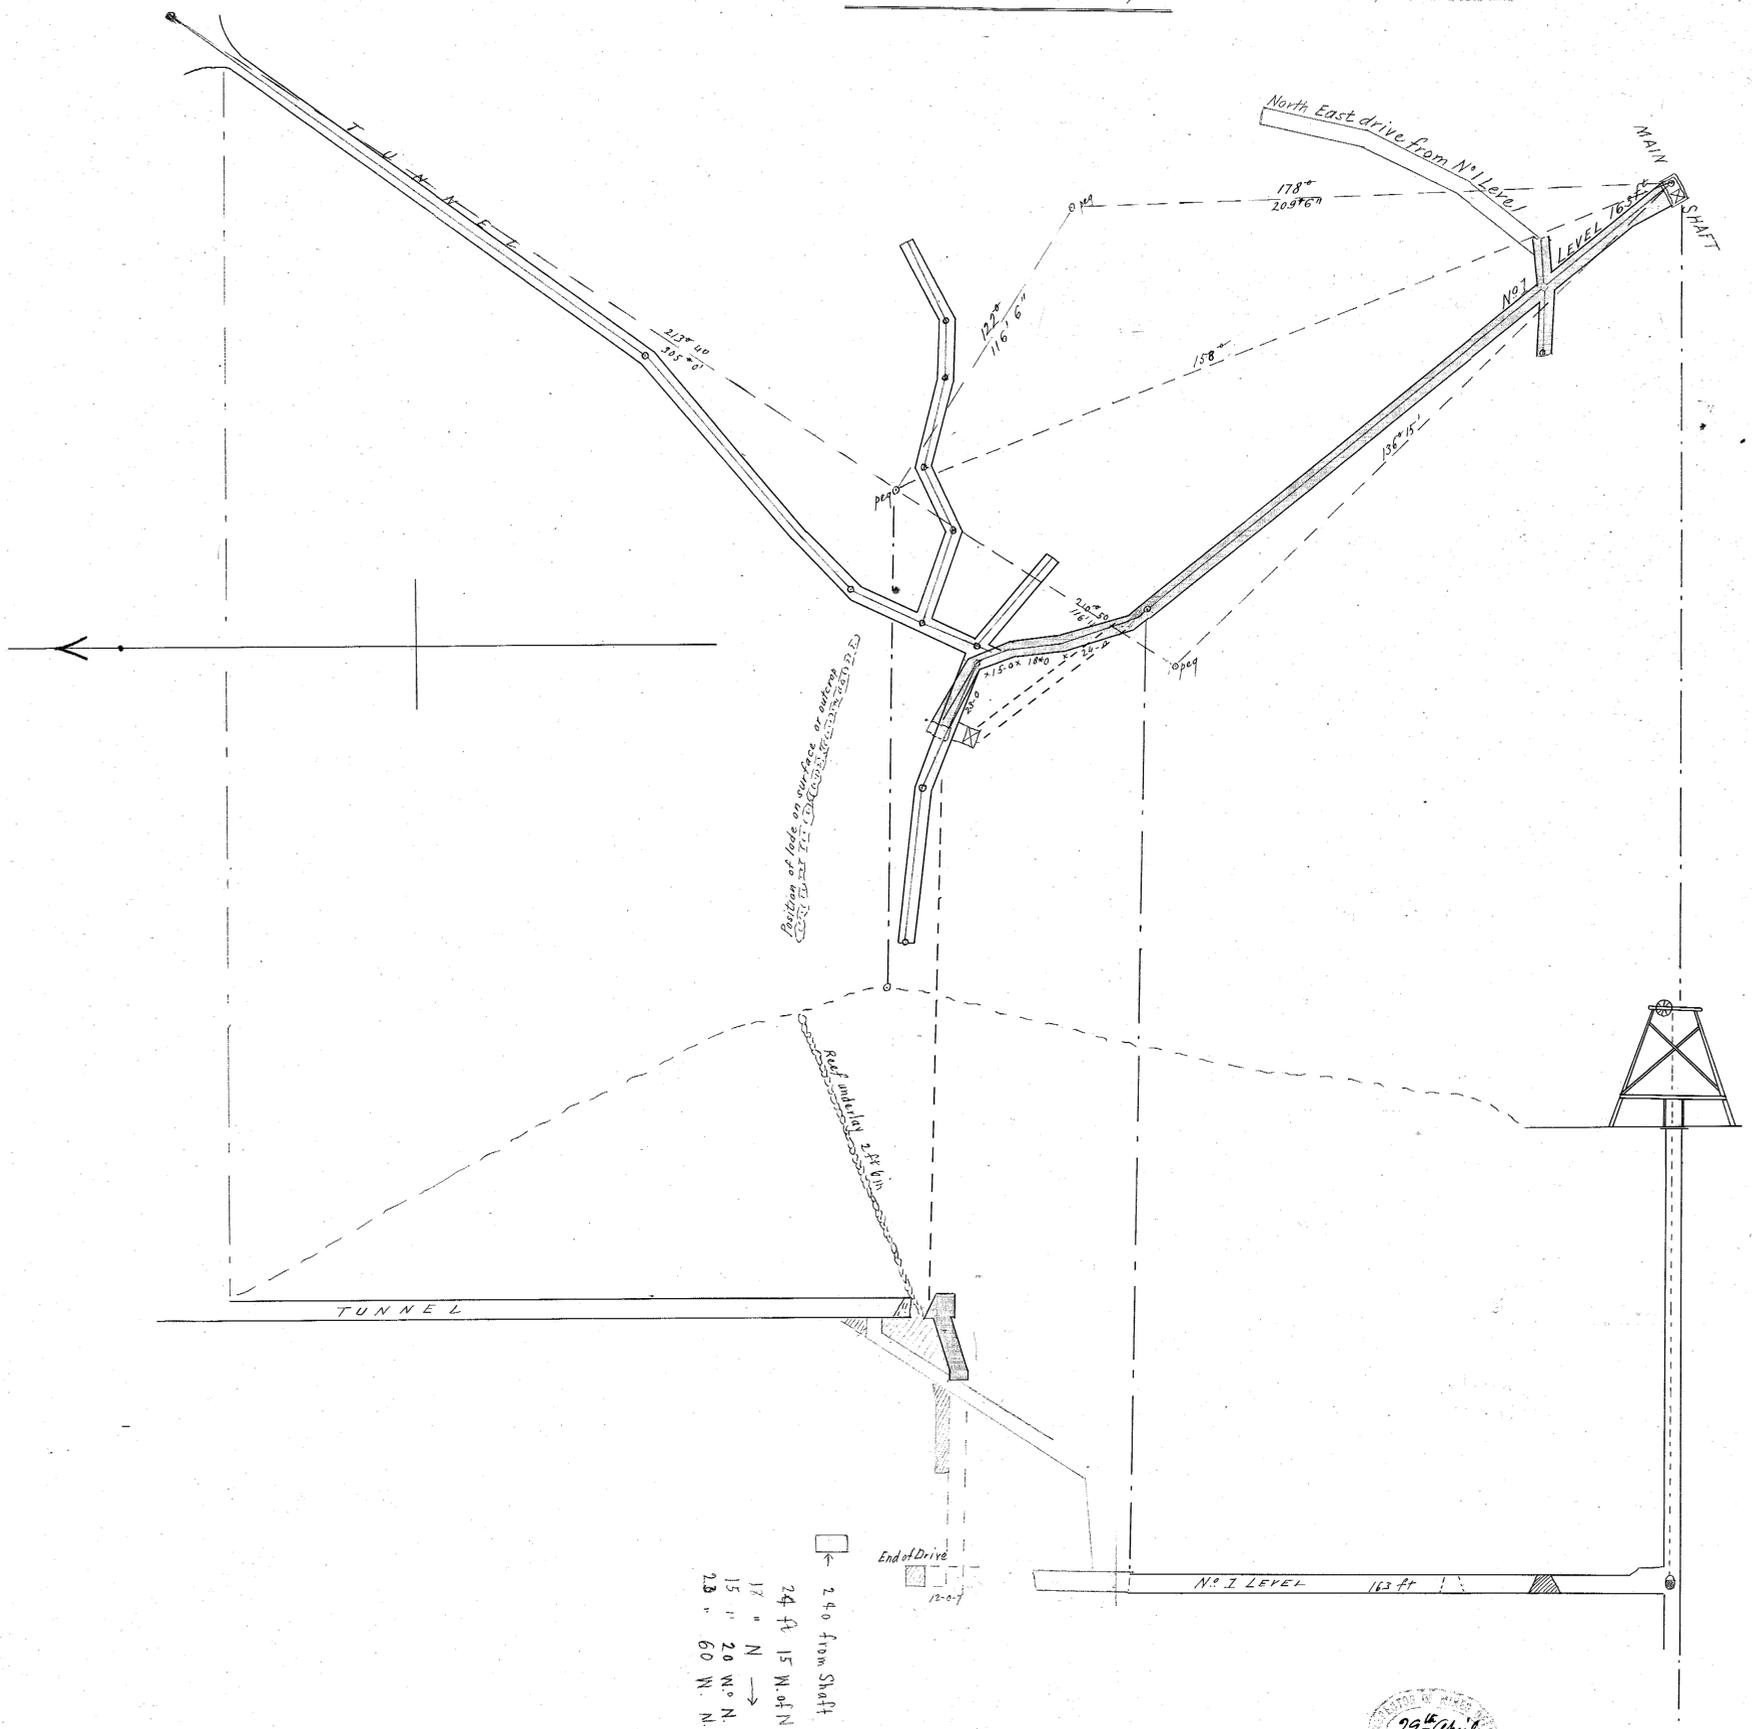

□ 240 ft from Shaft  
 17 " N →  
 15 " 20 W° N  
 28 " 60 W. N.

29<sup>th</sup> April  
 1895  
 INSPECTOR

This is a copy made in the Mines Office, Lancaster  
 by Mr J. Parard of a plan said to be made by a Mr Bell  
 sent to me 29<sup>th</sup> April 1895 - by Mr Henry, then  
 Manager of the New Eldorado Company and returned to  
 him the same day - J. Mountgomery  
 Inspector of Mines  
 29<sup>th</sup> April 1895