


Adjutant G. M. Co. NO. 11A

Gross Section

Lefroy


Longitudinal Section

Scale 25 feet to an inch

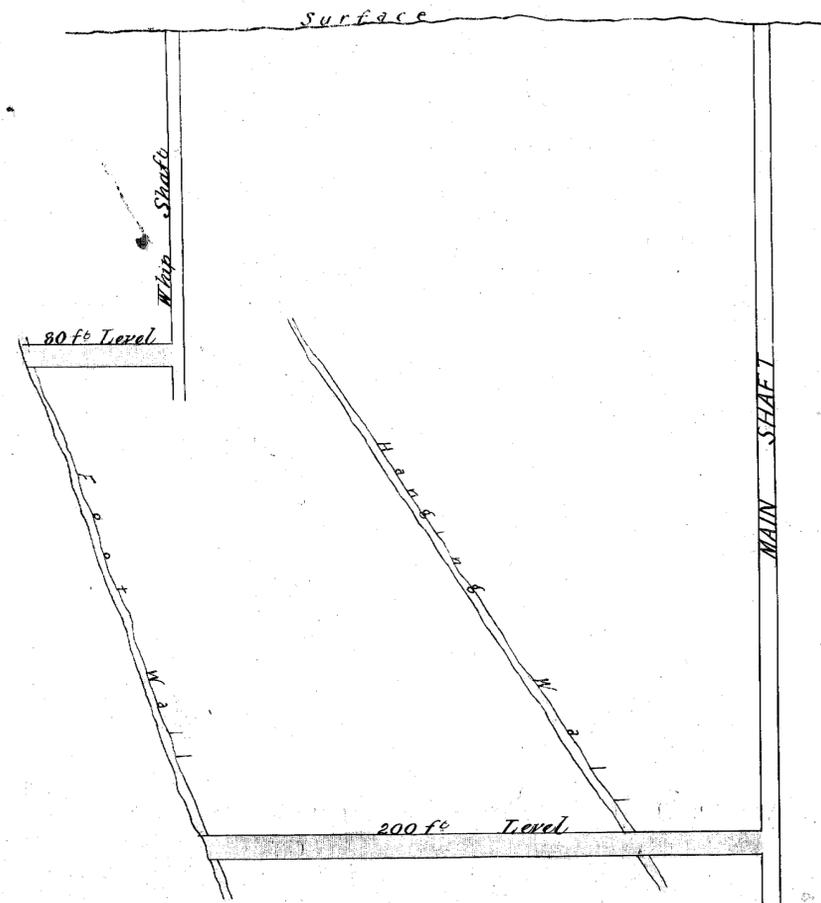

References

-  Prospecting Workings 80 ft.
-  200 ft Level

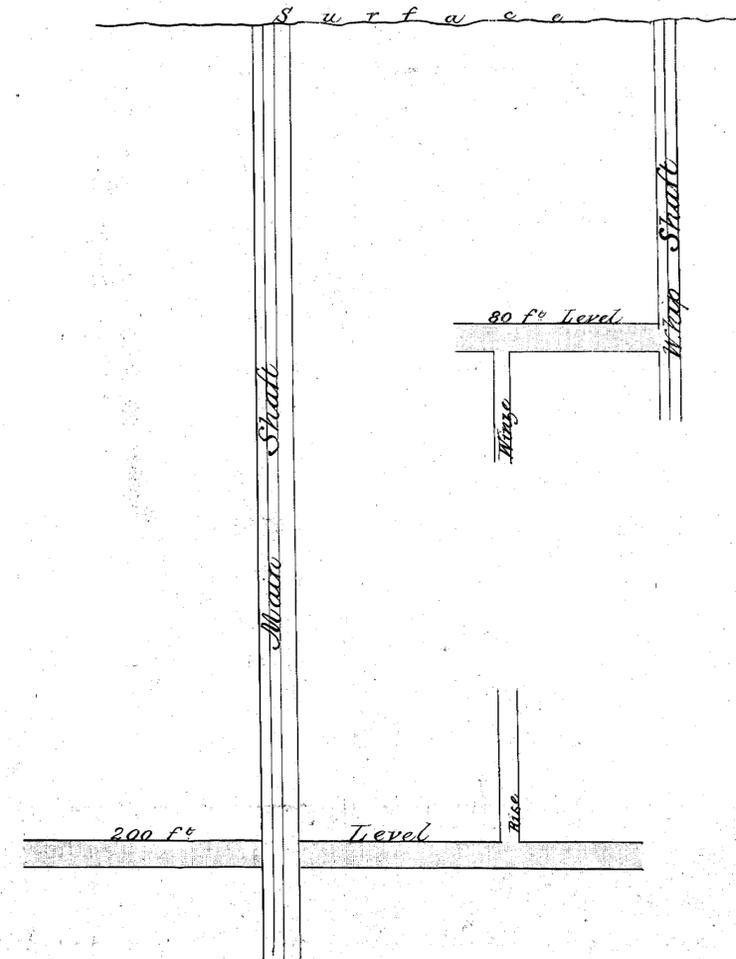


193-01

5 cm


N Boundary

193-01

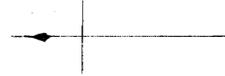

E Boundary

A. J. Miles
Surveyor
March '96
Lefroy

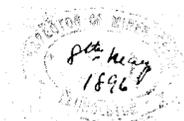

A. J. Miles
Surveyor
March '96
Lefroy