

193-02


Adjutant G. M. C. No Liability

Lefroy

Scale 25 feet to an inch

References

-  Prospecting Workings 30 ft.
-  200 ft Level

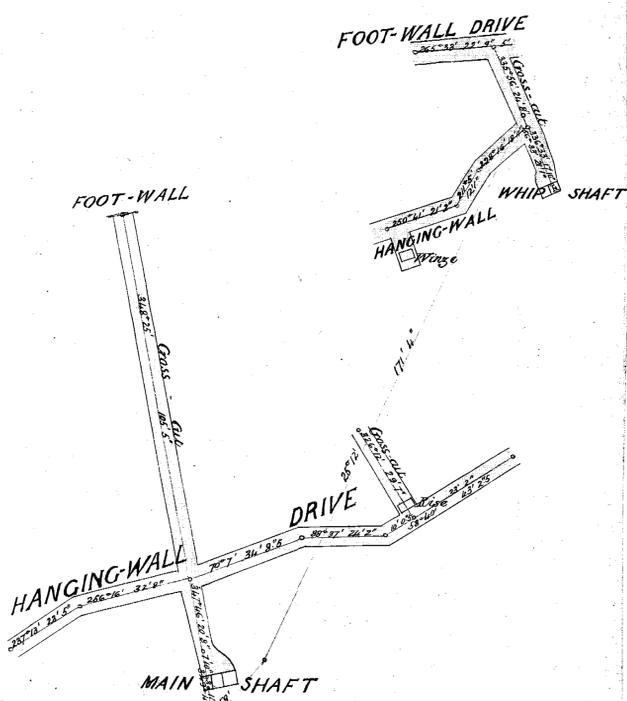

Vertical text label on the left side of the plan.

805 May 1896

Vertical text on the bottom left margin.

St. J. ...
March 1896.

Bottom right text.

Bottom right text.