


TRACING showing in Blue, New Workings Campbell's Reward added to Original Plan

Alfred Malins
Supt. Dist. Survey
9/2/91

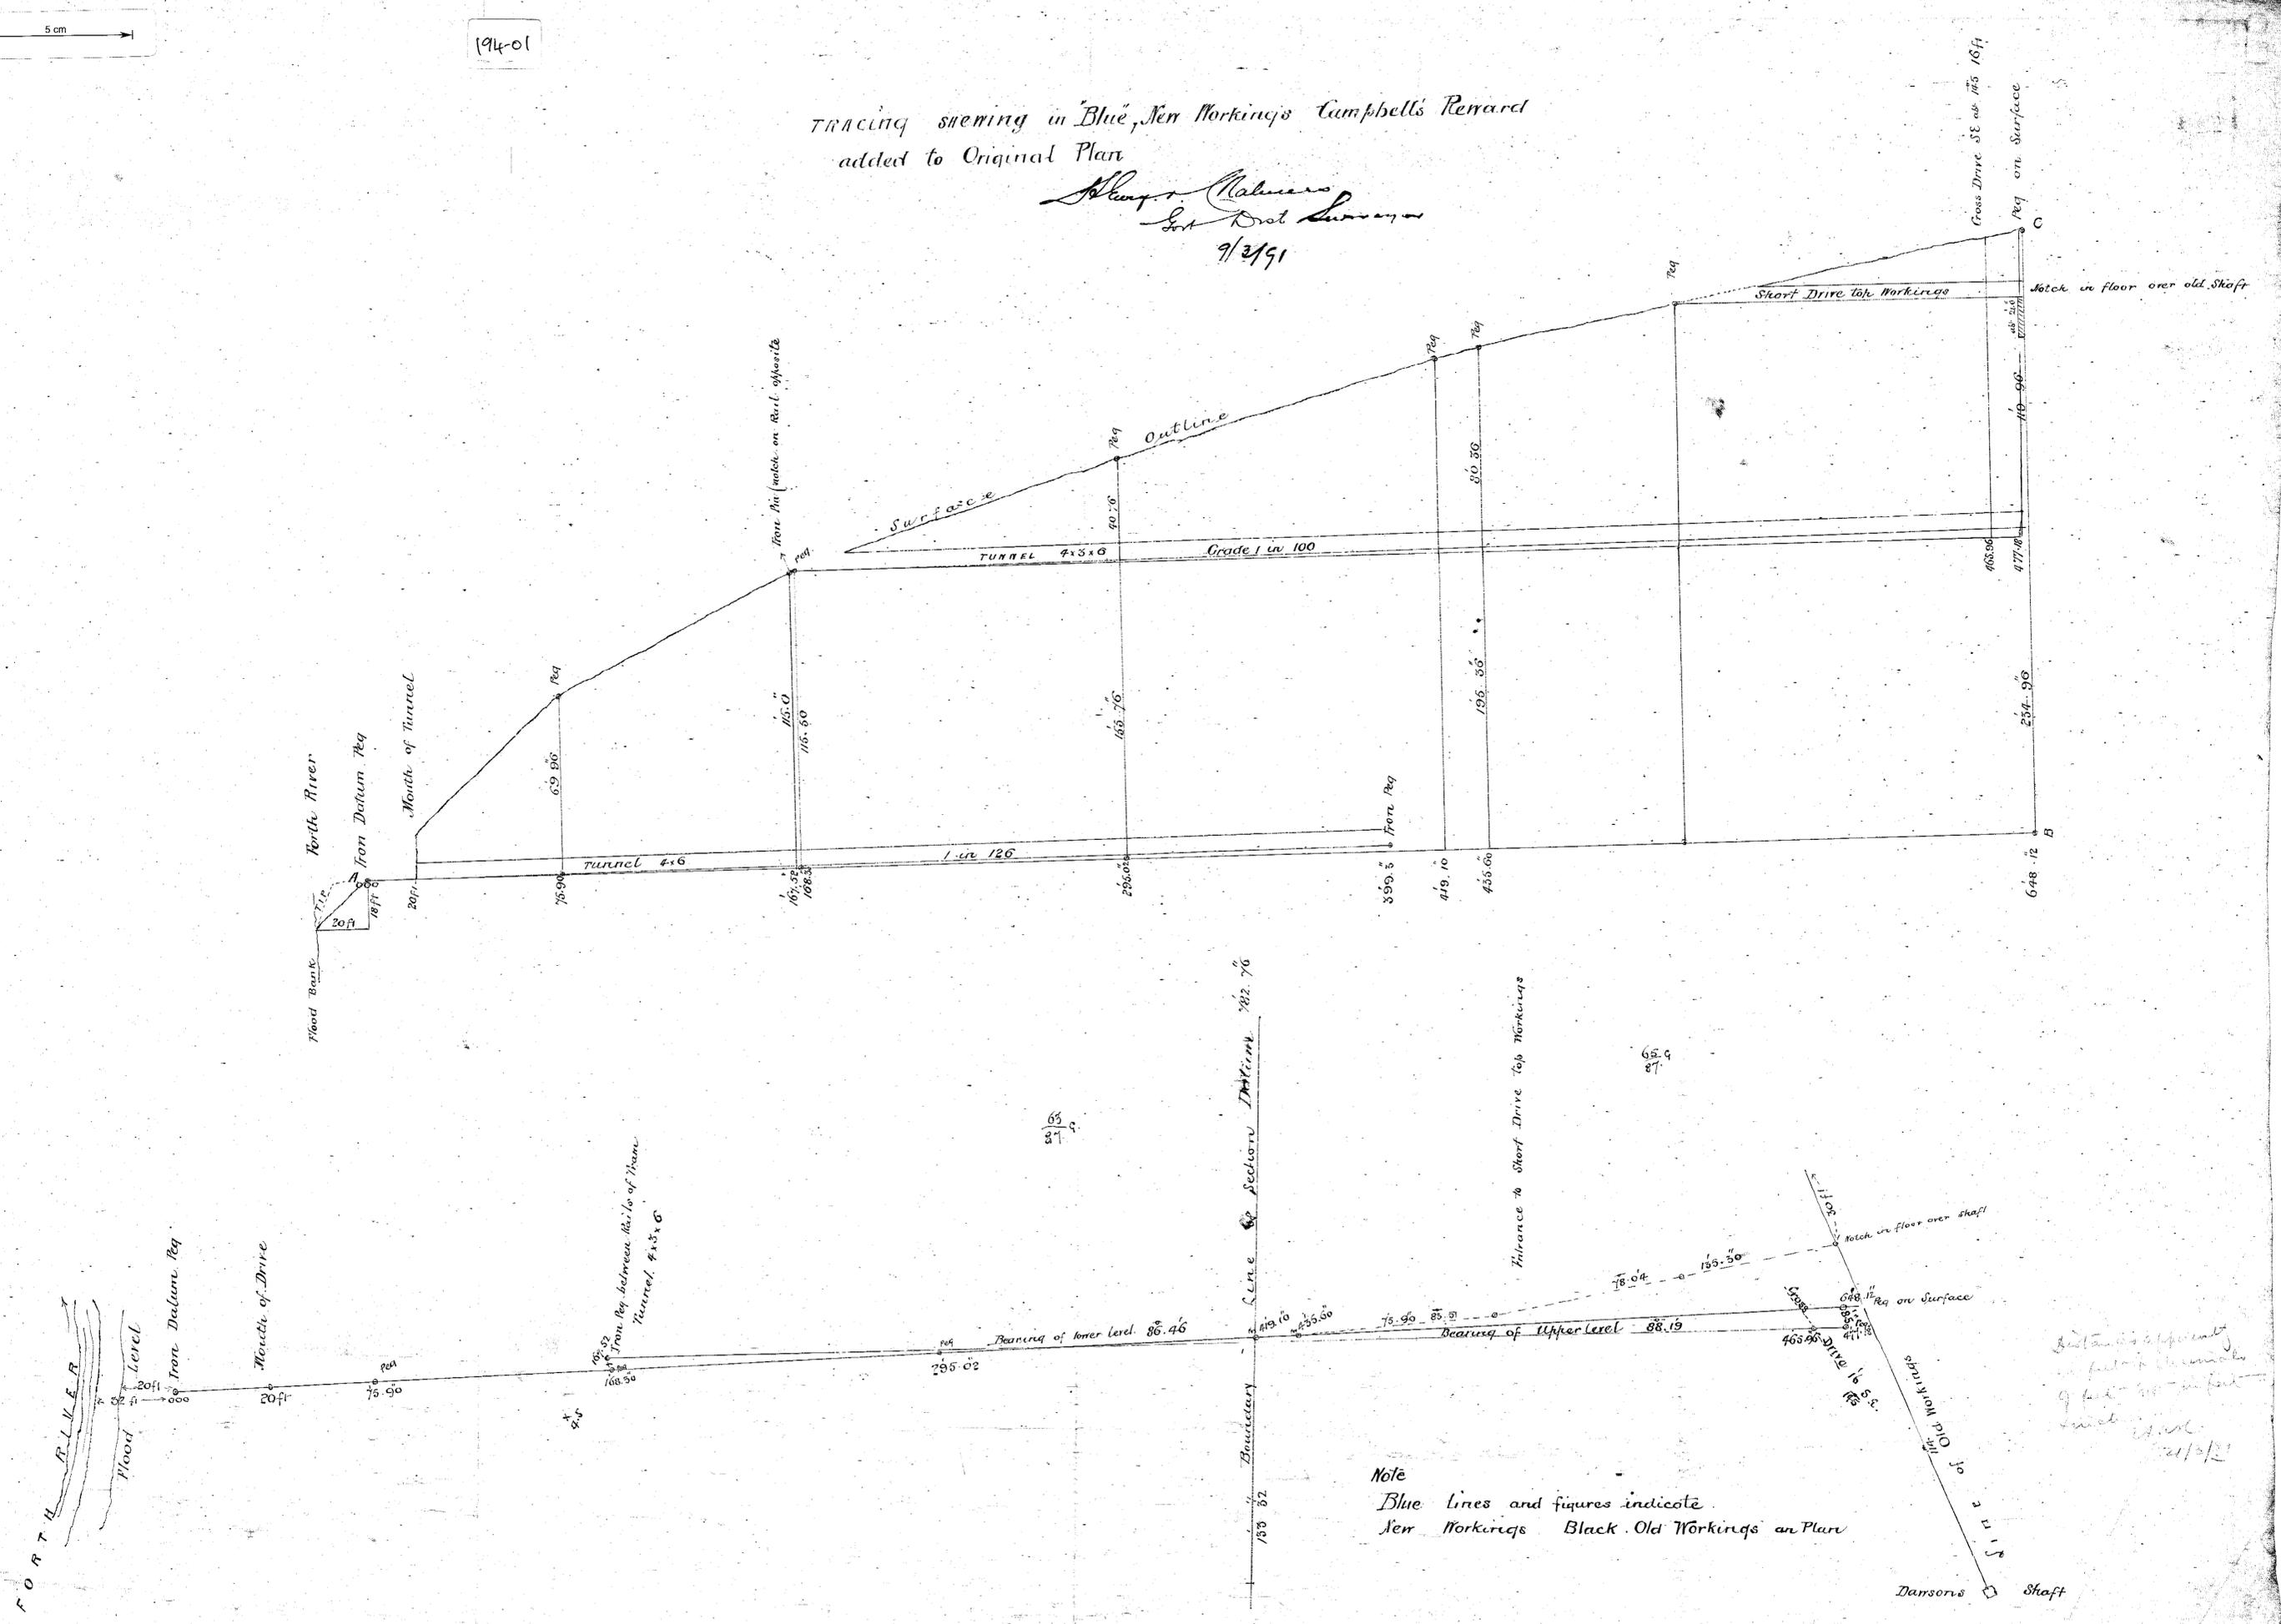

Note
Blue Lines and figures indicate
New Workings Black Old Workings on Plan

Distances apparently
correct in
9 feet 10 inches
small
21/12