

1914-02



1914-02

SECTION

Campbell's Reward Tunnel, River North

Scale 30 feet to an Inch

Cross Section at D

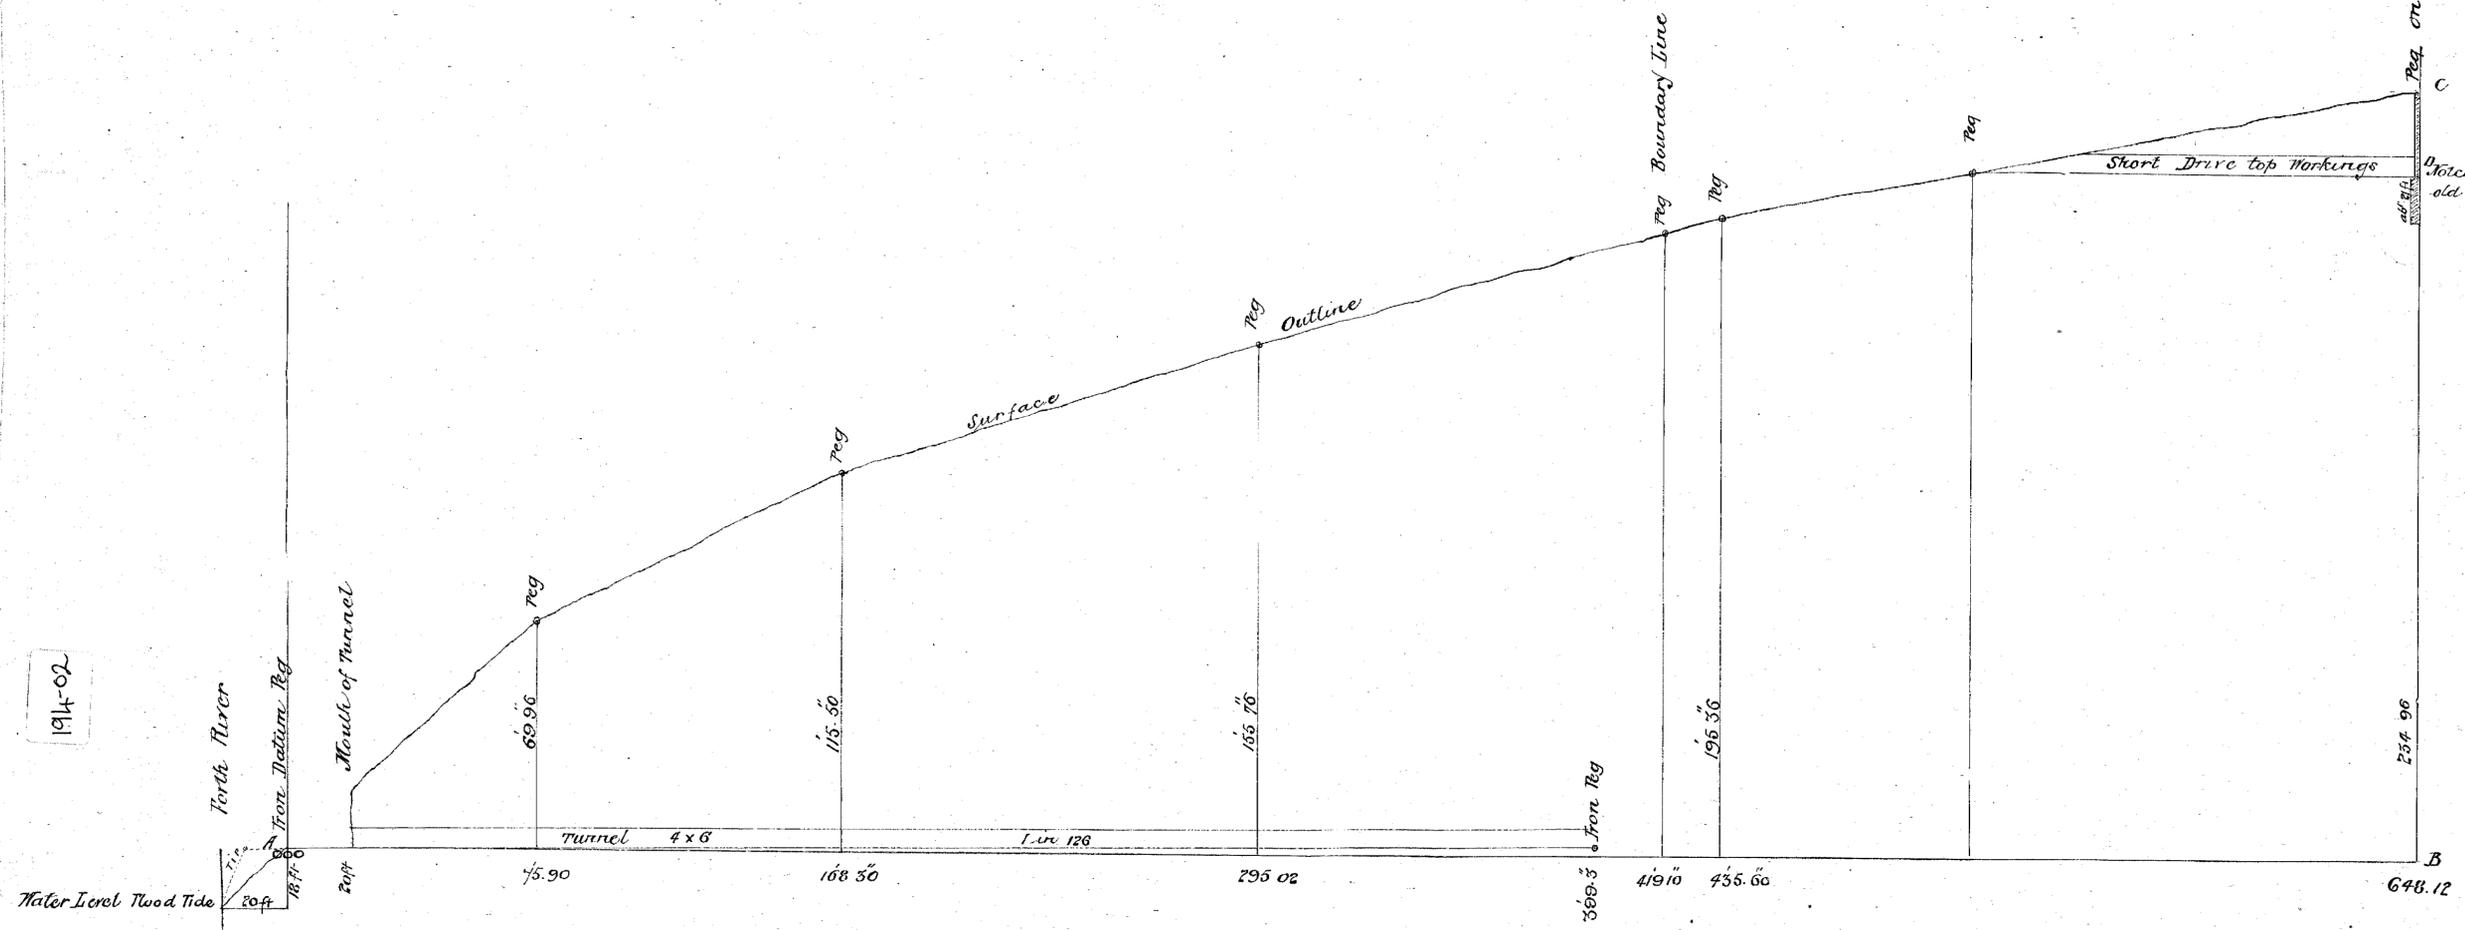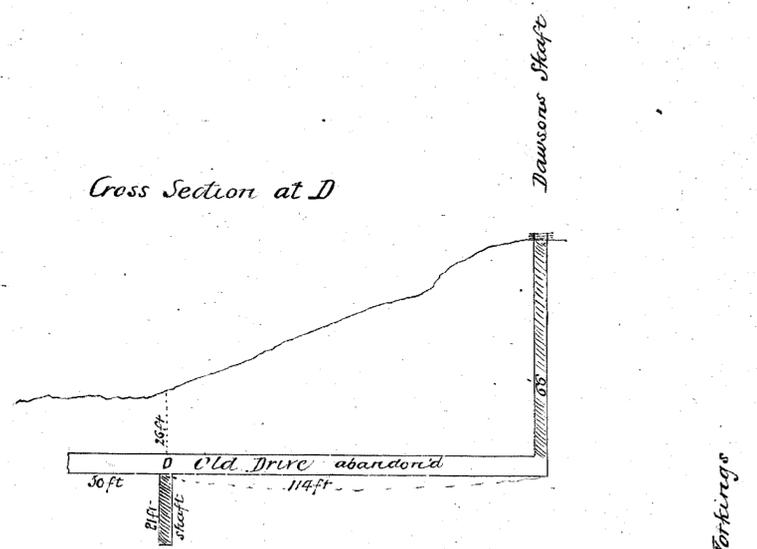

Certify this tracing as a true copy of original plan
Alvyn Chalmers
Mining Surveyor
 4th Febry 1890