


DIAGRAM
 of
 LEASES KNOWN AS CAMPBELL'S REWARD
 RIVER FORTH
 SCALE 30 FT TO AN INCH


N
 65 G
 87
 GEO PADMAN LESSEE

65 G
 87
 T. GLOVER LESSEE

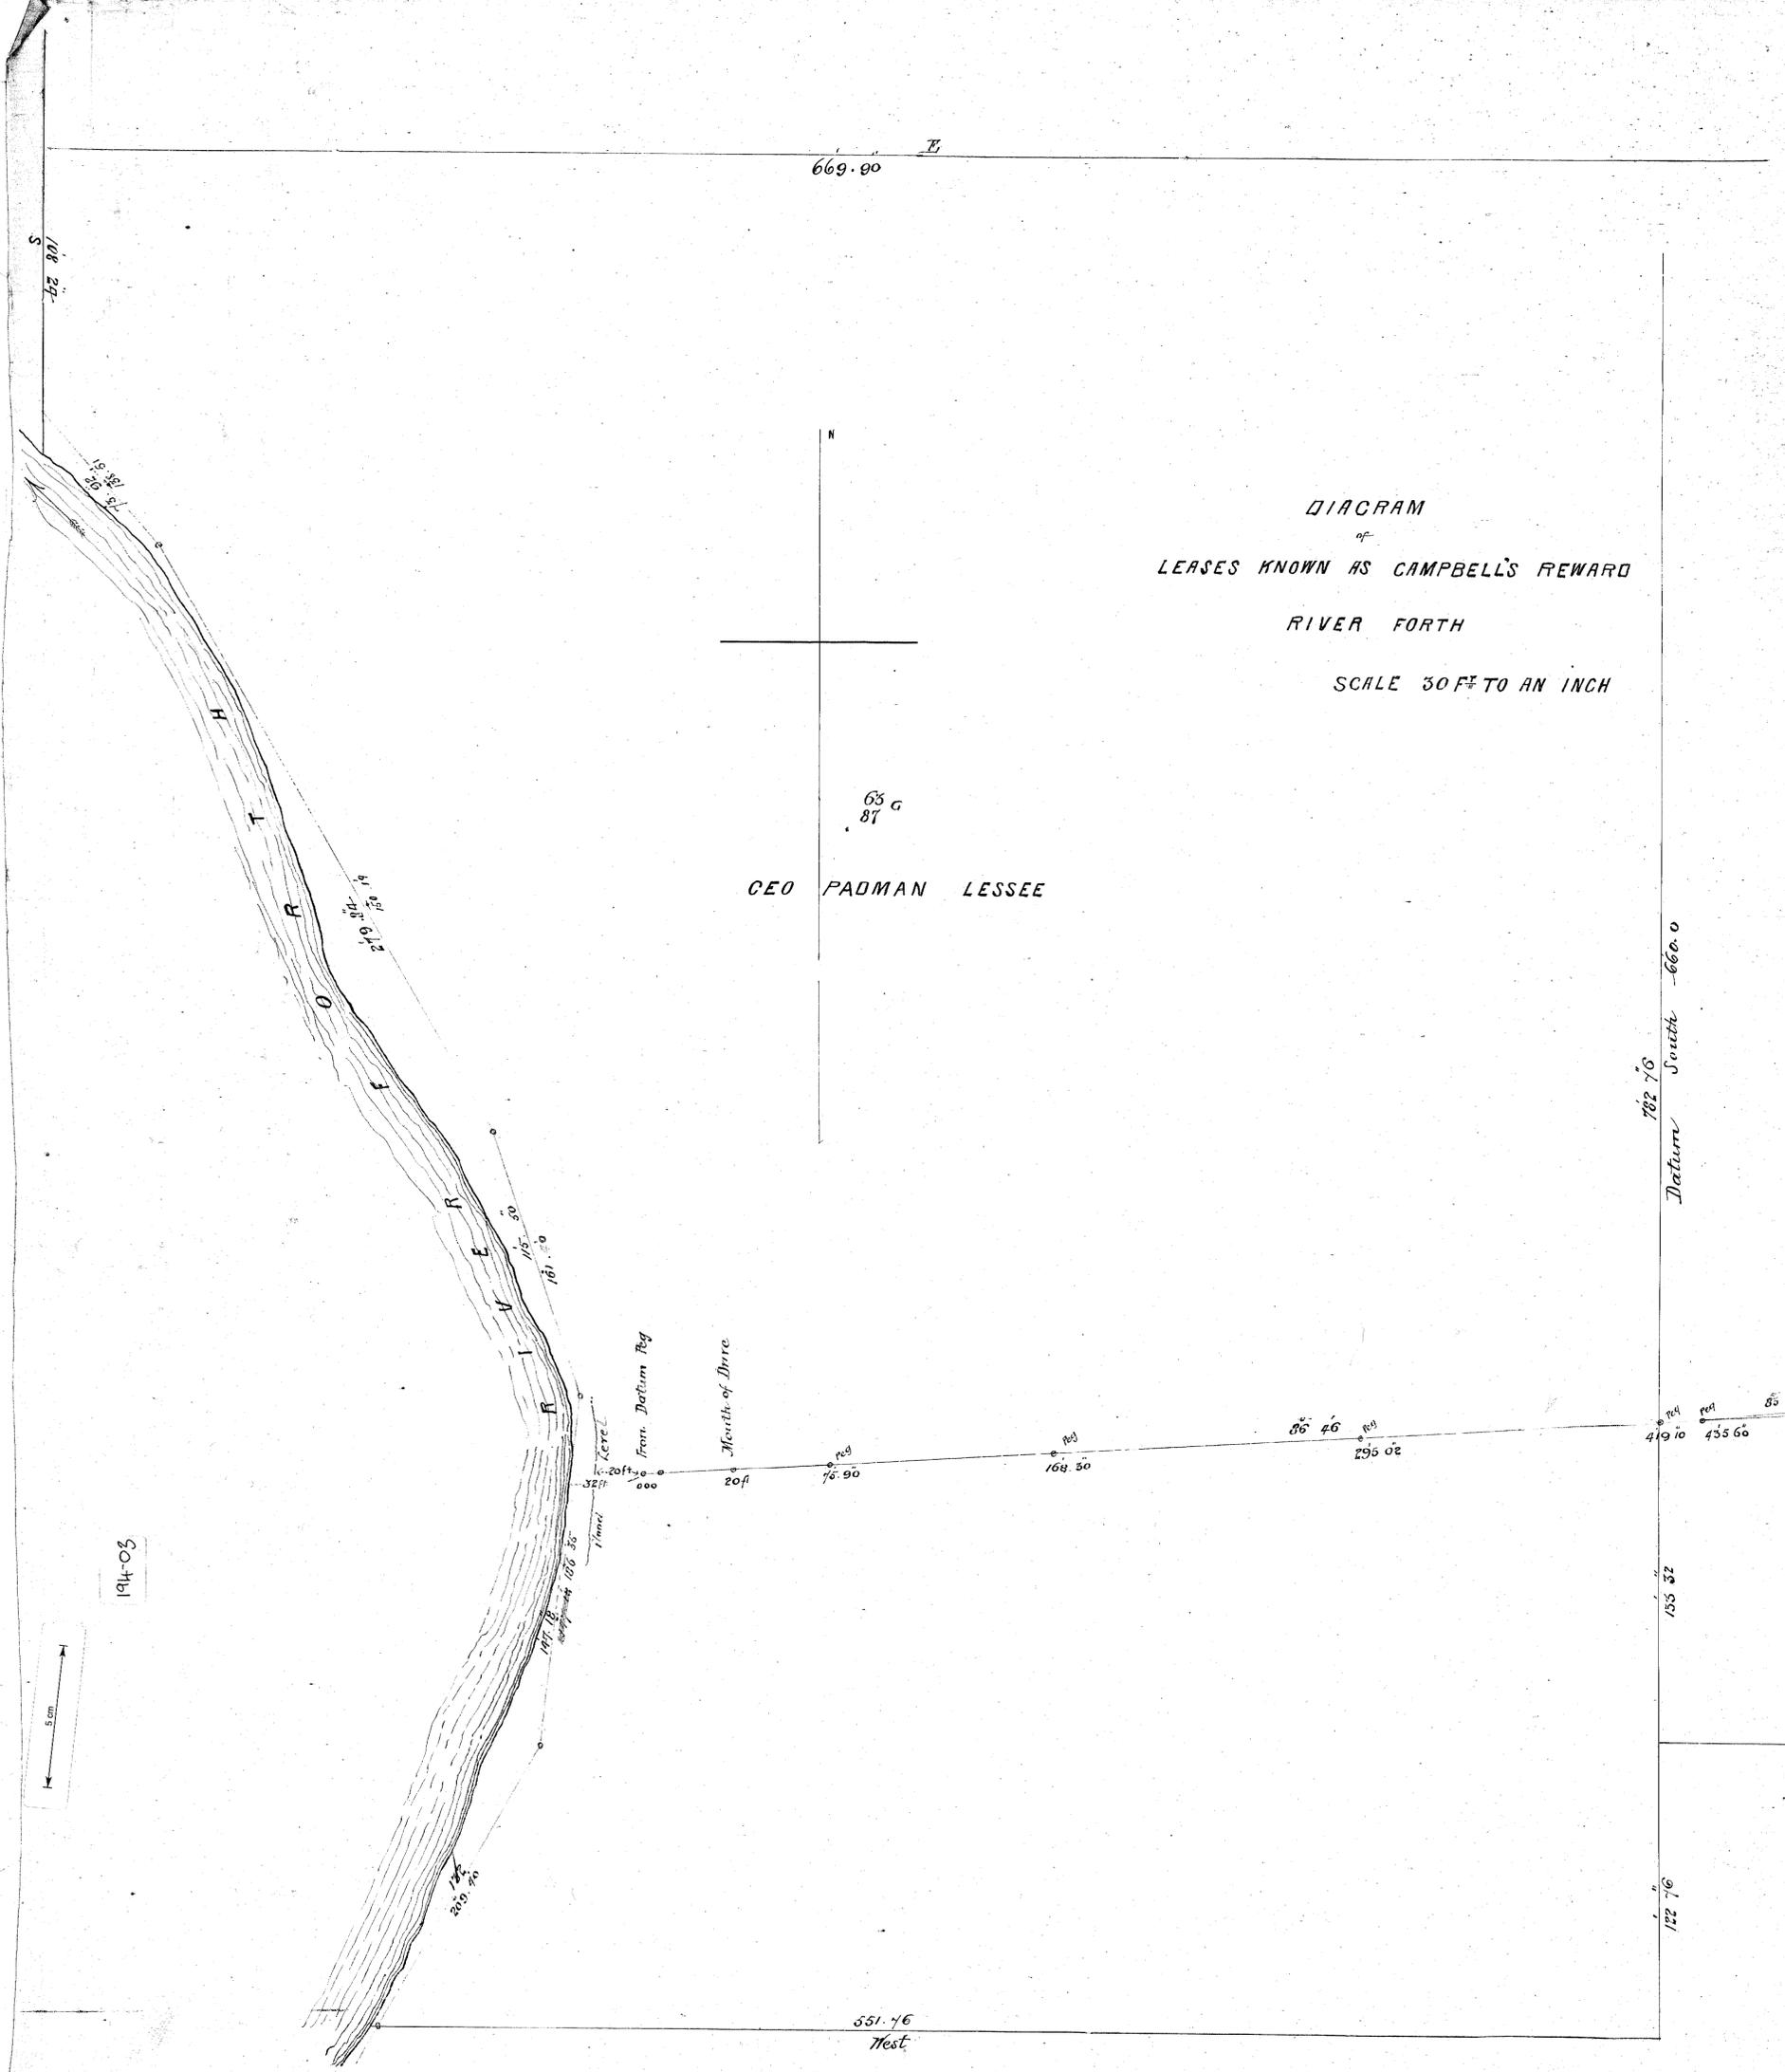


782 76
 Datum South - 660.0

Entrance to Shaft Drive - top markings abundant

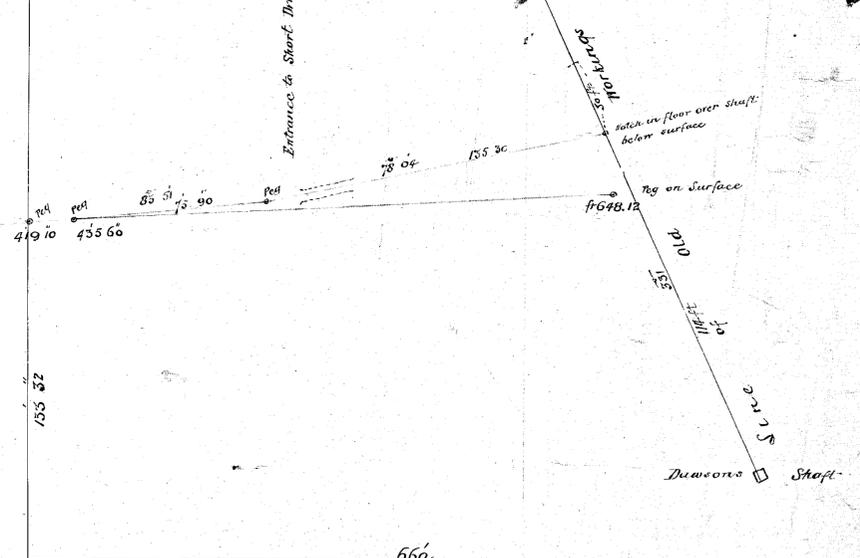

30-4191

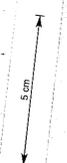

660. East

551.76 West

D Campbell Lessee
 Certify that this tracing is a
 true copy of original plan -
 Henry S. Chalmers
 Mining Surveyor
 H. S. Chalmers 1890

Campbell Lessee

10